


2667
No 14

MIDSHIP SECTION

R. Napier & Co
Glasgow 1870
Nov 2/6

Scale $\frac{1}{2}$ " = 1 foot

Length from after part of Stem to front of Sternpost 318.0
Breadth moulded 37.6
Depth from top of keel to top of main Beams 24.28
D^o of U^o 31.8
Girth from Centre line of keel to 1st stringer 13.5
D^o 36.5

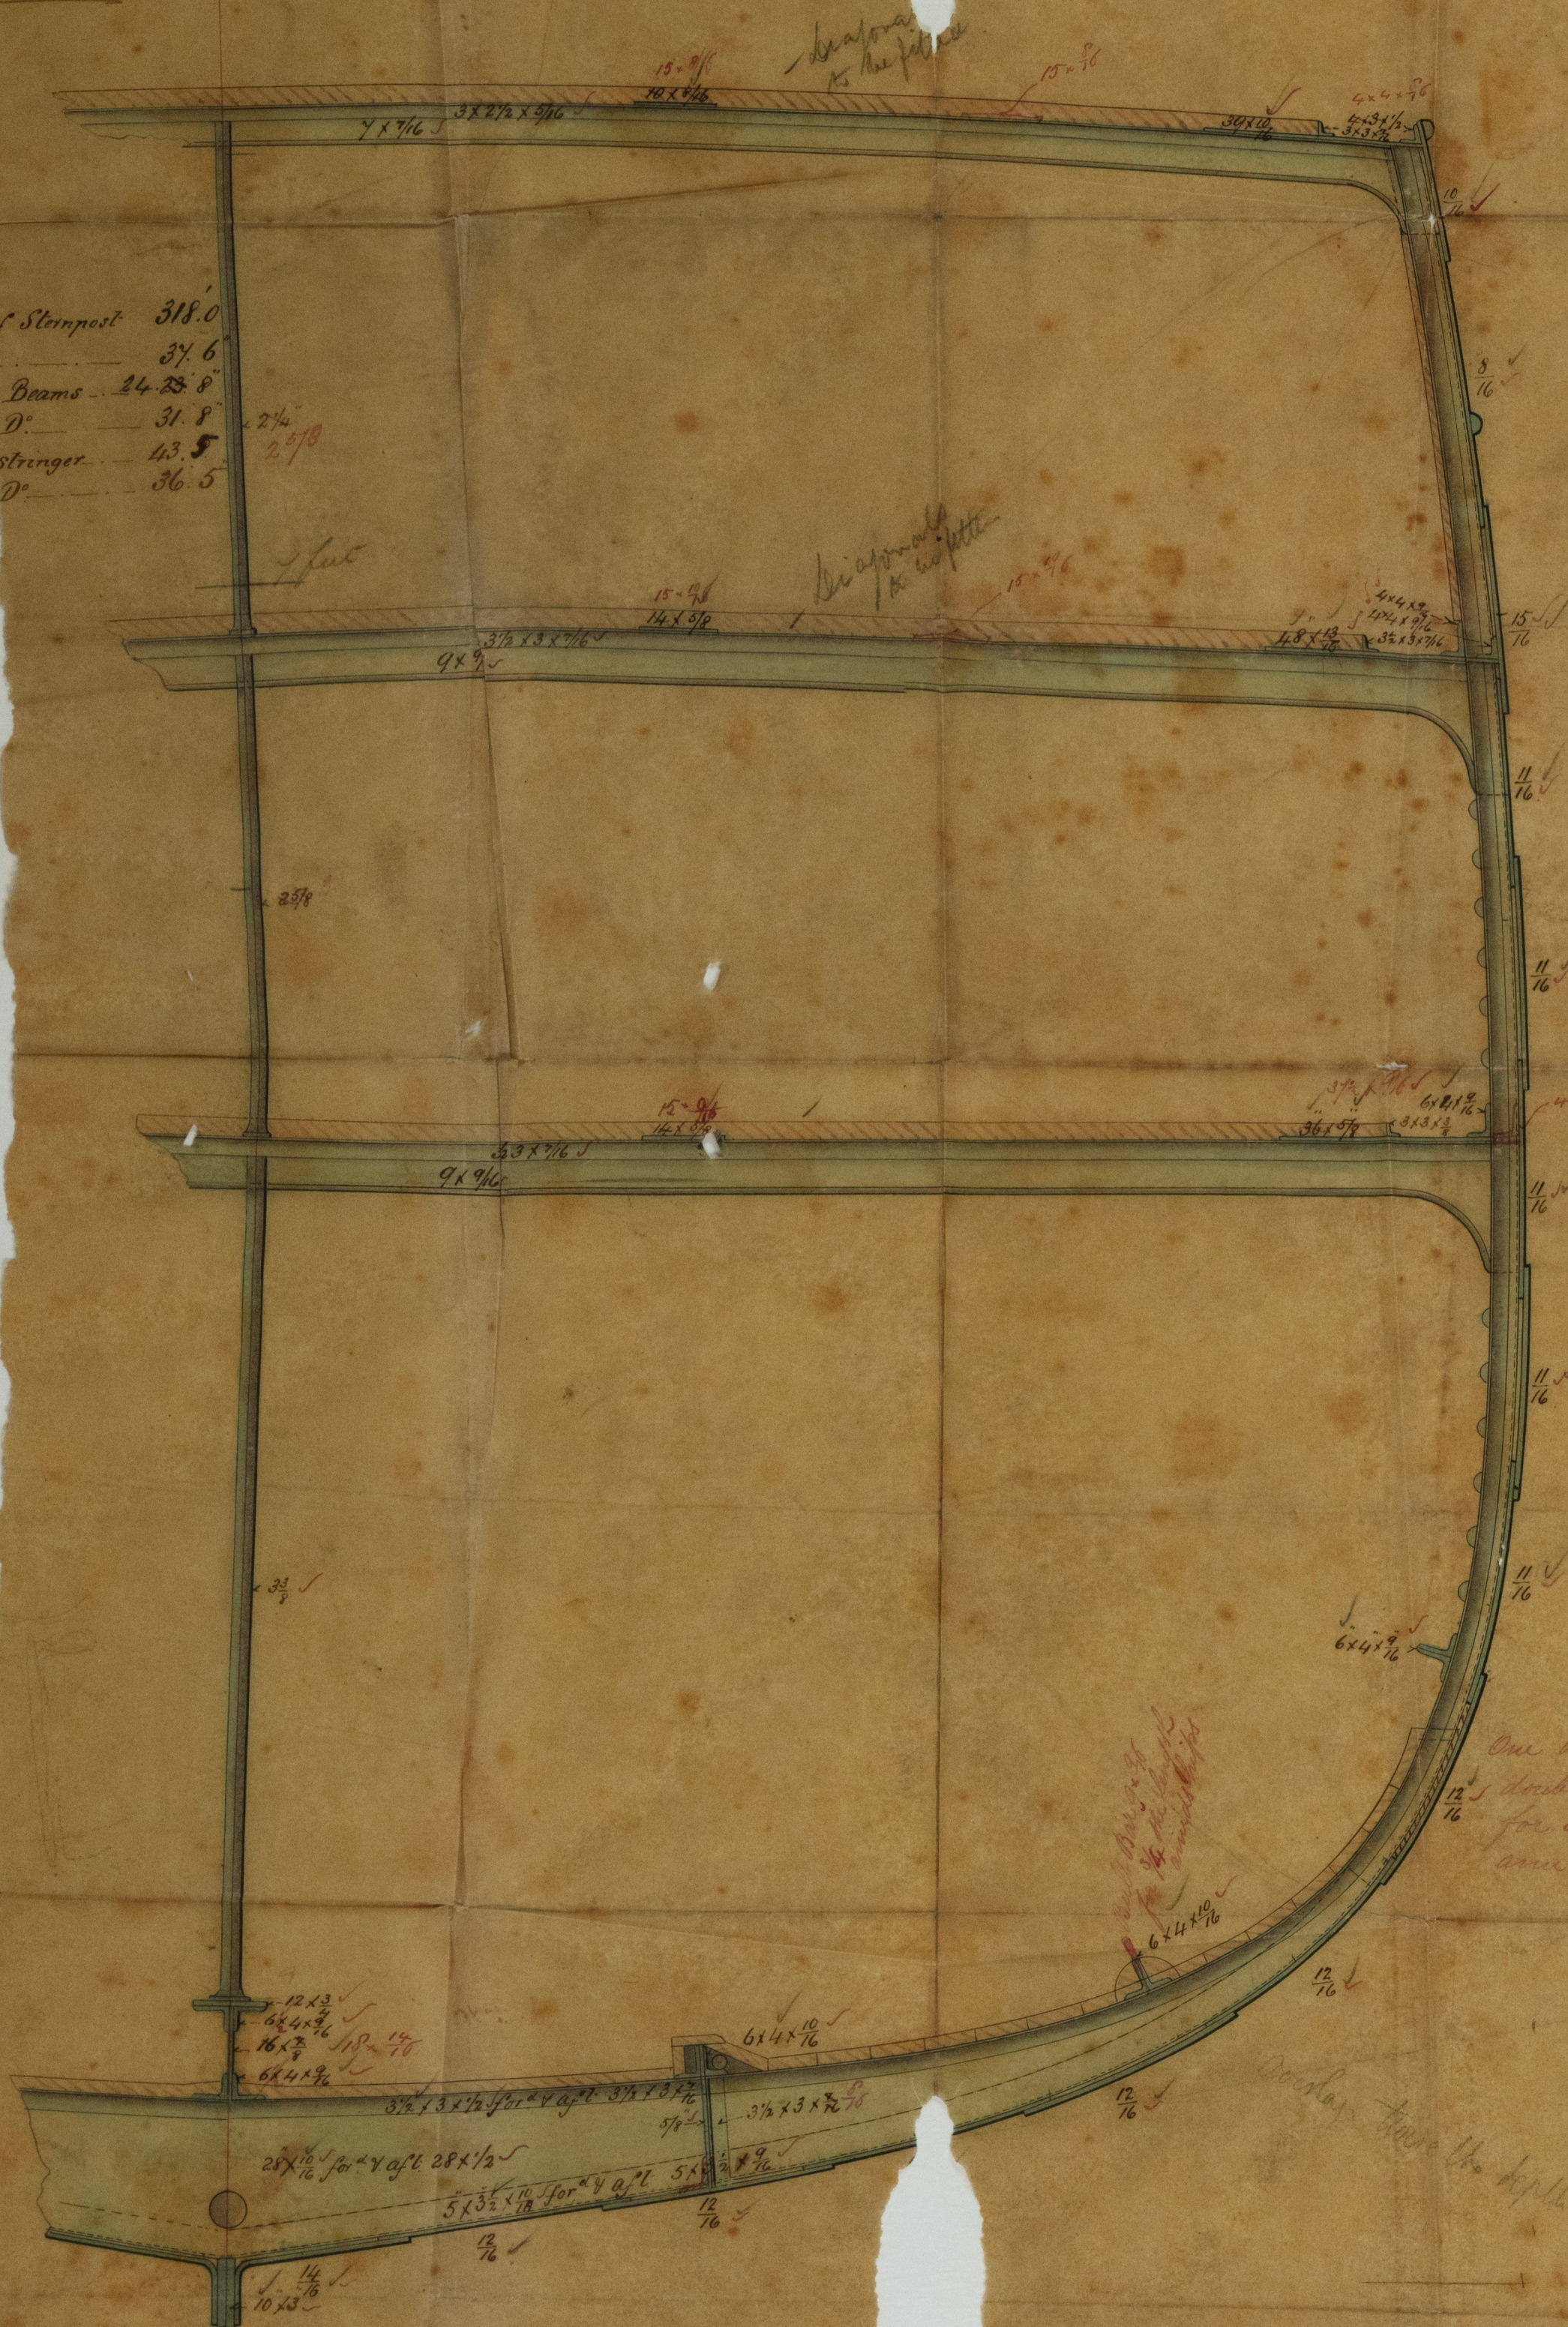

One Ripe Strake to be
doubled with 1/2" plate
for one half the length
amidships.

Overlaid transverse keel plate



© 2021

Lloyd's Register
Foundation