


Iron Ship built by Messrs. Lawrie in 1868
 Price 31/11/90 £

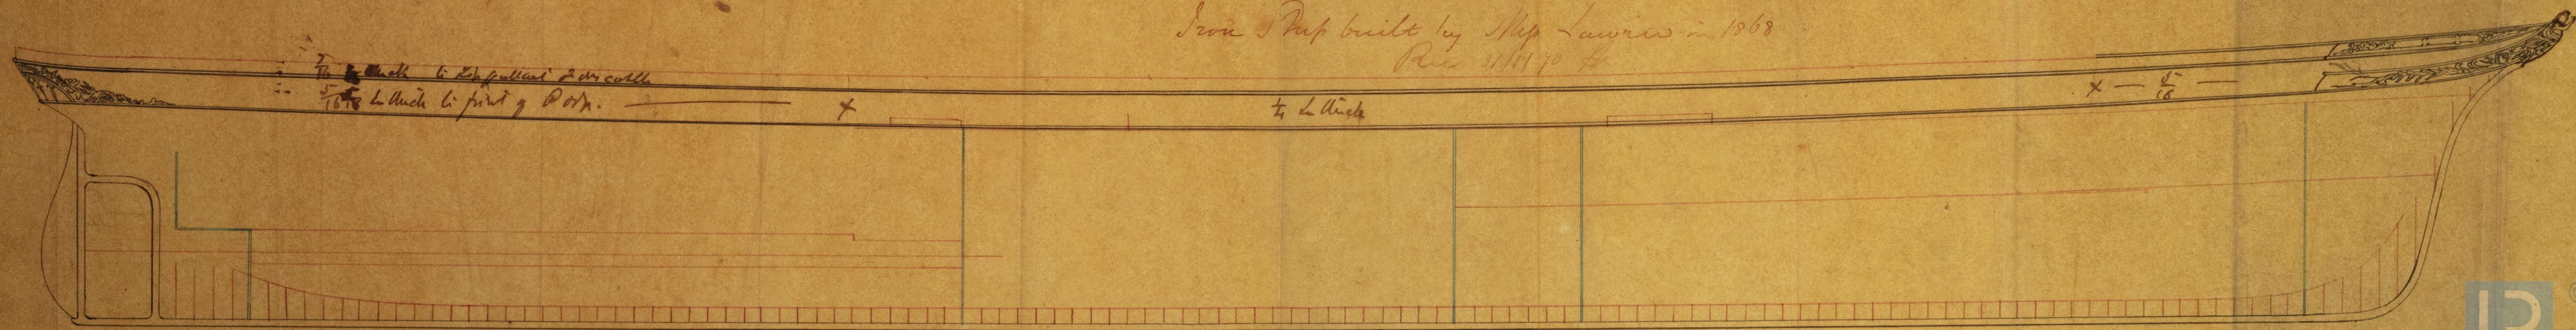

IRON 503-0001



© 2021
 Lloyd's Register
 Foundation