


8336 IRON

Rev 5791 30

46

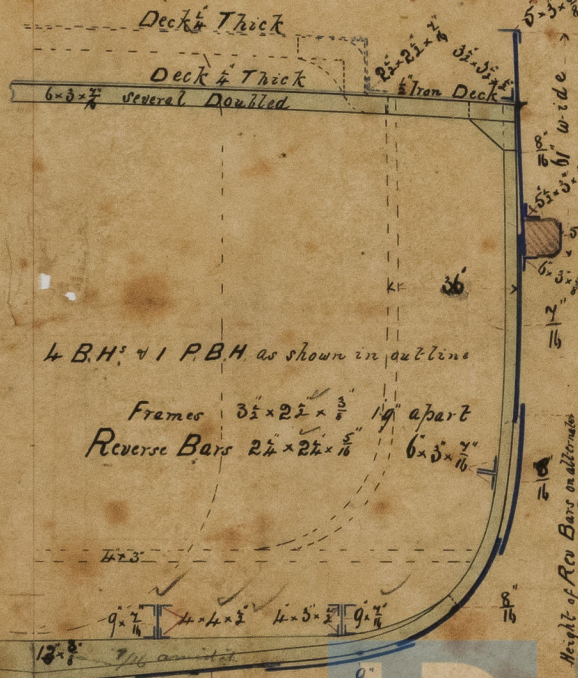

No Ribs / outside / plate  
Stimble & on all  
table withed for  
length and side

4 B.H. & 1 P.B.H. as shown in outline

Frames  $3\frac{1}{2} \times 2\frac{1}{2} \times \frac{3}{8}$  1' apart  
Reverse Bars  $2\frac{1}{2} \times 2\frac{1}{2} \times \frac{3}{8}$   $6 \times 5 \times \frac{7}{16}$

MIDSHIP SECTION  
N° 78  
Scale 2" = 1 foot

Height of Rev Bars on alternate  
frames others to Deck

Length 145' 0"  
Breadth 22' 0"  
Depth 12' 6"  
in 21' 9"

IRON 503- 0041

May 26 1870

Lloyd's Register  
Foundation