


Midship Section of New Steamers

for


Mess^{rs} Clarke & Co

Scale $\frac{1}{2}$ inch = 1 foot

28/3/70

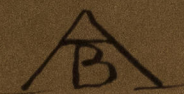

Rec 28/3/70

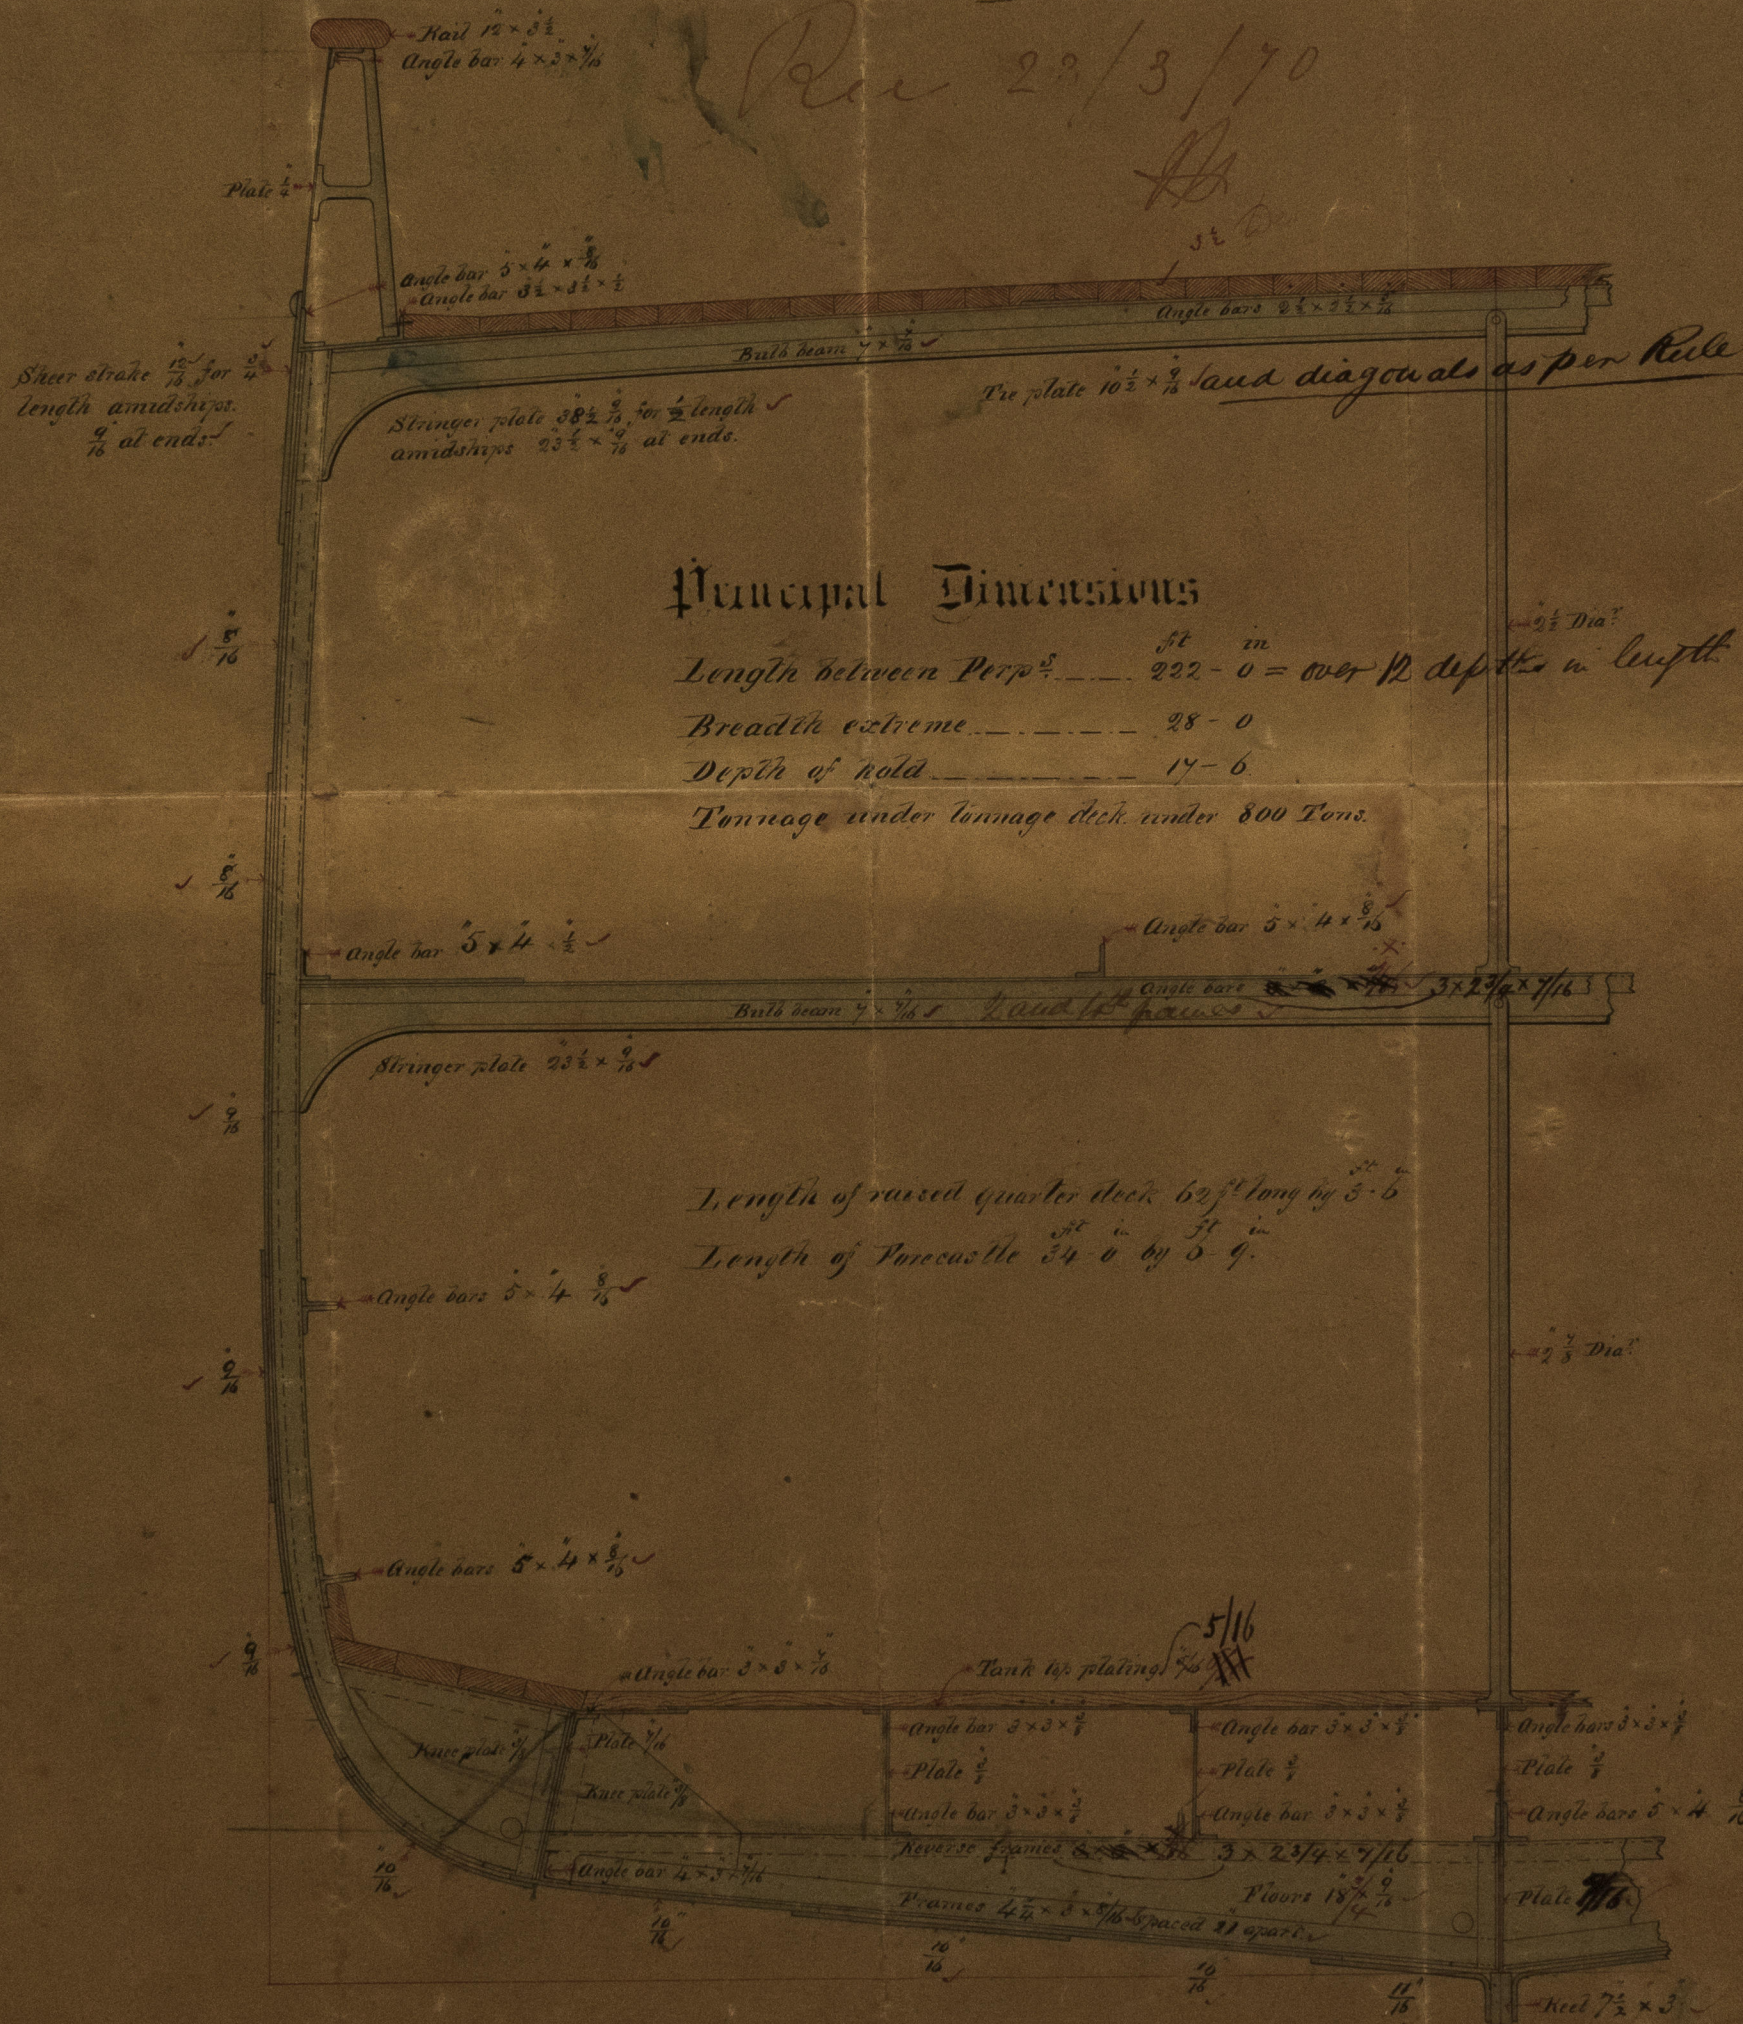

Principal Dimensions

Length between Perps. $\frac{ft}{222-0} = \frac{in}{0}$ over 12 depths in length
Breadth extreme $28-0$
Depth of hold $17-6$
Tonnage under tonnage deck under 800 Tons.



© 2021

Lloyd's Register
Foundation