


Length 12-3 } 1<sup>st</sup> Number 52.08  
 Height from keel to top of hold } 15-10 } 2<sup>nd</sup> Number 895.7  
 Breadth of hold } 14-0 } 3<sup>rd</sup> Number 12.12  
 Breadth 172 ft

S.S. N<sup>o</sup> 10

Length between Perps --- 172.3'  
 Beam --- 24.6'  
 Depth of Hold --- 14.6'  
 Gross Customs Measure 384 tons

# 438.44

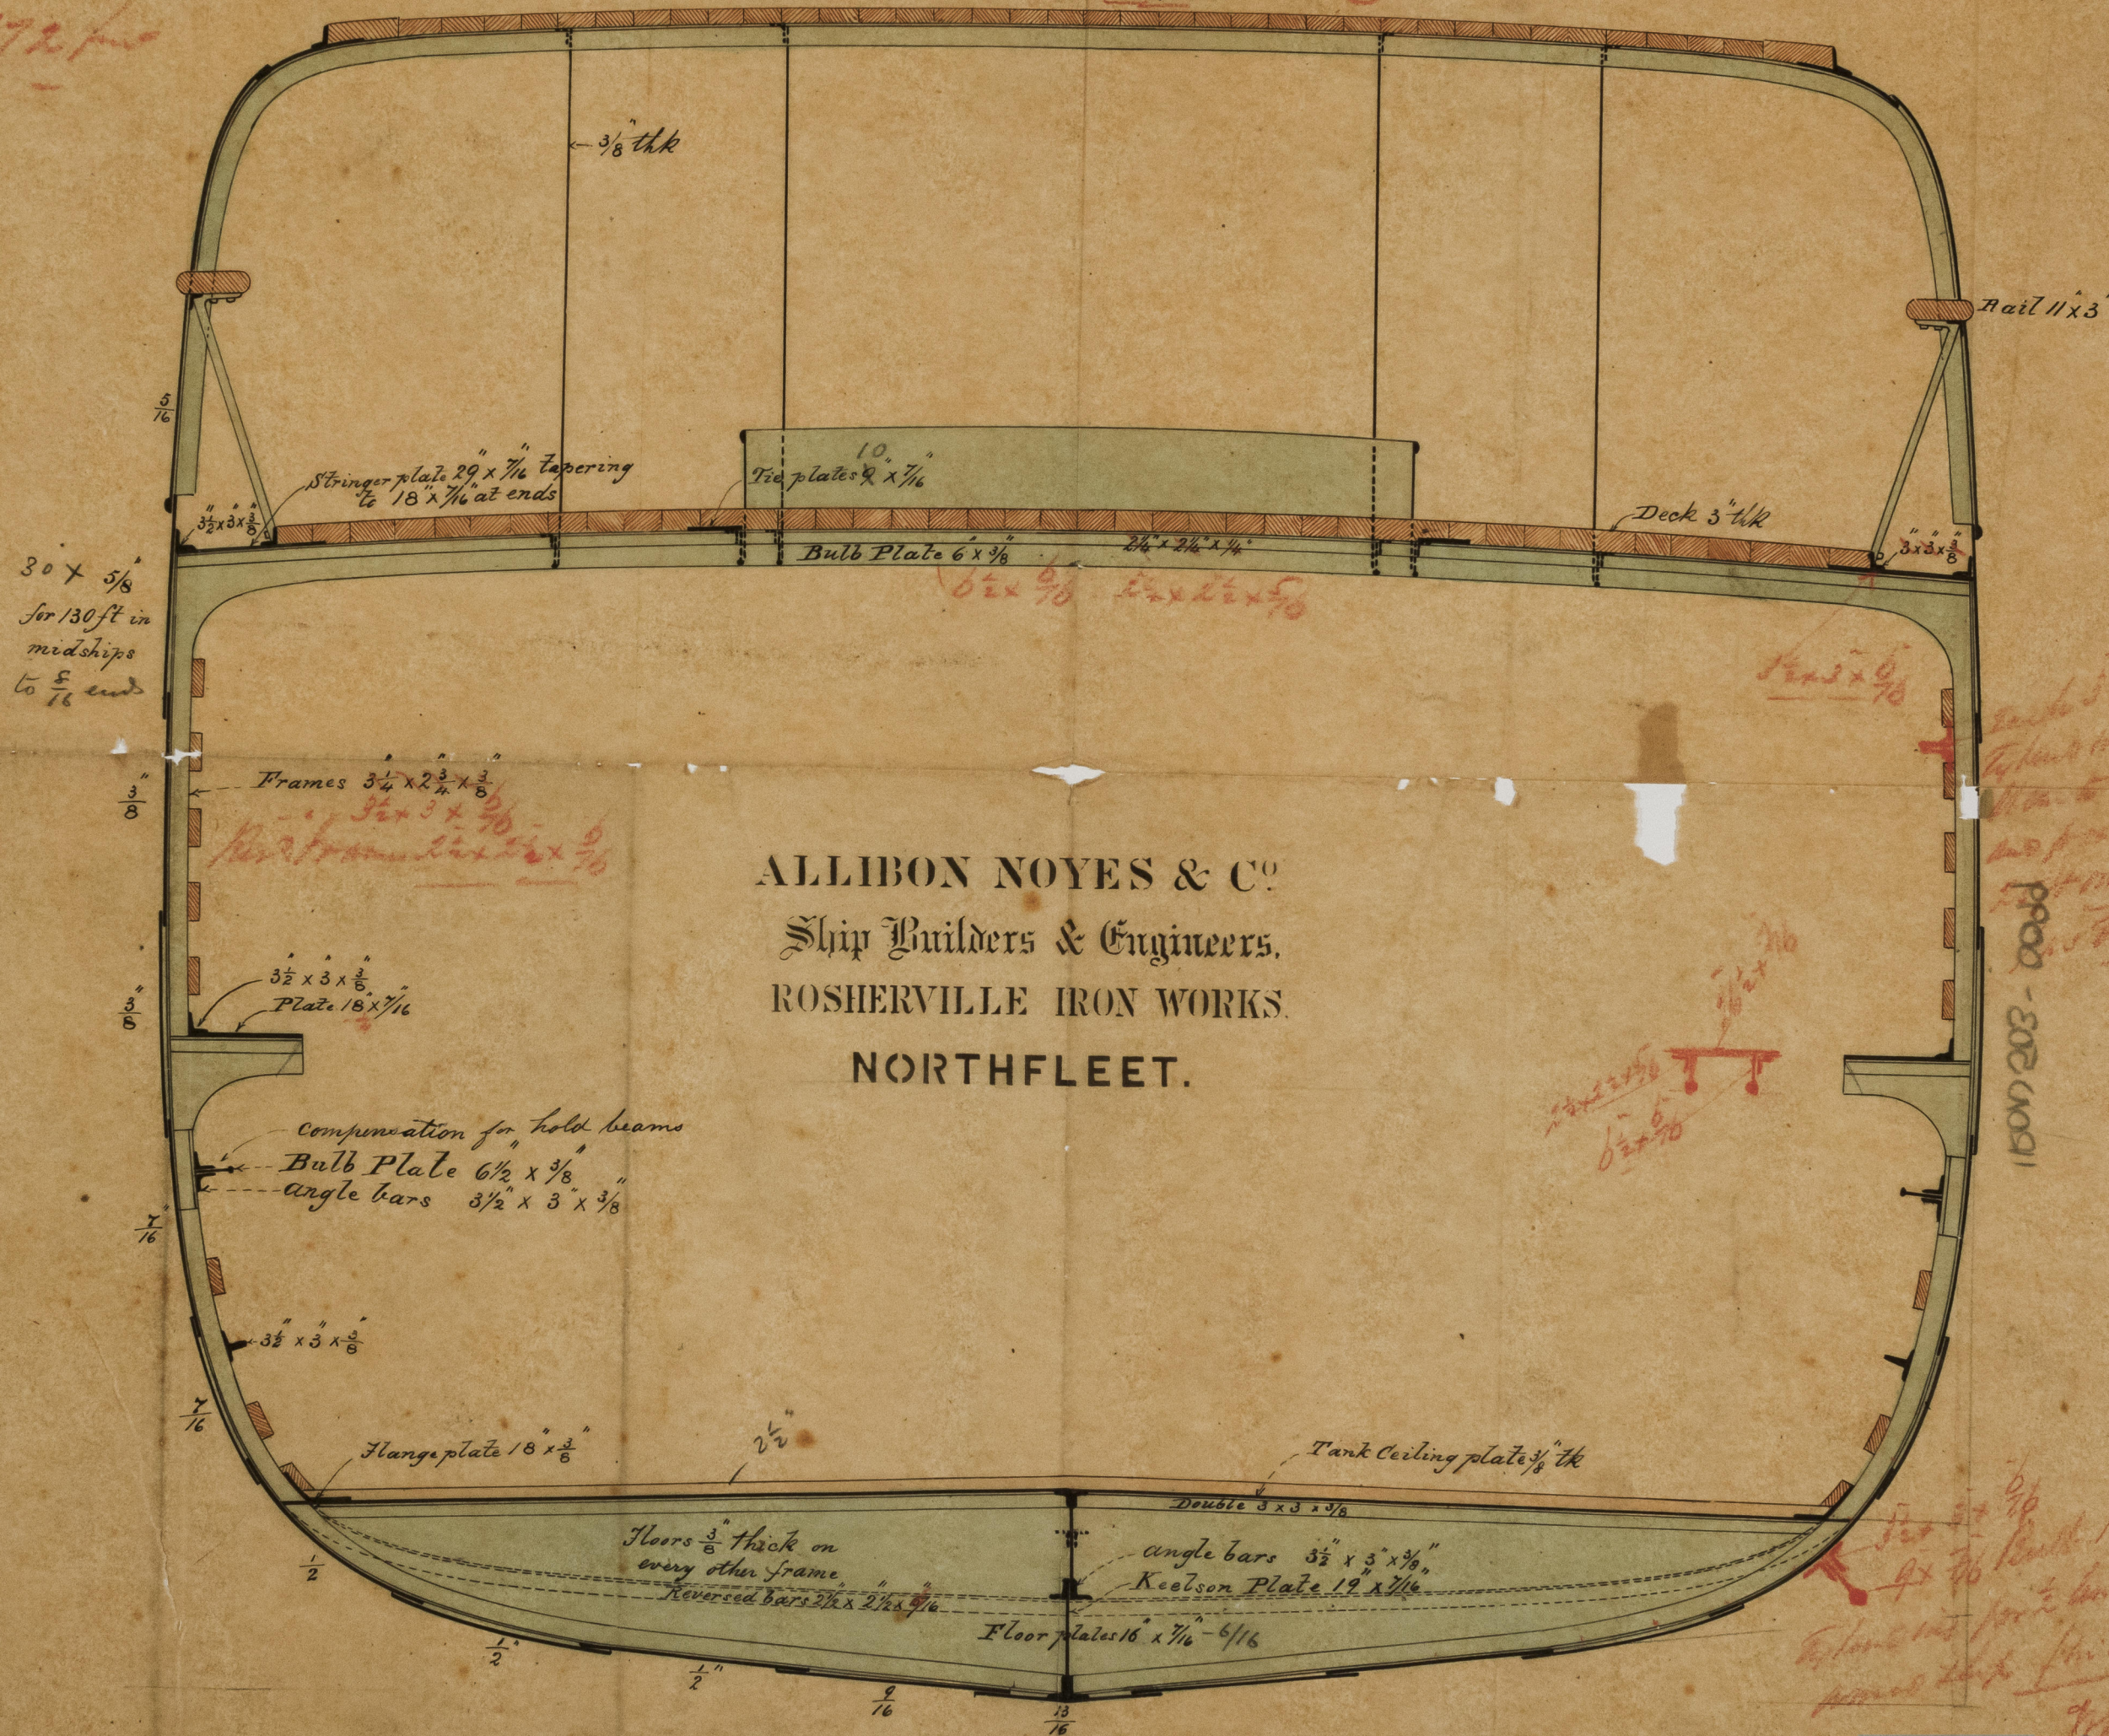

ALLIBON NOYES & CO  
 Ship Builders & Engineers,  
 ROSHERVILLE IRON WORKS,  
 NORTHFLEET.

Kirkstall No 39 Iron Bridge

IRON 503-0099



Lloyd's Register  
 Foundation  
 June 13th 1870



Old 1st and

Kirkstall. H<sup>o</sup> 39 Iron Book

IRON 503-0099

PPAO - 0020001

1st and 2nd

Shelby



© 2021  
Loyd Register  
Foundation  
