


Compensation Stringer in way
of Engine Room S.S. No 46

Scale 1 inch = 1 Foot

Rec 27/5/90

Virgo

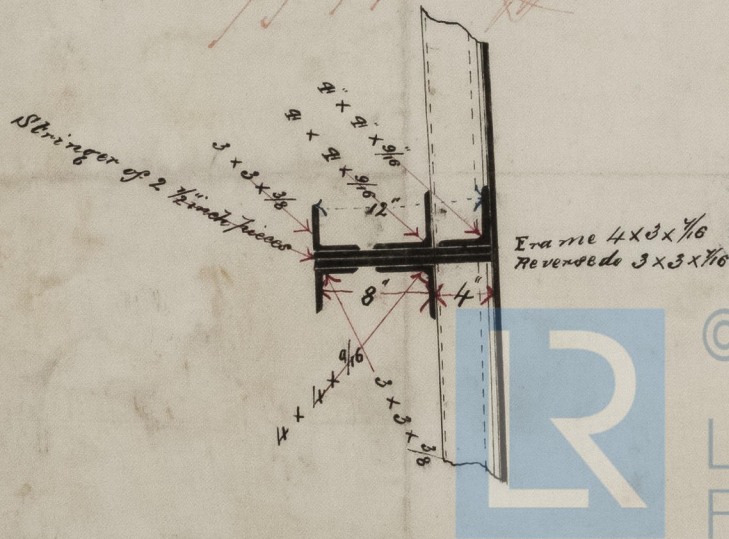

© 2021

Lloyd's Register
Foundation

IRON 503-0142