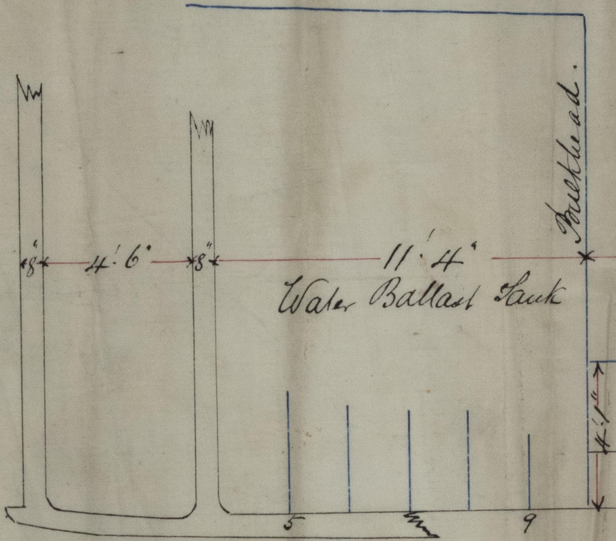

8"
4'.6"
8"
11'.4"
Bulkhead.
Water Ballast Tank
4'.1"
5
9

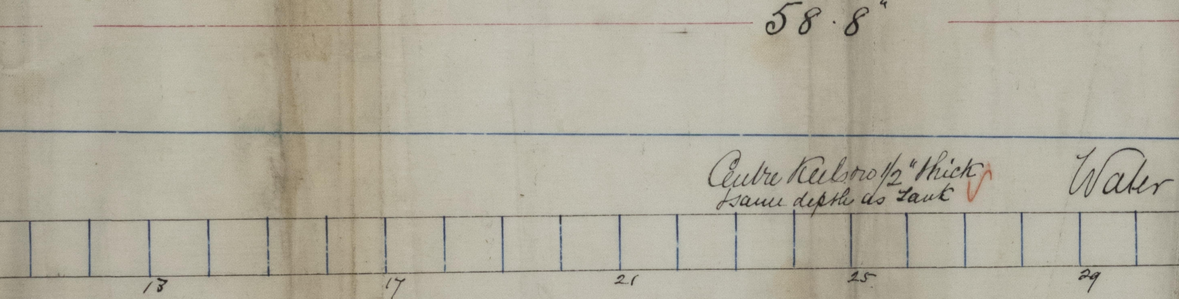
58' 8"
Centre Keelson 1/2" thick
& same depth as tank
Water
13
17
21
25
29

S.S. "Ann Webster"

Nov-29 06.

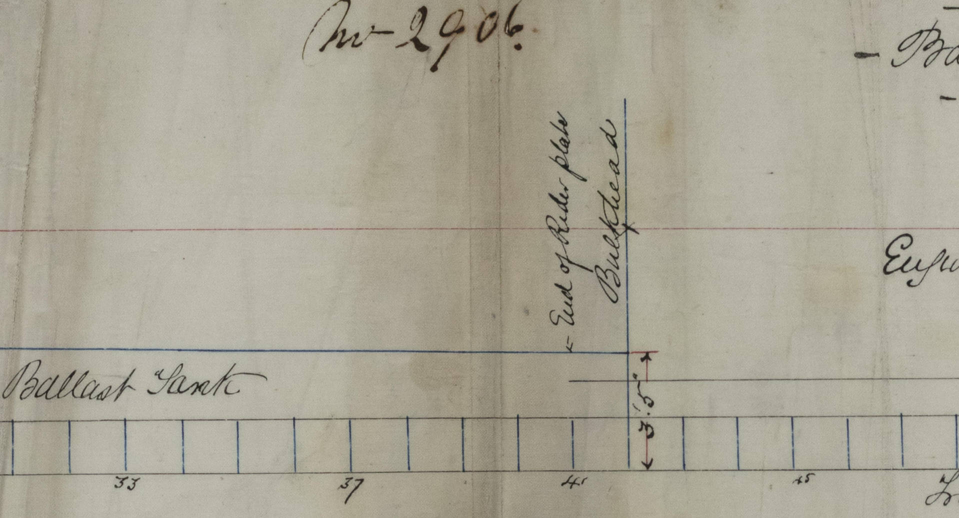

Ba
End of Rider plate
Bulkhead
Eng
Ballast Tank
3'.5"
33
37
41
45

- Plan -
- shewing -
allast Tanks -
No. 14 + 15 S.S. -
1/4" = 1 ft.

Rec. 16/7/70

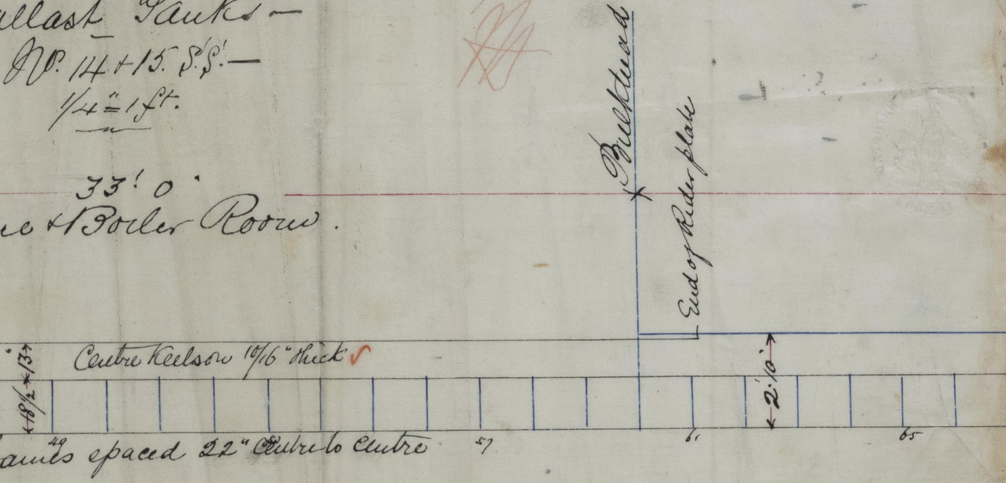
Bulkhead
End of Rider plate
33' 0"
e + Boiler Room.
Centre Keelson 10/16" thick
18½
13
2' 10"
49
57
61
65
ames spaced 22" Centre to Centre

IRONS03-0161

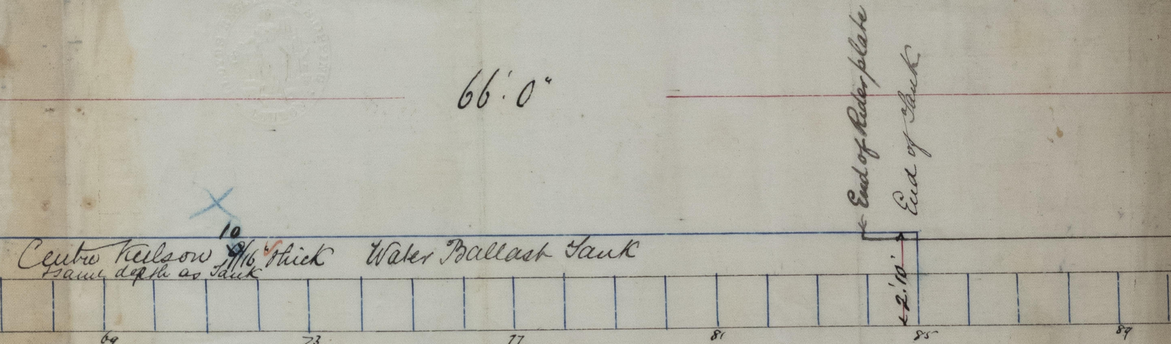
66'.0"
End of Rider plate
End of Tank
10
Centre Keelson ~~9~~/16" thick
same depth as Tank
Water Ballast Tank
2'.10"
69
73
77
81
85
89

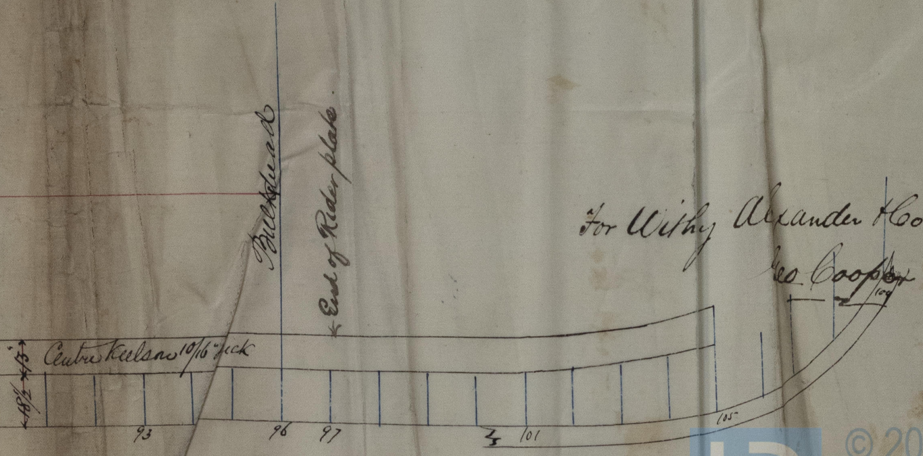

Bulkhead
End of Rider plate
Centre Keelson 10/16" thick
13"
18½"
93
96
97
101
105
109

For Withy Alexander & Co
Geo Cooper

IRON 50 0162

© 2021 Lloyd's Register Foundation