


S. J. Ann Webster  
 No 2906.


- Plan -  
 - Showing -  
 - Ballast Tanks -  
 - D.P. 14 + 15 S.S. -  
 1/2" = 1 ft.

Rev 16/9/70  
 H

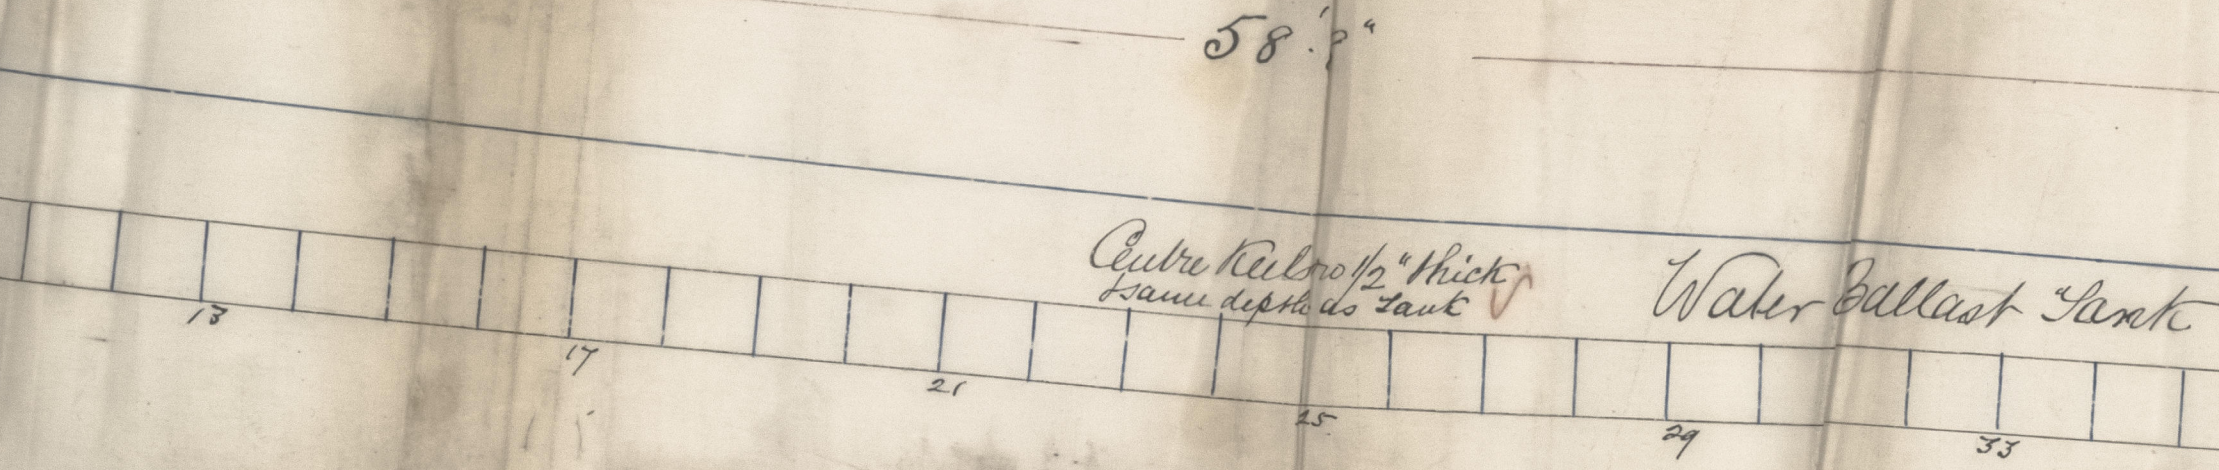


Centre Keelson 1/2" thick  
 same depth as tank

35' 0"  
 Engine + Boiler Room

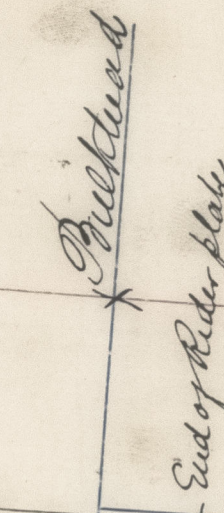

Centre Keelson 1/2" thick  
 same depth as tank

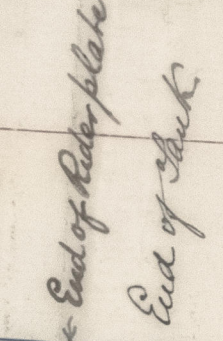

Centre Keelson 1/2" thick  
 same depth as tank

For Wm. Alexander & Co  
 Geo. Cooper

IRON 503-0161

IRON 503-0162