


Dr. 8724 Iron

S. J. Bellie
Reports No. 2918

MIDSHIP SECTION
OF
N^o 106 S.S.
Scale $\frac{1}{2}$ inch one foot


Length over 12 Depths
+ within 7 Meters.

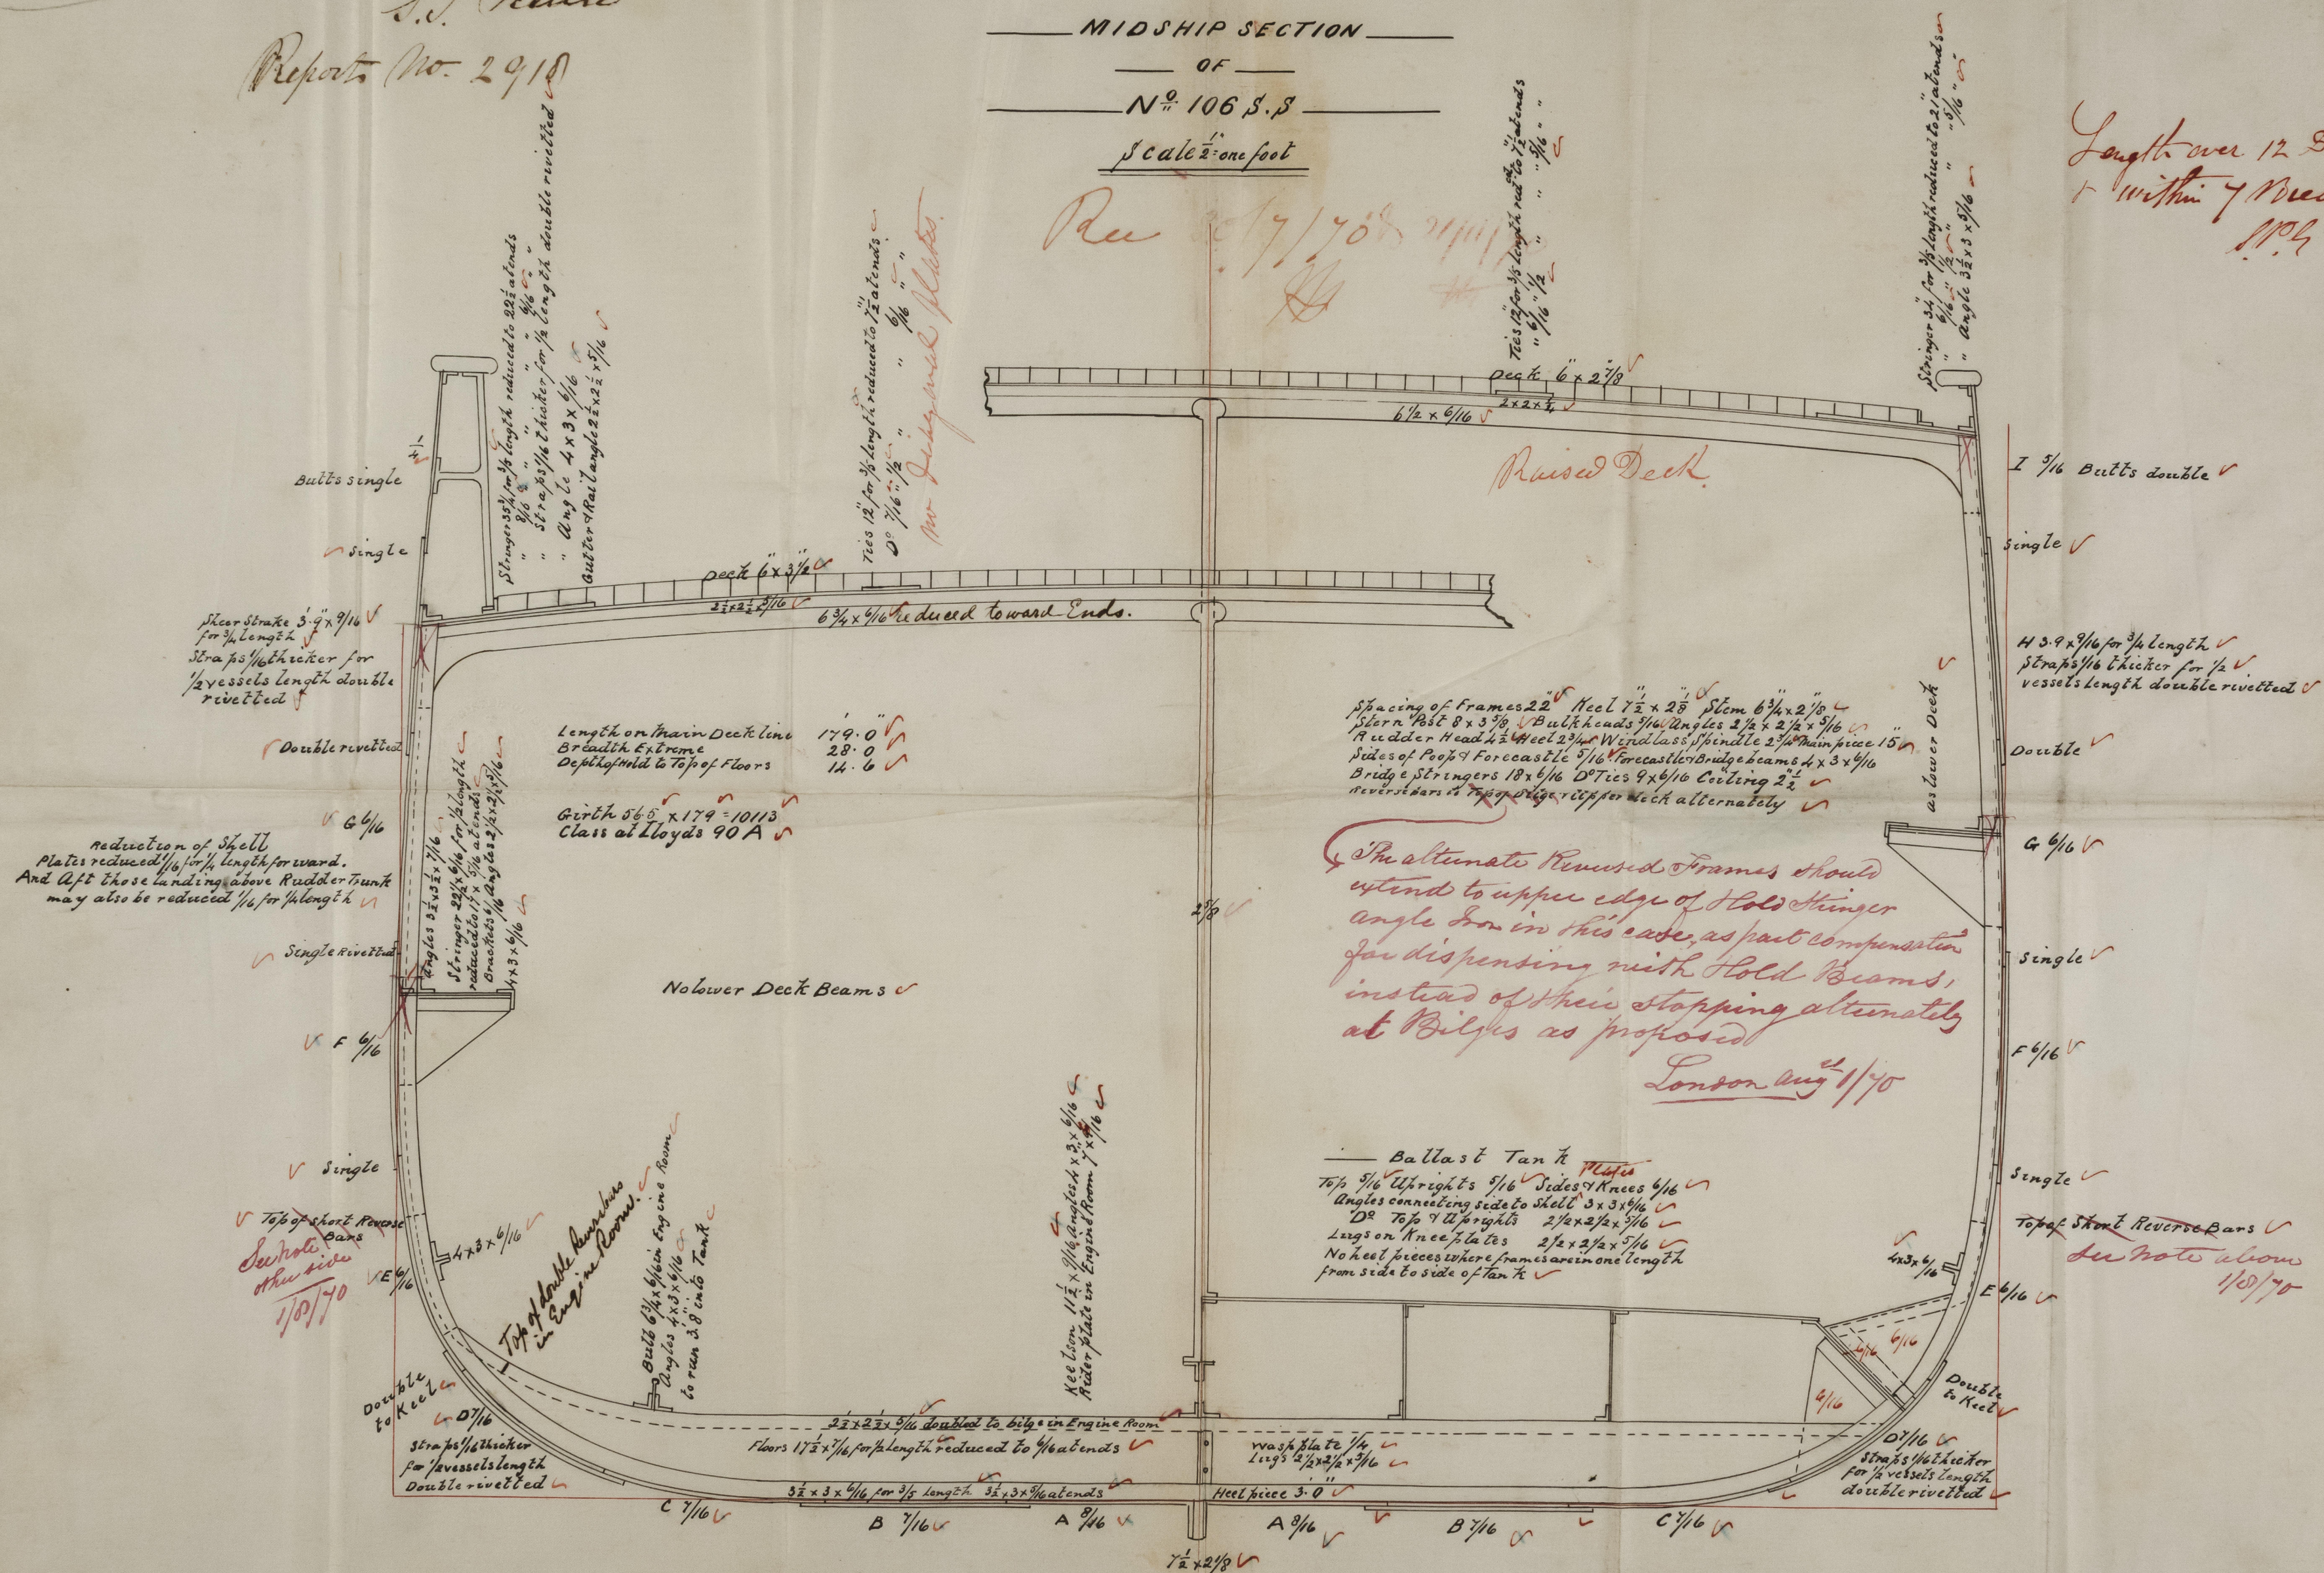

Denton Gray & Co
Dock Yard
West Hartlepool
July 28th 1870
C. W.D.