


Three decked Steam vessels  
Canton - mill 1870.

— N<sup>o</sup> 241 & 242 —

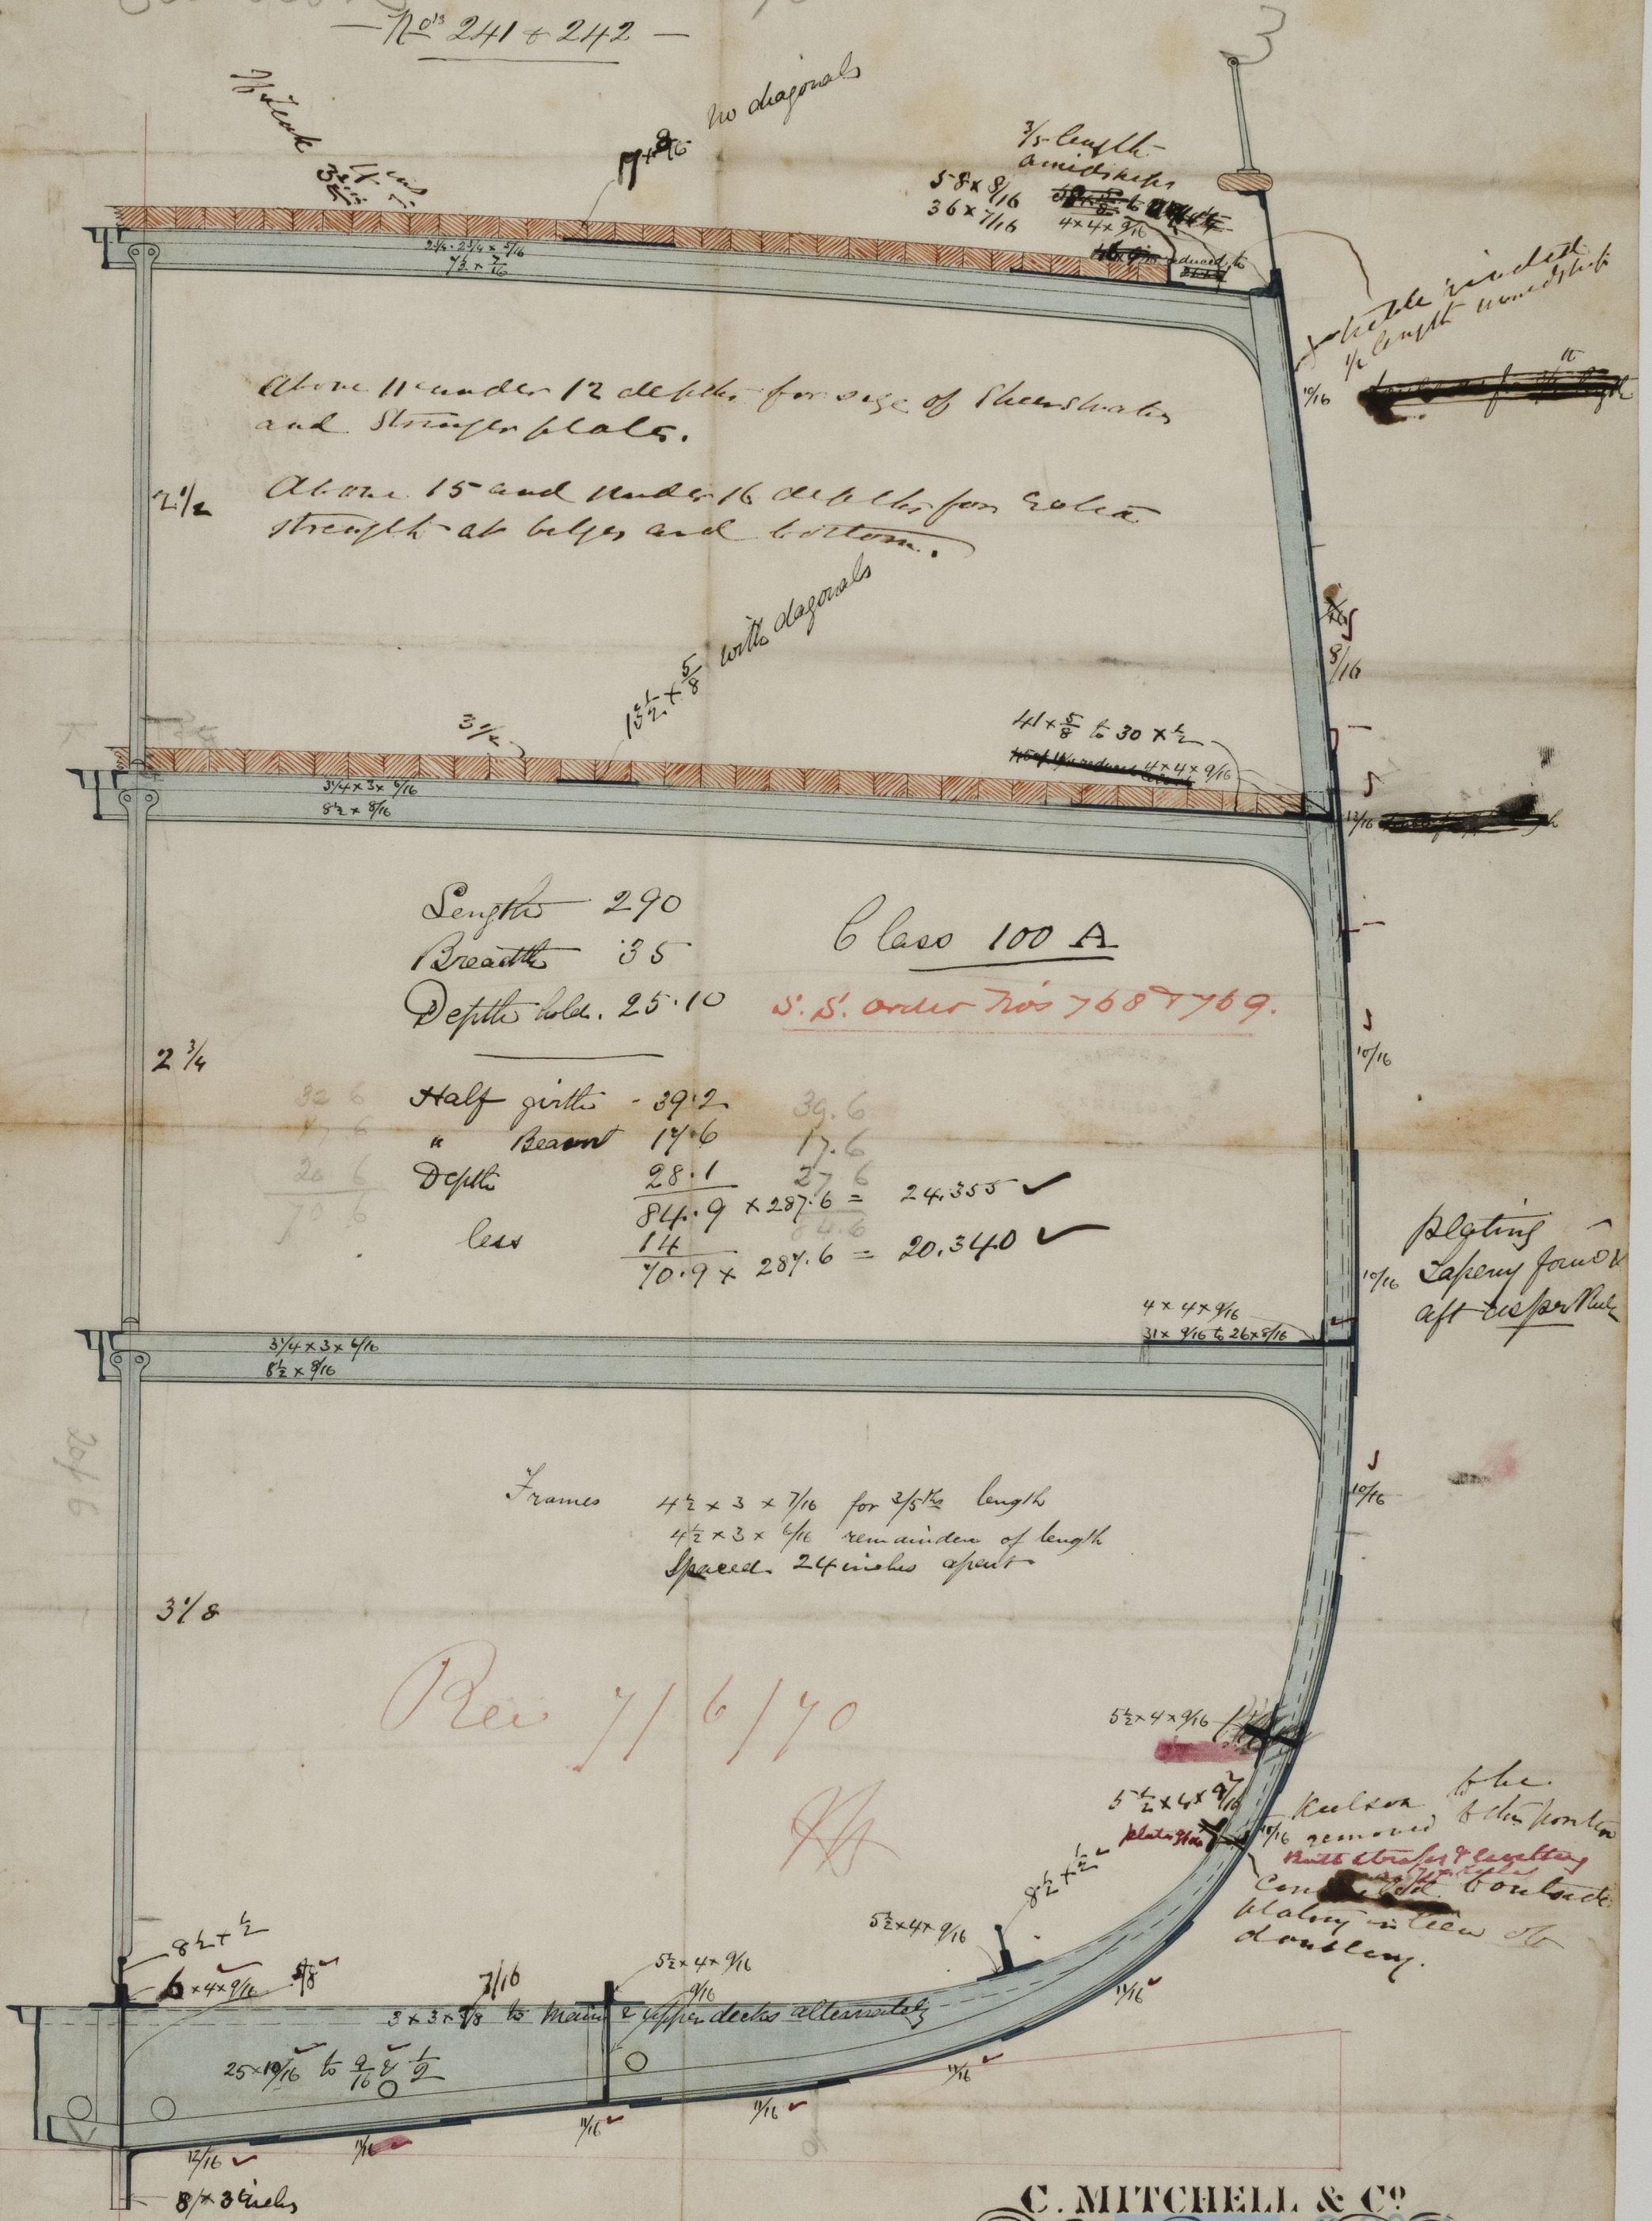

Scale of  $\frac{1}{2}$  inch to 1 foot

C. MITCHELL & CO  
Iron Ship Builders  
LOW WALKER  
Newcastle on Tyne



IRON 503- 0276