


Plan of Ship Section No. 42 S.S.
Scale $\frac{1}{2}$ " = 1 foot

Wm. Delford & Sons
Steam Ship Builders
London
Nov 9th 1870.

L 189 -
 $\frac{1}{2}$ B 14.3
 $\frac{1}{2}$ S 29.3
D 15 -
8 inches 61.6
2" D 11829

Bulbs $\frac{1}{2}$ " \times $\frac{1}{16}$ reduced as per rule
Length 189.0 inside of stem post and ends of
Breadth 28.6
Depth 16.6 clear
Girth 29.3
Under 65711.880
Clas 90.4

Rev 14/11/70
and
21/12/70

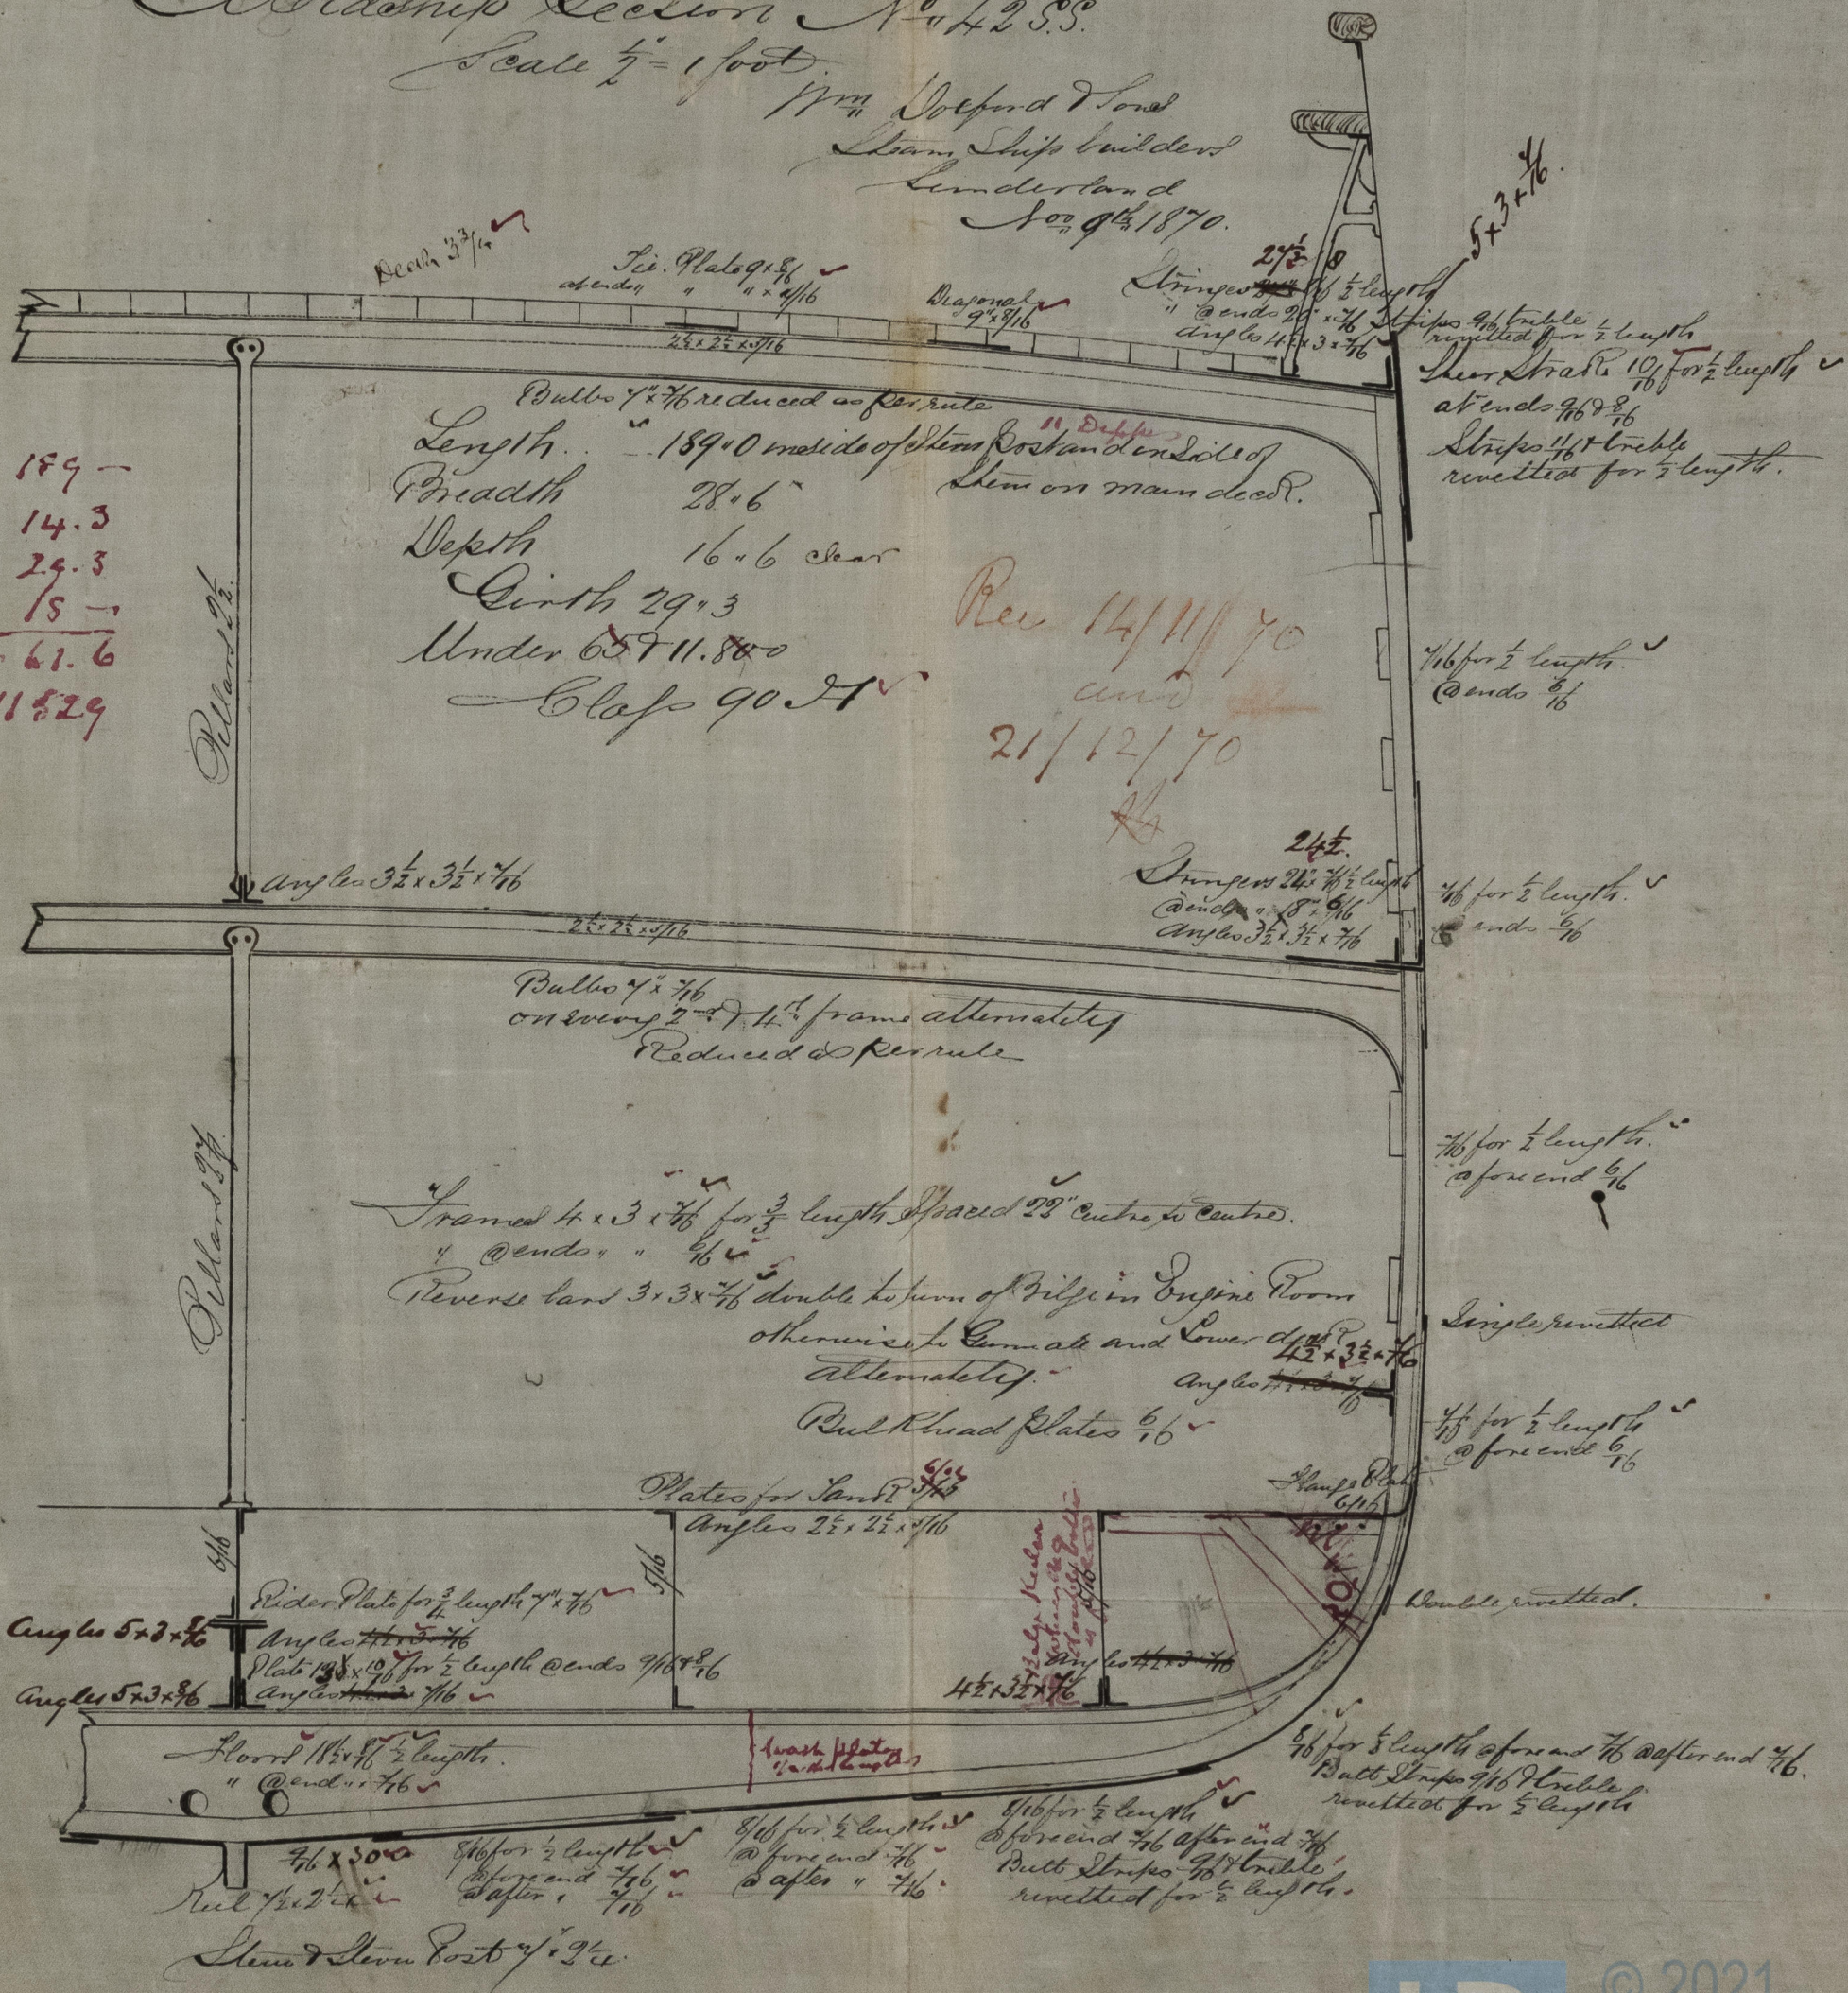

8979 Iron

IRON 503 0323



© 2021

Lloyd's Register
Foundation