


Good Iron

Yorkshire

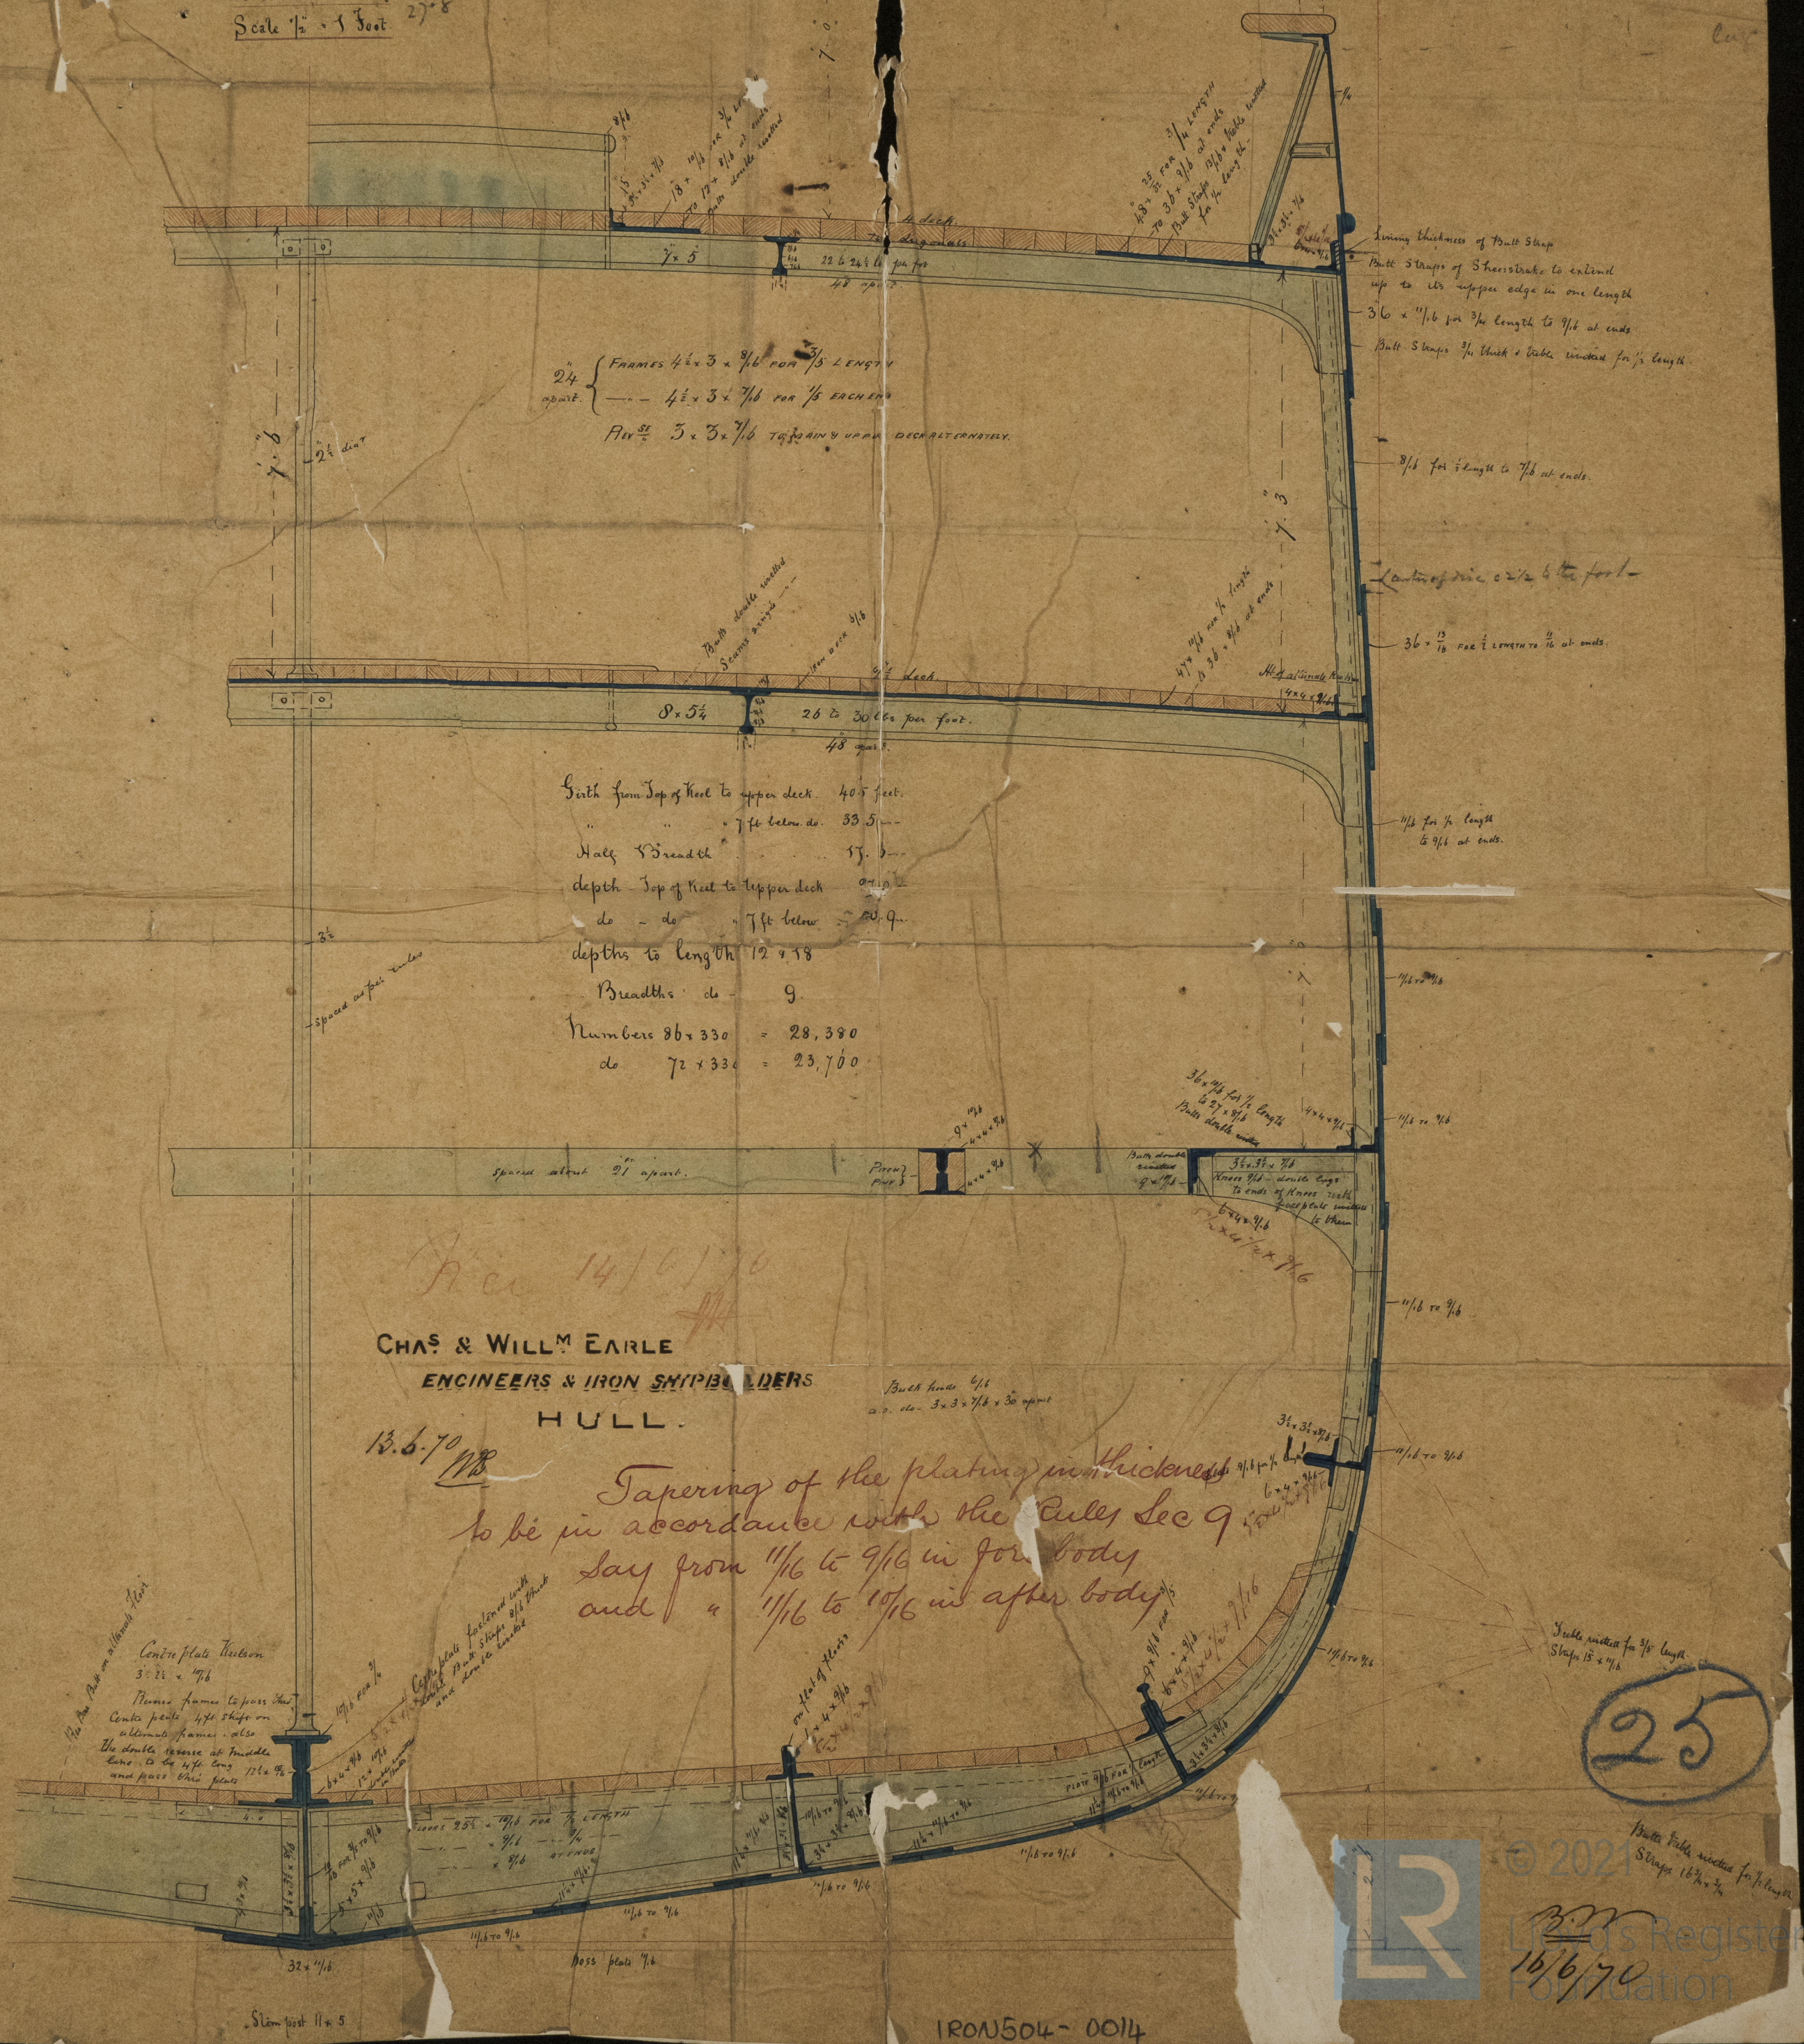

25

© 2021 *Small Bible marked for 1/2 length*
Straps 16 3/4 x 3/4
 Life's Register
 16/6/70
 Foundation

IRON 504 - 0014

Yorkshire

IRON504-0014



© 2021

Lloyd's Register
Foundation