


Limited
Newcastle-on-Tyne

Midship Section

S.S. "John Fenwick"

Scale $\frac{1}{2}$ inch = One foot

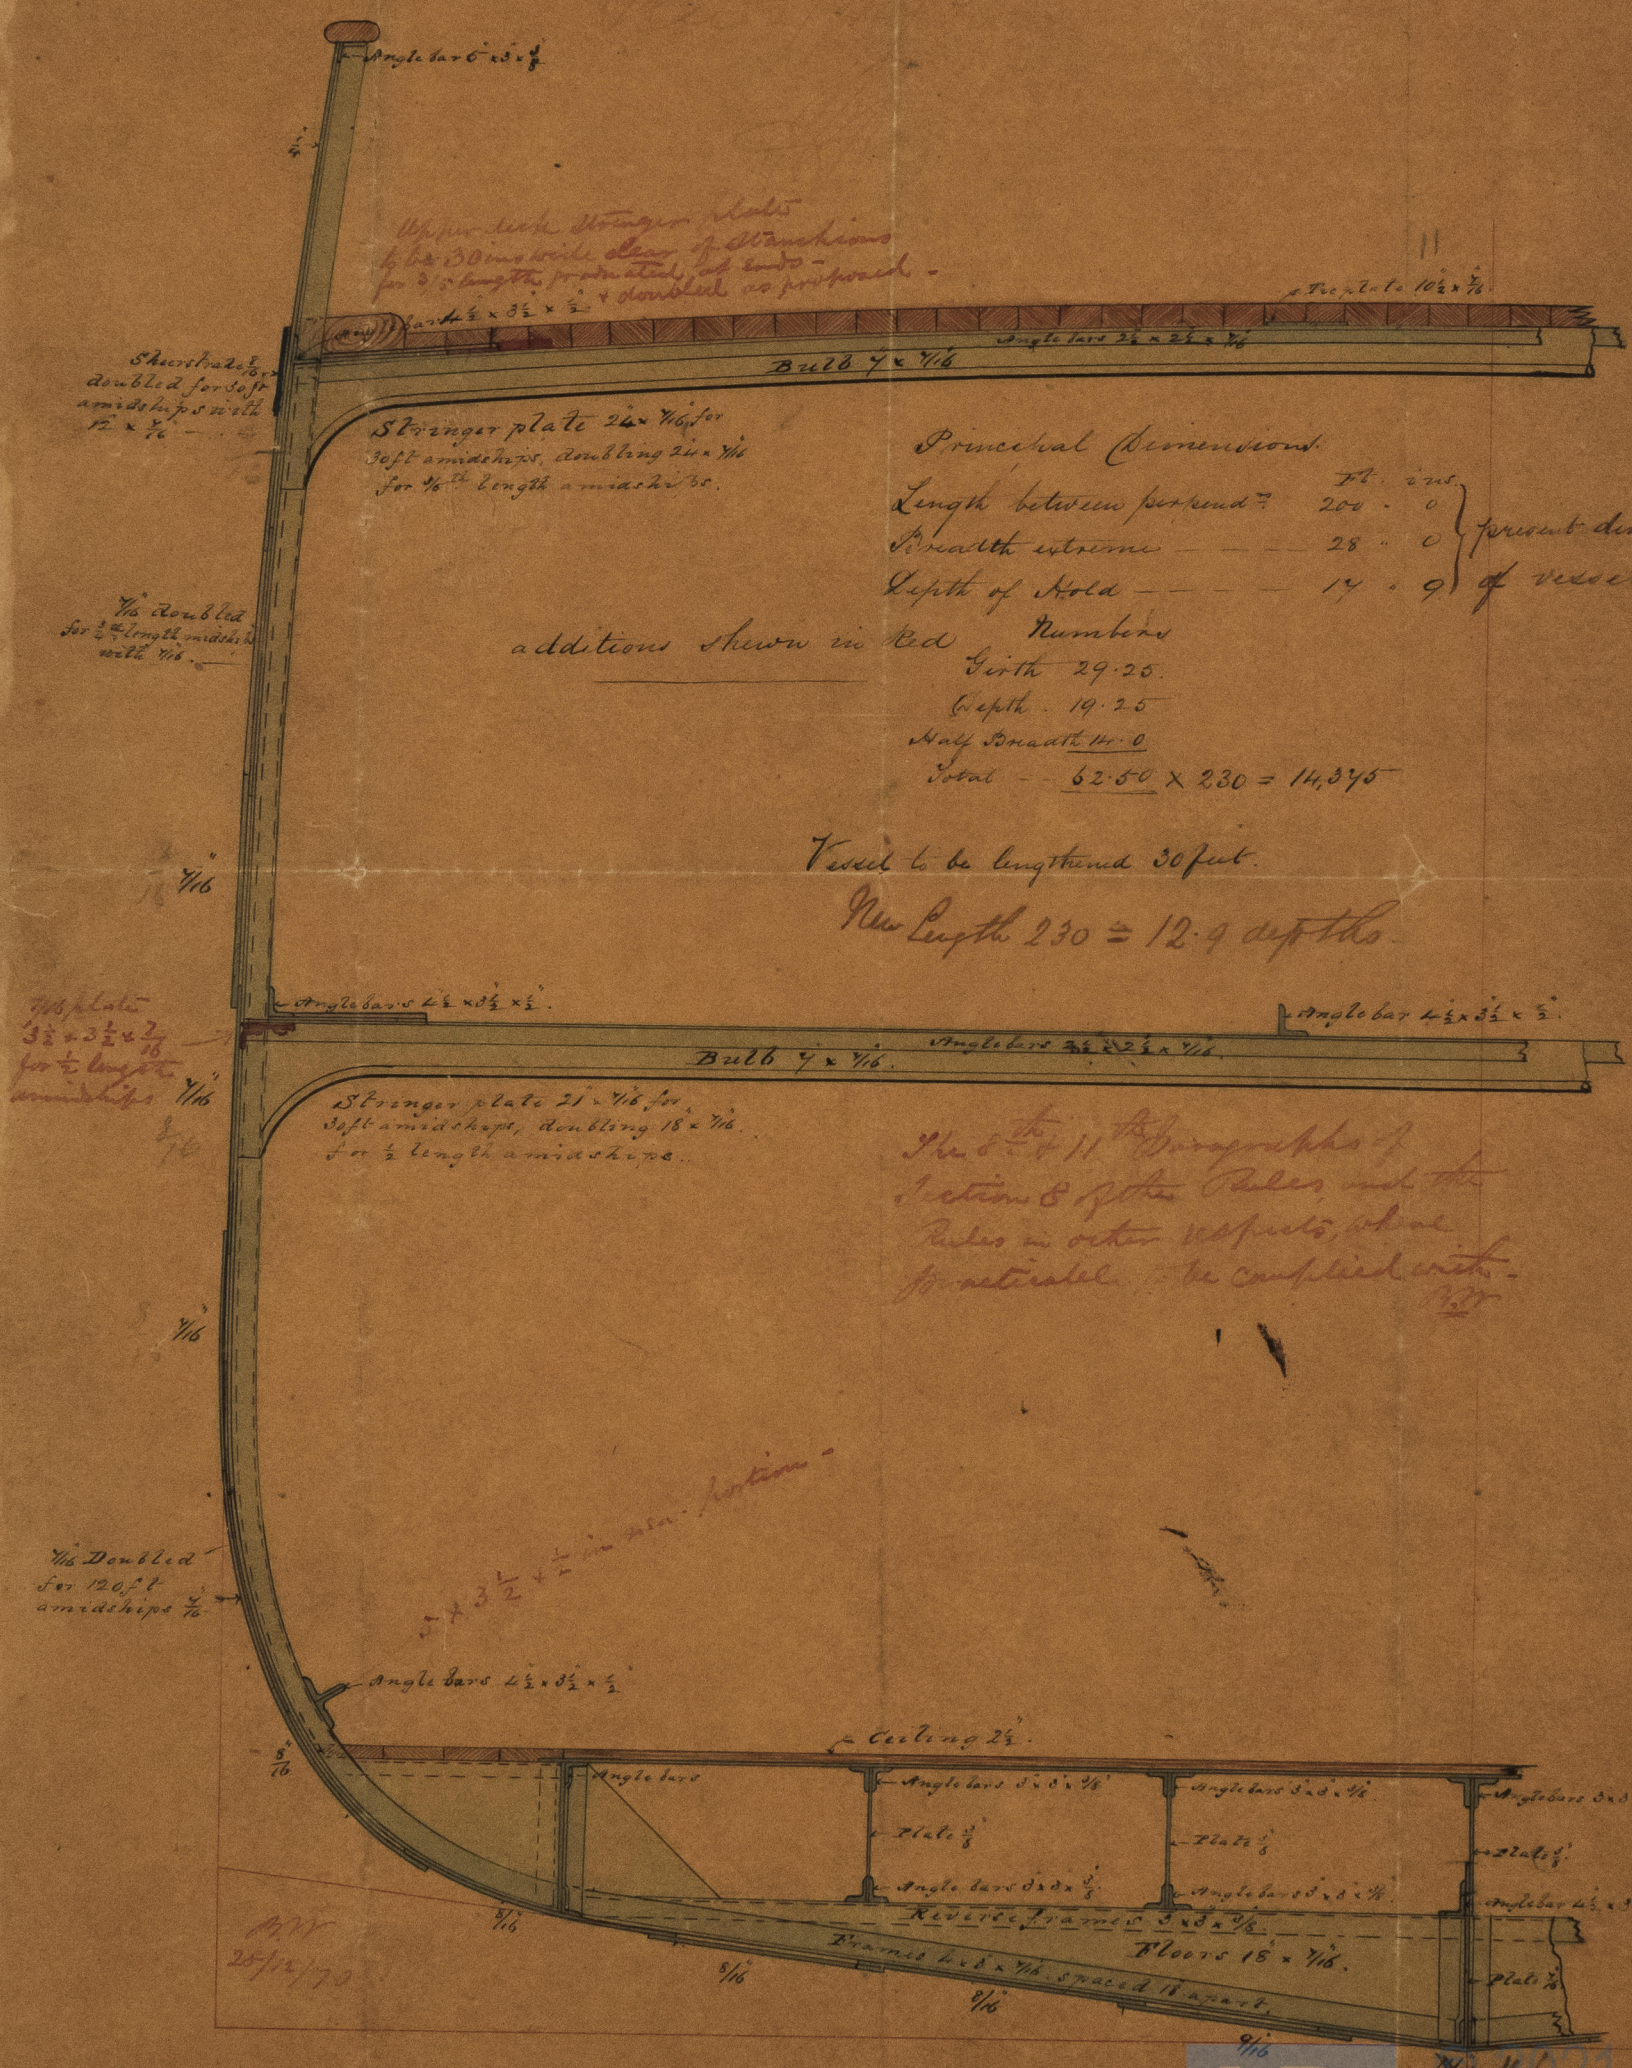

Principal Dimensions.

	Feet.	Inches.	
Length between perpend	200	0	present dimensions of vessel
Breadth extreme	28	0	
Depth of hold	14	9	

additions shown in Red Numbers

Girth	29.25
Depth	19.25
Half Breadth	14.0
Total	62.50 x 230 = 14,375

Vessel to be lengthened 30 feet.

New Length 230 = 12.9 depths

The 8th & 11th Paragraphs of Section 8 of the Rules, and the Rules in other respects, shall be complied with.

$2 \times 3 \frac{1}{2} \times \frac{1}{2}$ in. plate section



14/12/71
Lloyd's Register
Foundation

IRON 504-0098