


H. Libby  
Report No. 2494

Longitudinal Section  
for  
No. 115. S.S.  
Scale 1/1600

15/12/70  
H

 


Denton, Gray & Co.  
Dock Yard  
West Hartlepool  
Dec 18<sup>th</sup> 1870

15/12/70



1871  
9381 Iron

IRON 504-0164

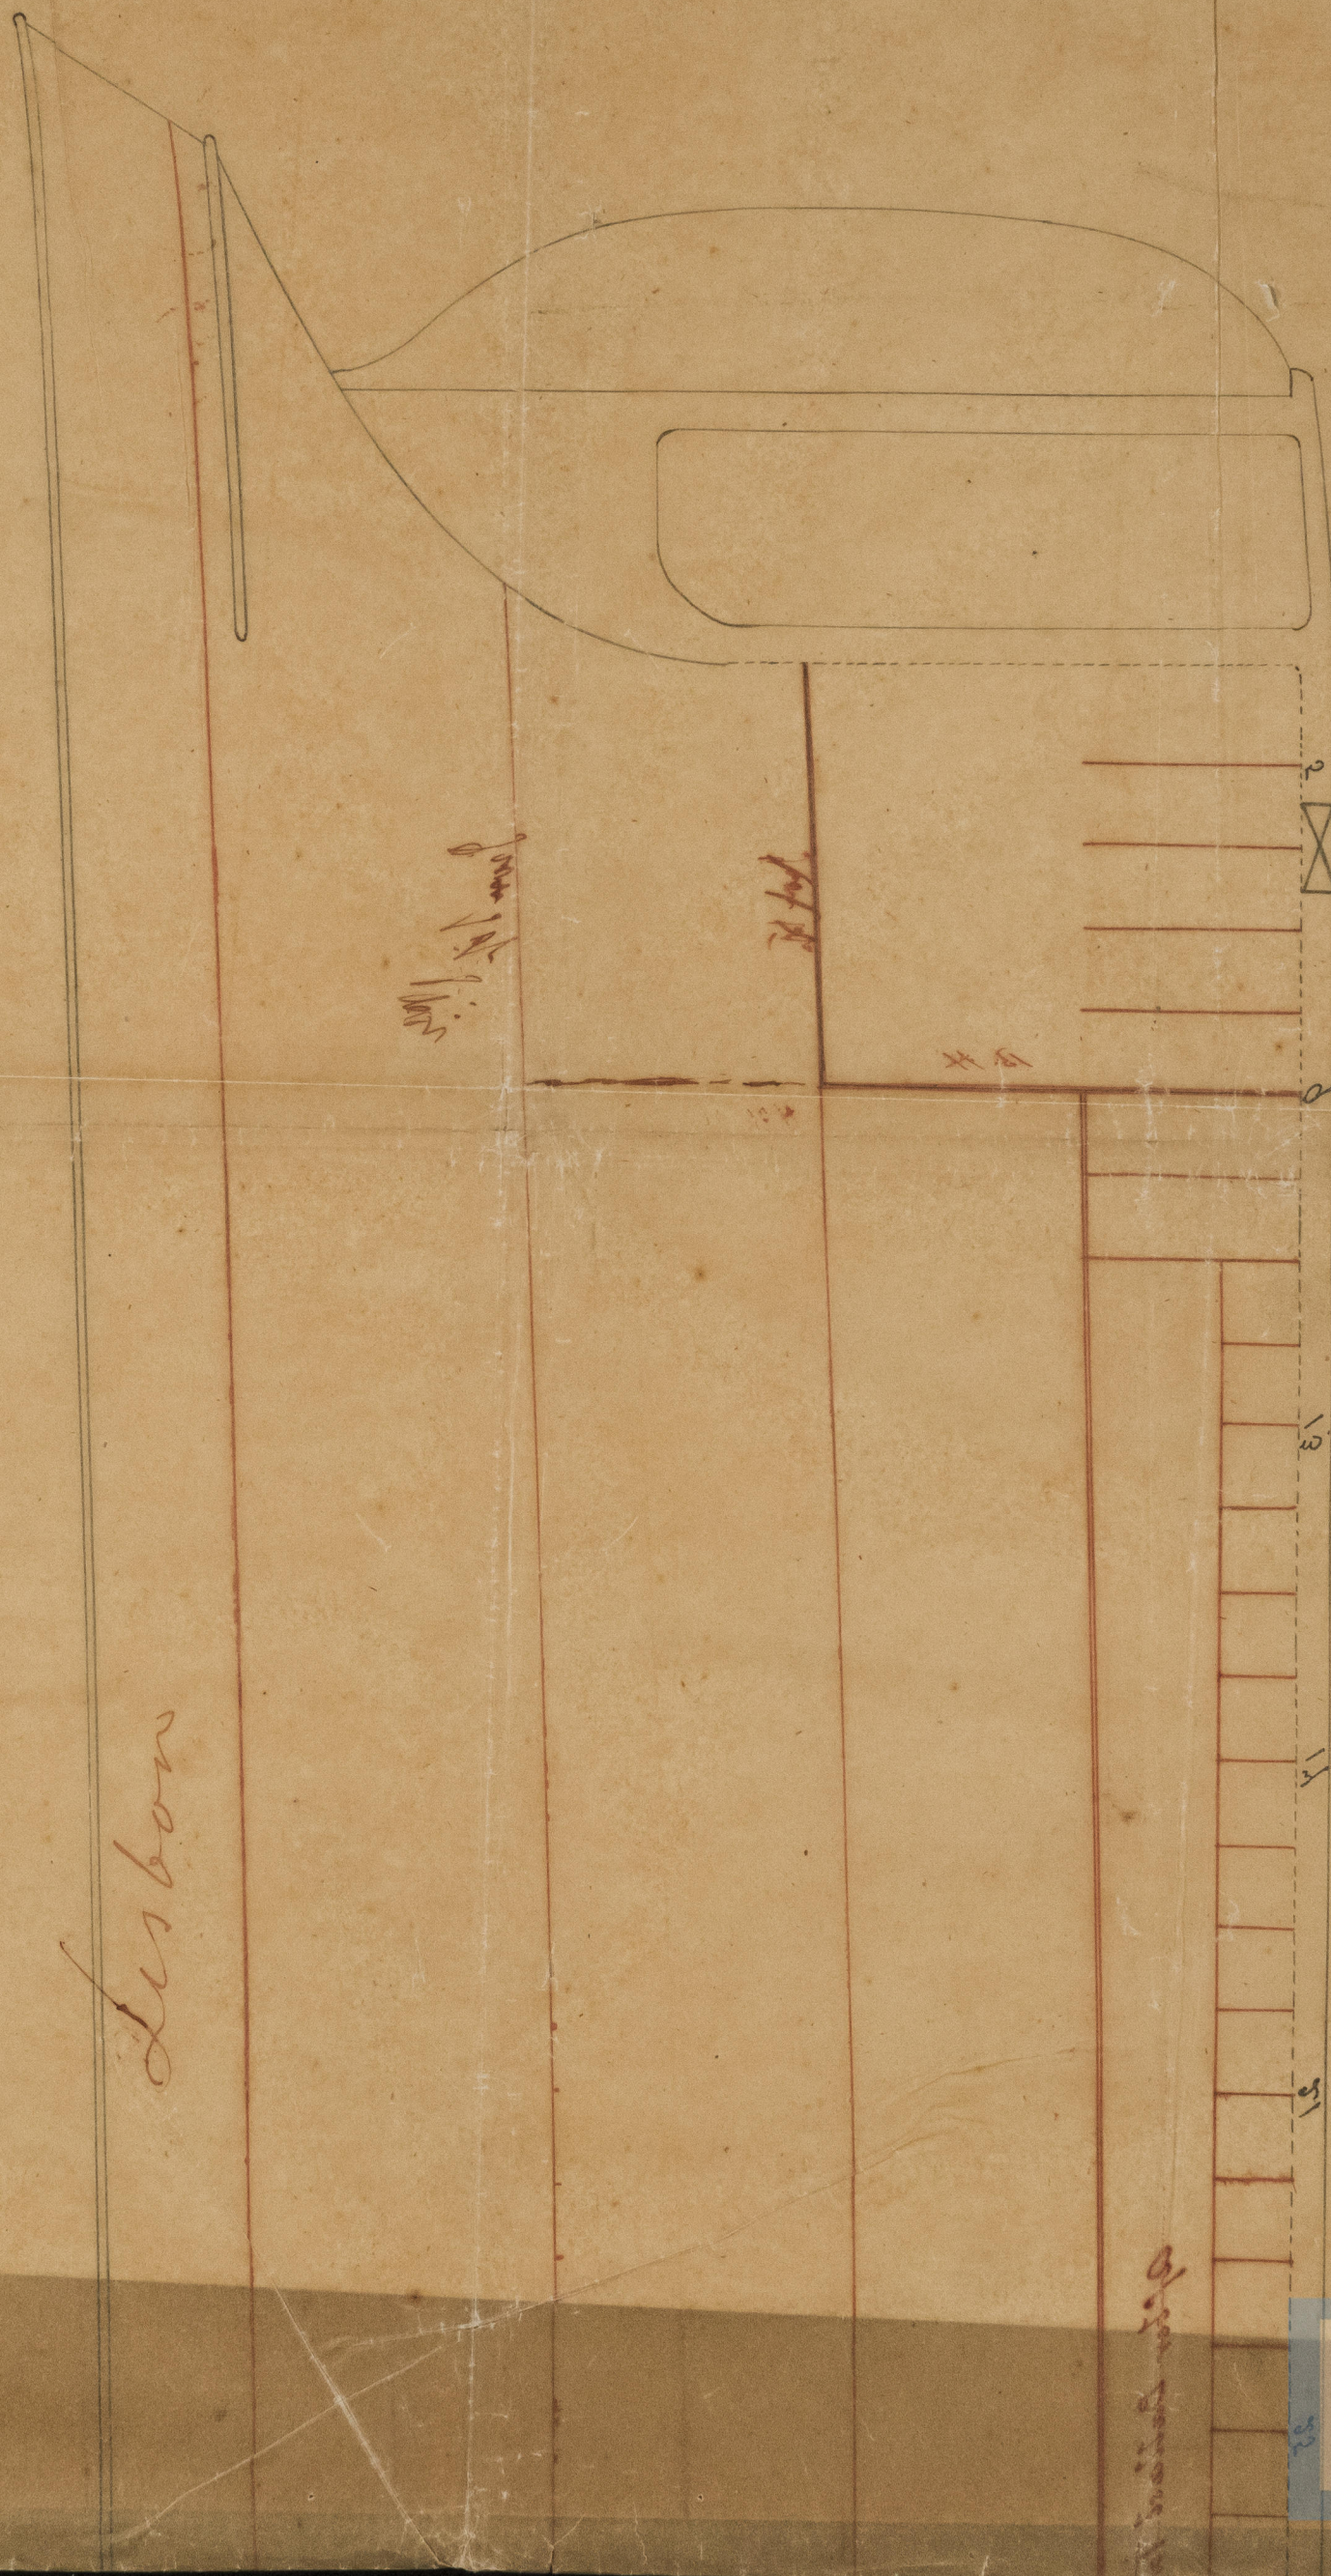

© 2021

Lloyd's Register  
Foundation



Handwritten signature

10.6.71  
300 + 300 = 600

Handwritten signature

Handwritten signature

Jan 9 381

IRON 504 - 0164

Handwritten signature

Handwritten signature