


S.S. "Lisbon" Report No. 2994

S.S. No 115 Masts. - Iron. -

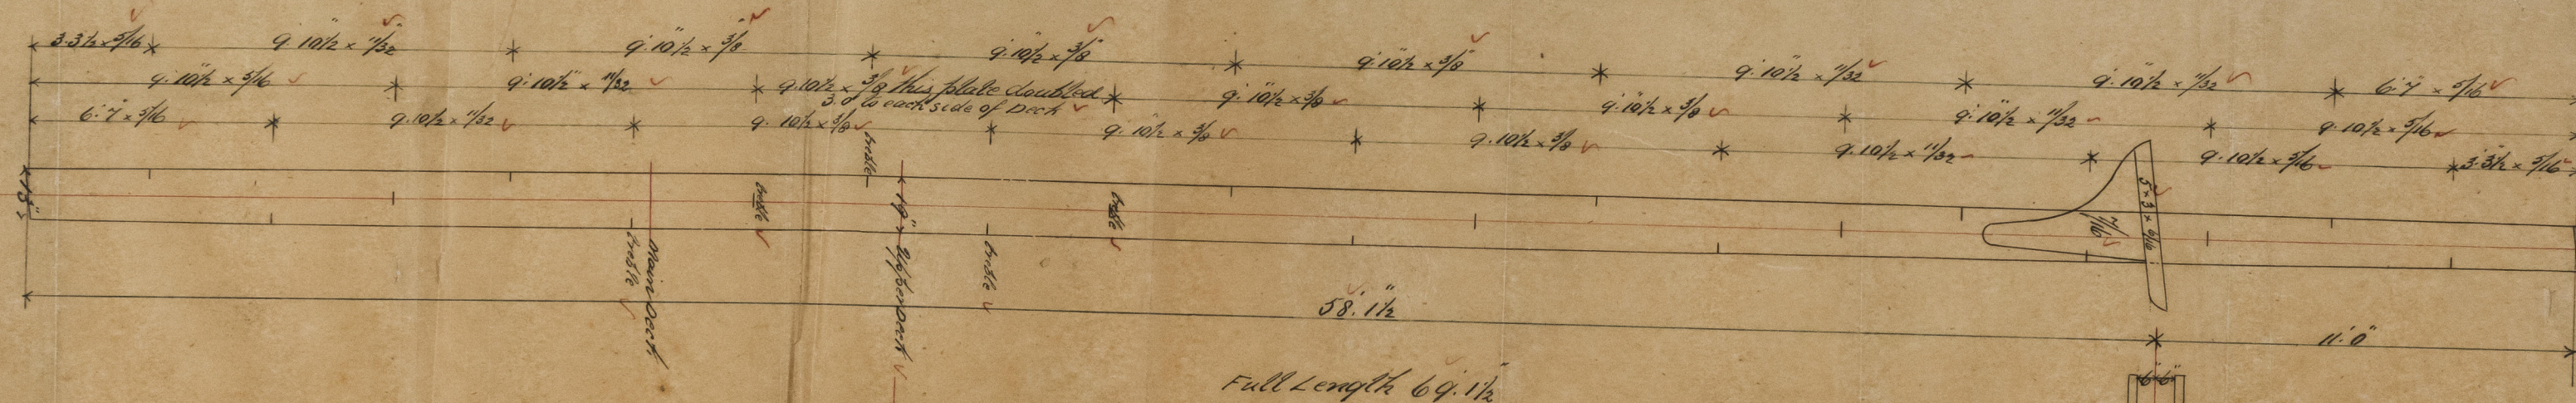

Full Length 69' 1 1/2'

Mast to be of 3 Plates. Plate seam double rivetted.  
1 Plate doubled in way of Deck. all Bolts double  
rivetted except those marked trouble. - Rivets 3/8" -

Straps 1/16" thicker than the plates they connect. -



© 2021  
Denton Gray & Co  
Back Yard  
West Hartlepool  
Feb 7 1870  
Foundations

IRON 504-0166