


No. 146 by W. James Caird Rev. 4/1
 Scale $\frac{1}{8}'' = 1 \text{ Foot}$.

$300 \times 35 \times \frac{17.9}{35.3}$ to upper or.
 100 a.
 3 Decks.

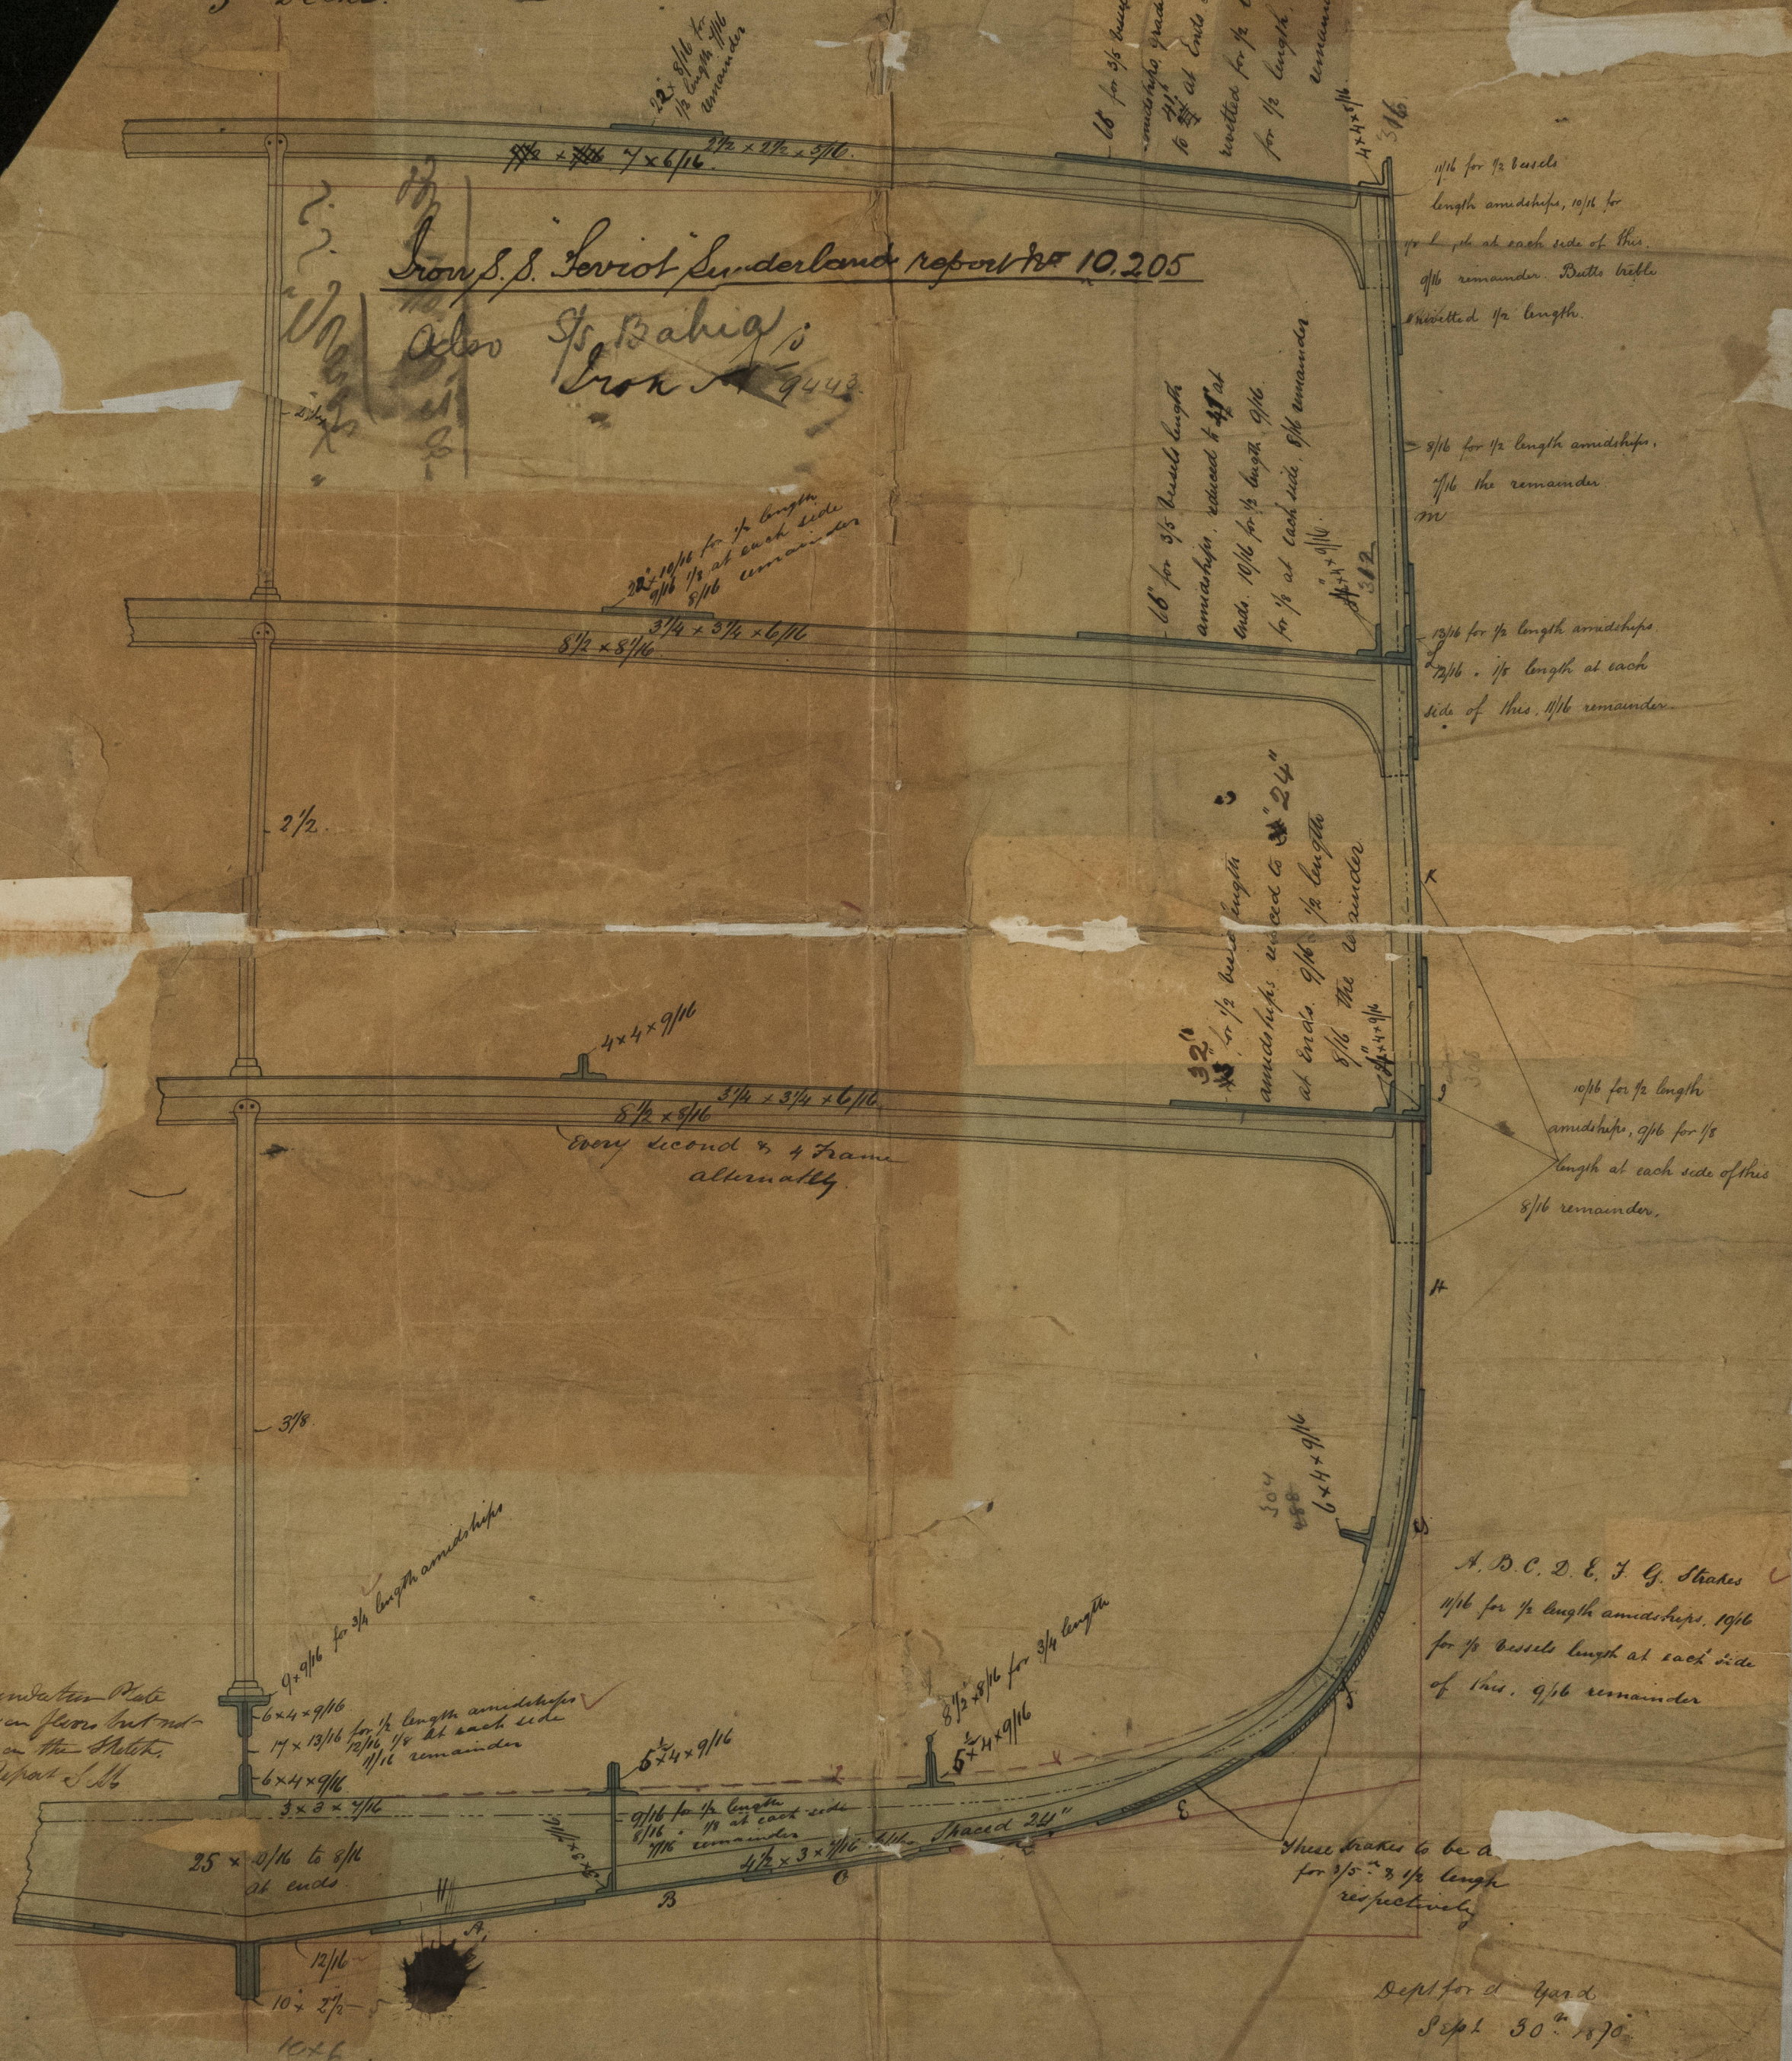

Sept for d. Yard
 Sept 30th 1870