

Report No. 3008 S. S. Richmond

# MIDSHIP SECTION

S.S. No 71.


LENGTH	220.0
BREADTH	30.0
DEPTH	15.5
MOULDED	25.0 1/2

Half Breadth 15.00  
Depth 15.5  
Half Girth 35.17  
No. 96 Number  
Length 220  
16.37 Number.

Half Breadth 15.00  
Depth 17.0  
Half Girth 38.45  
No. 49 Number  
Length 220  
13.307 Number.

Over 11 breadths  
Under 12 depths to Upper Deck  
Over 14 depths to Main Deck.

Rec 18/4/71 & 29/7/71  
Glass 90.2

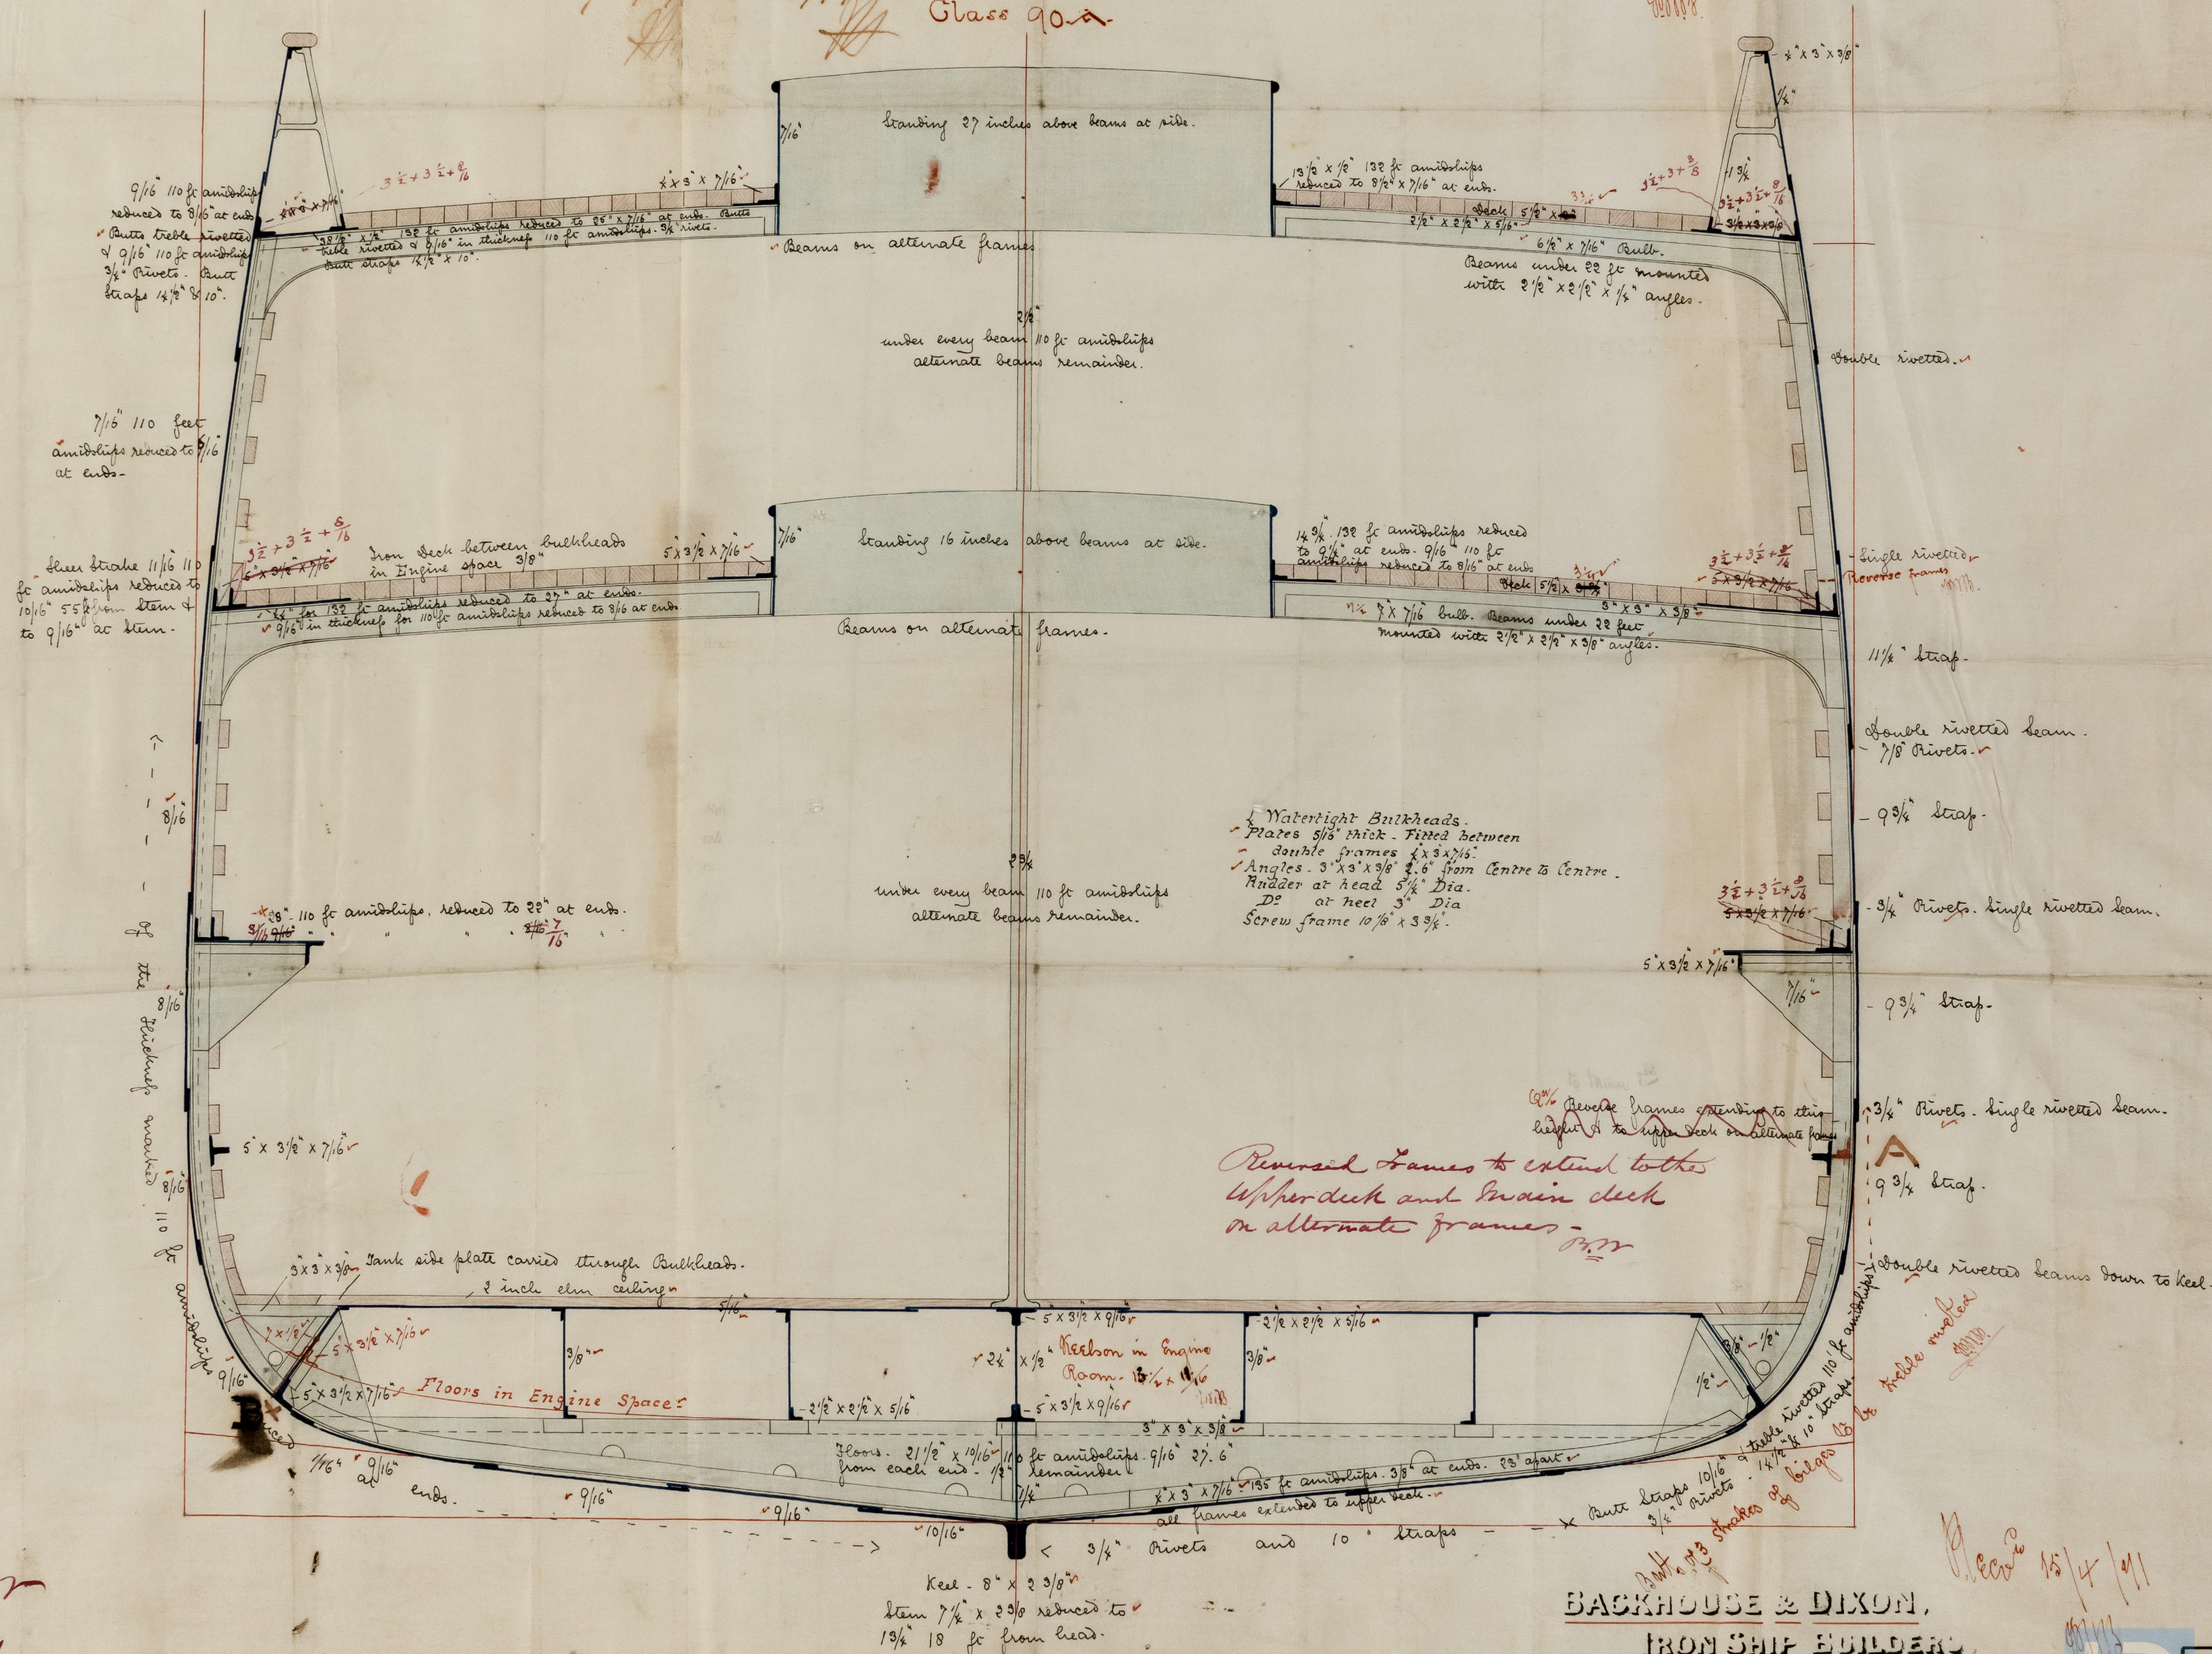

19/4/71  
21/7/71

SCALE 1/2 OF AN INCH = 1 FOOT

BACKHOUSE & DIXON,  
IRON SHIP BUILDERS,  
MIDDLEBROUGH-ON-TEES.

IRON 504-0235