


MIDSHIP SECTION.

Nº 73. Scale $\frac{1}{2}$ of an Inch to a Foot.

Rev 9/3/71
MA

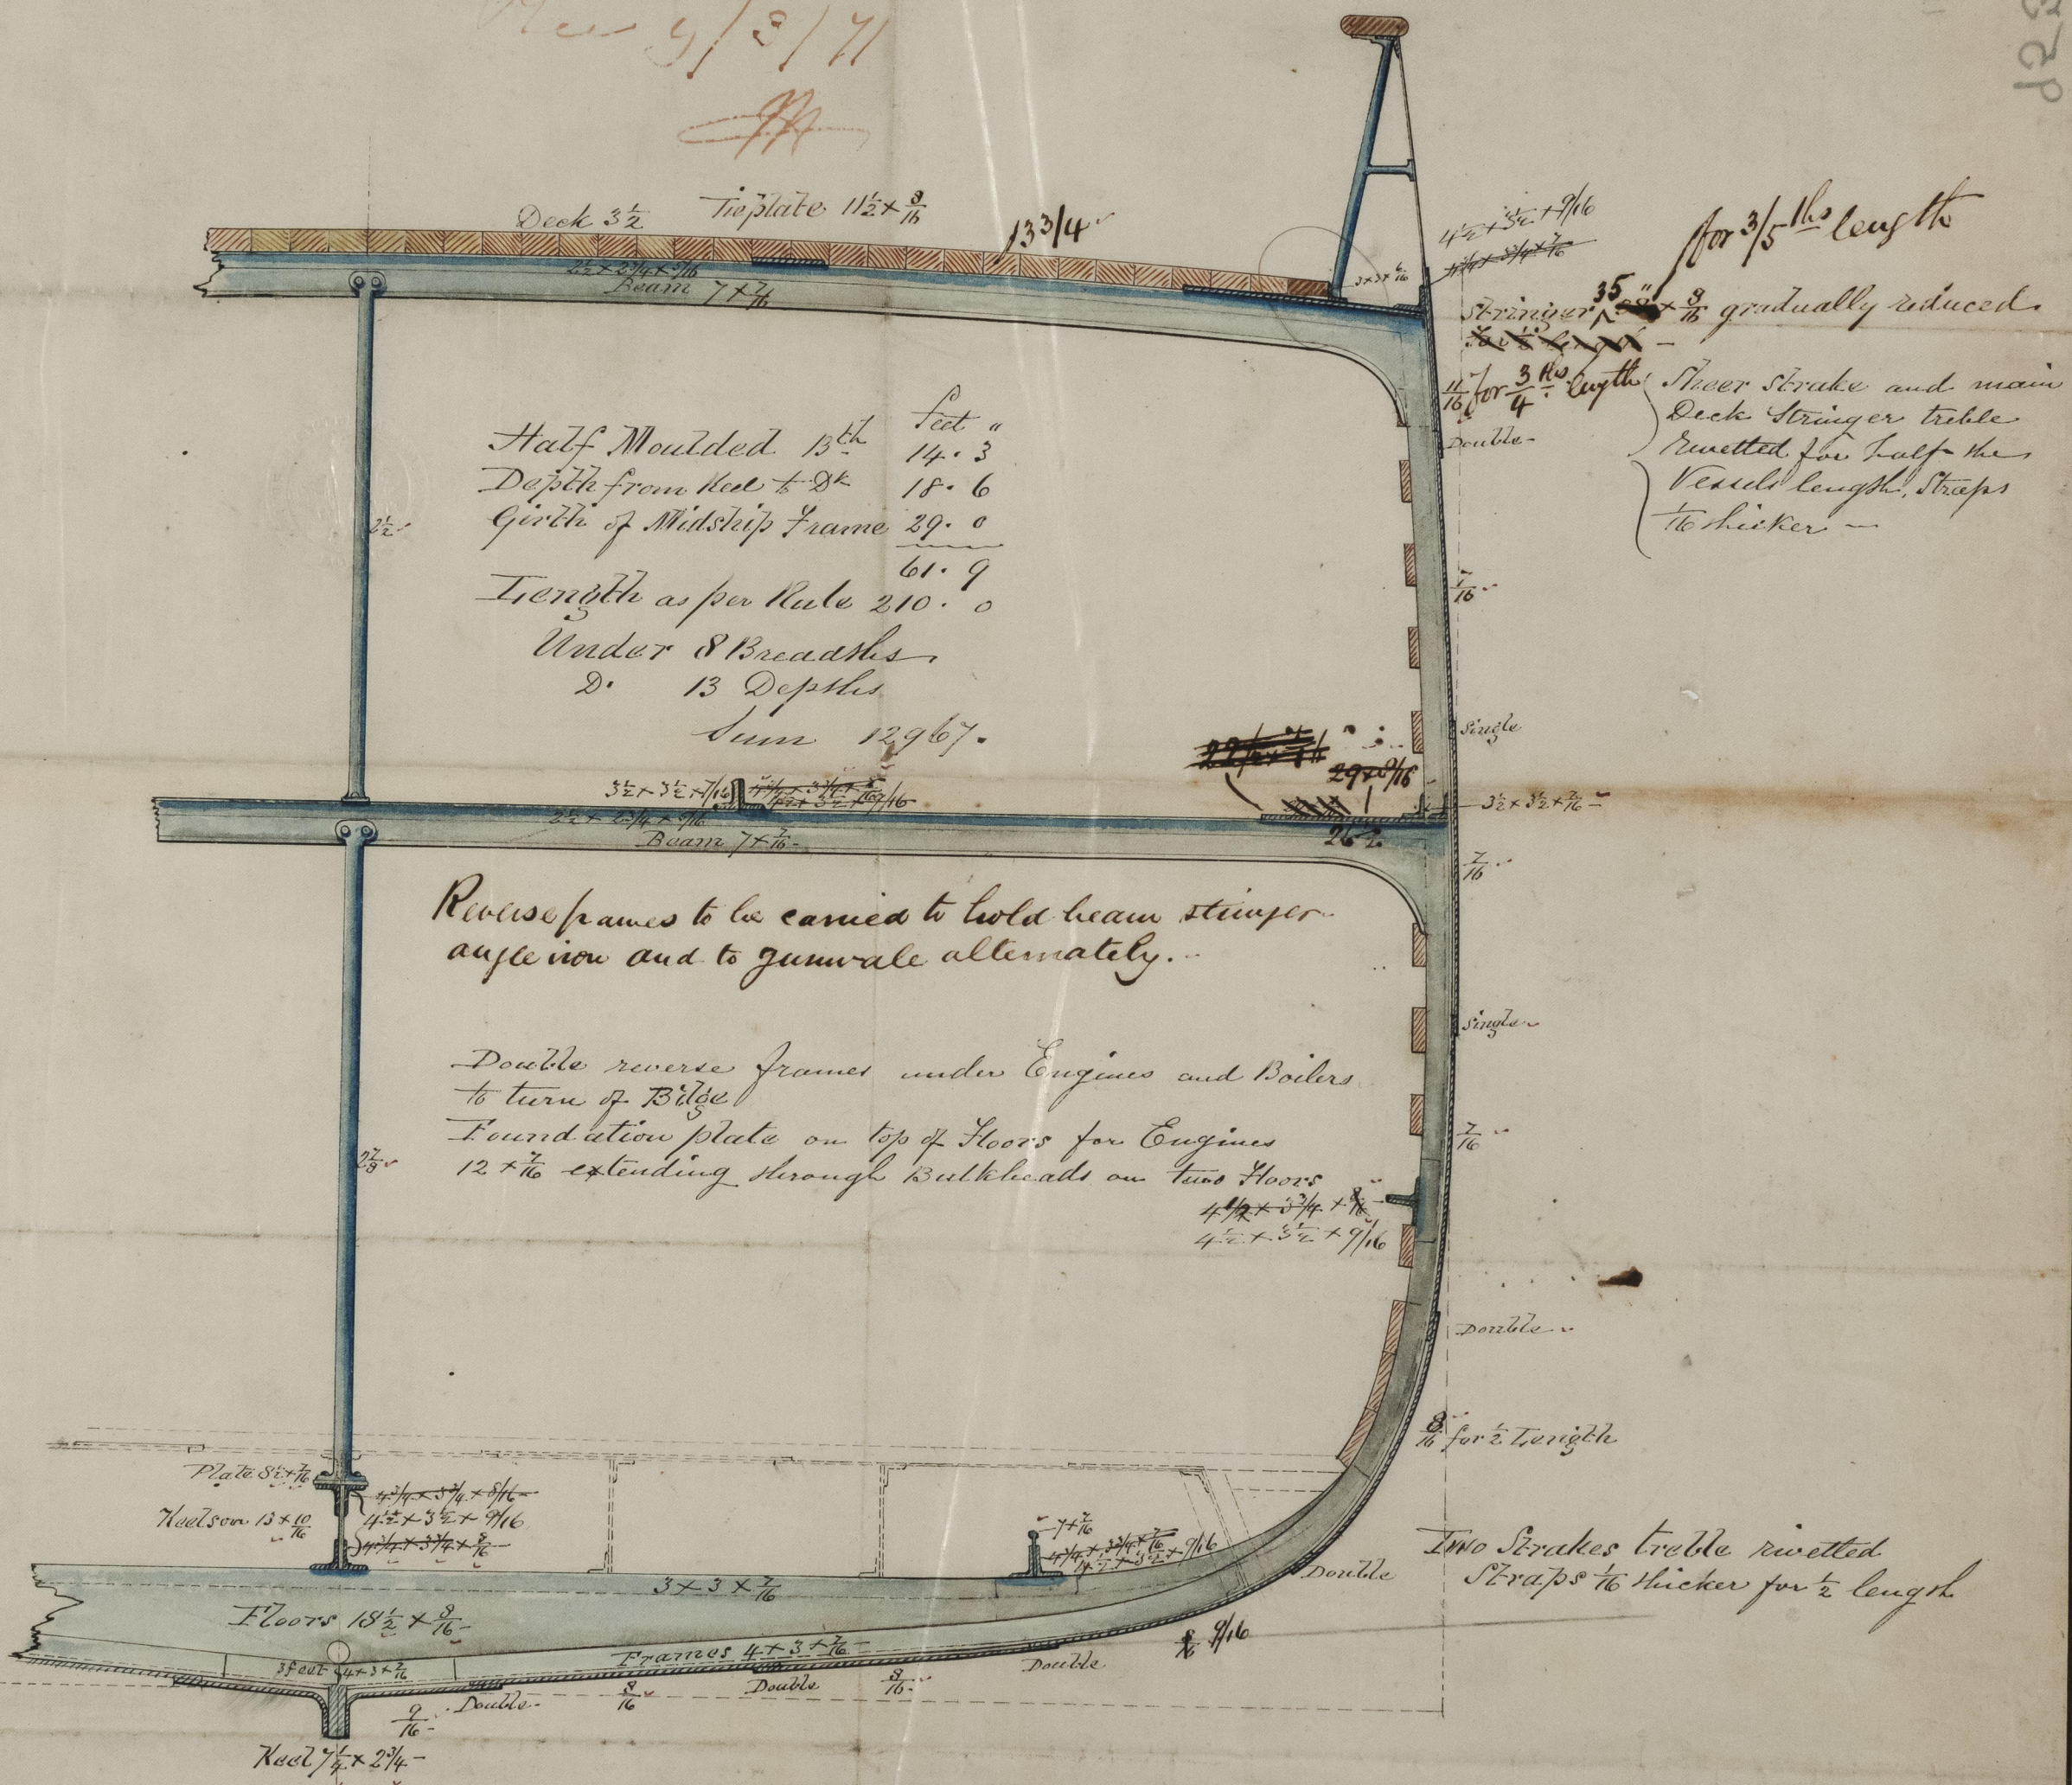

IRON 504 - 0240









24

[Faint handwritten notes, possibly bleed-through from the reverse side.]




