

Length 243.25

Depth Hold

Breath Moulded

24-3-24 2 1/2 to top of floor.

Hals Gurth 40.5

Dep'th. 26.5

Half Breadth 19.95

86.95 = Número

Proportions Breadths 6.9

Depth 10.

$$86.95 \times 243.25$$
$$= 21,150$$

do.


Midship. Section at C^r of length.

Rec 18/2/71

N^o 219

Barclay & Co.


Scale $\frac{1}{2}$ Inch = One foot.

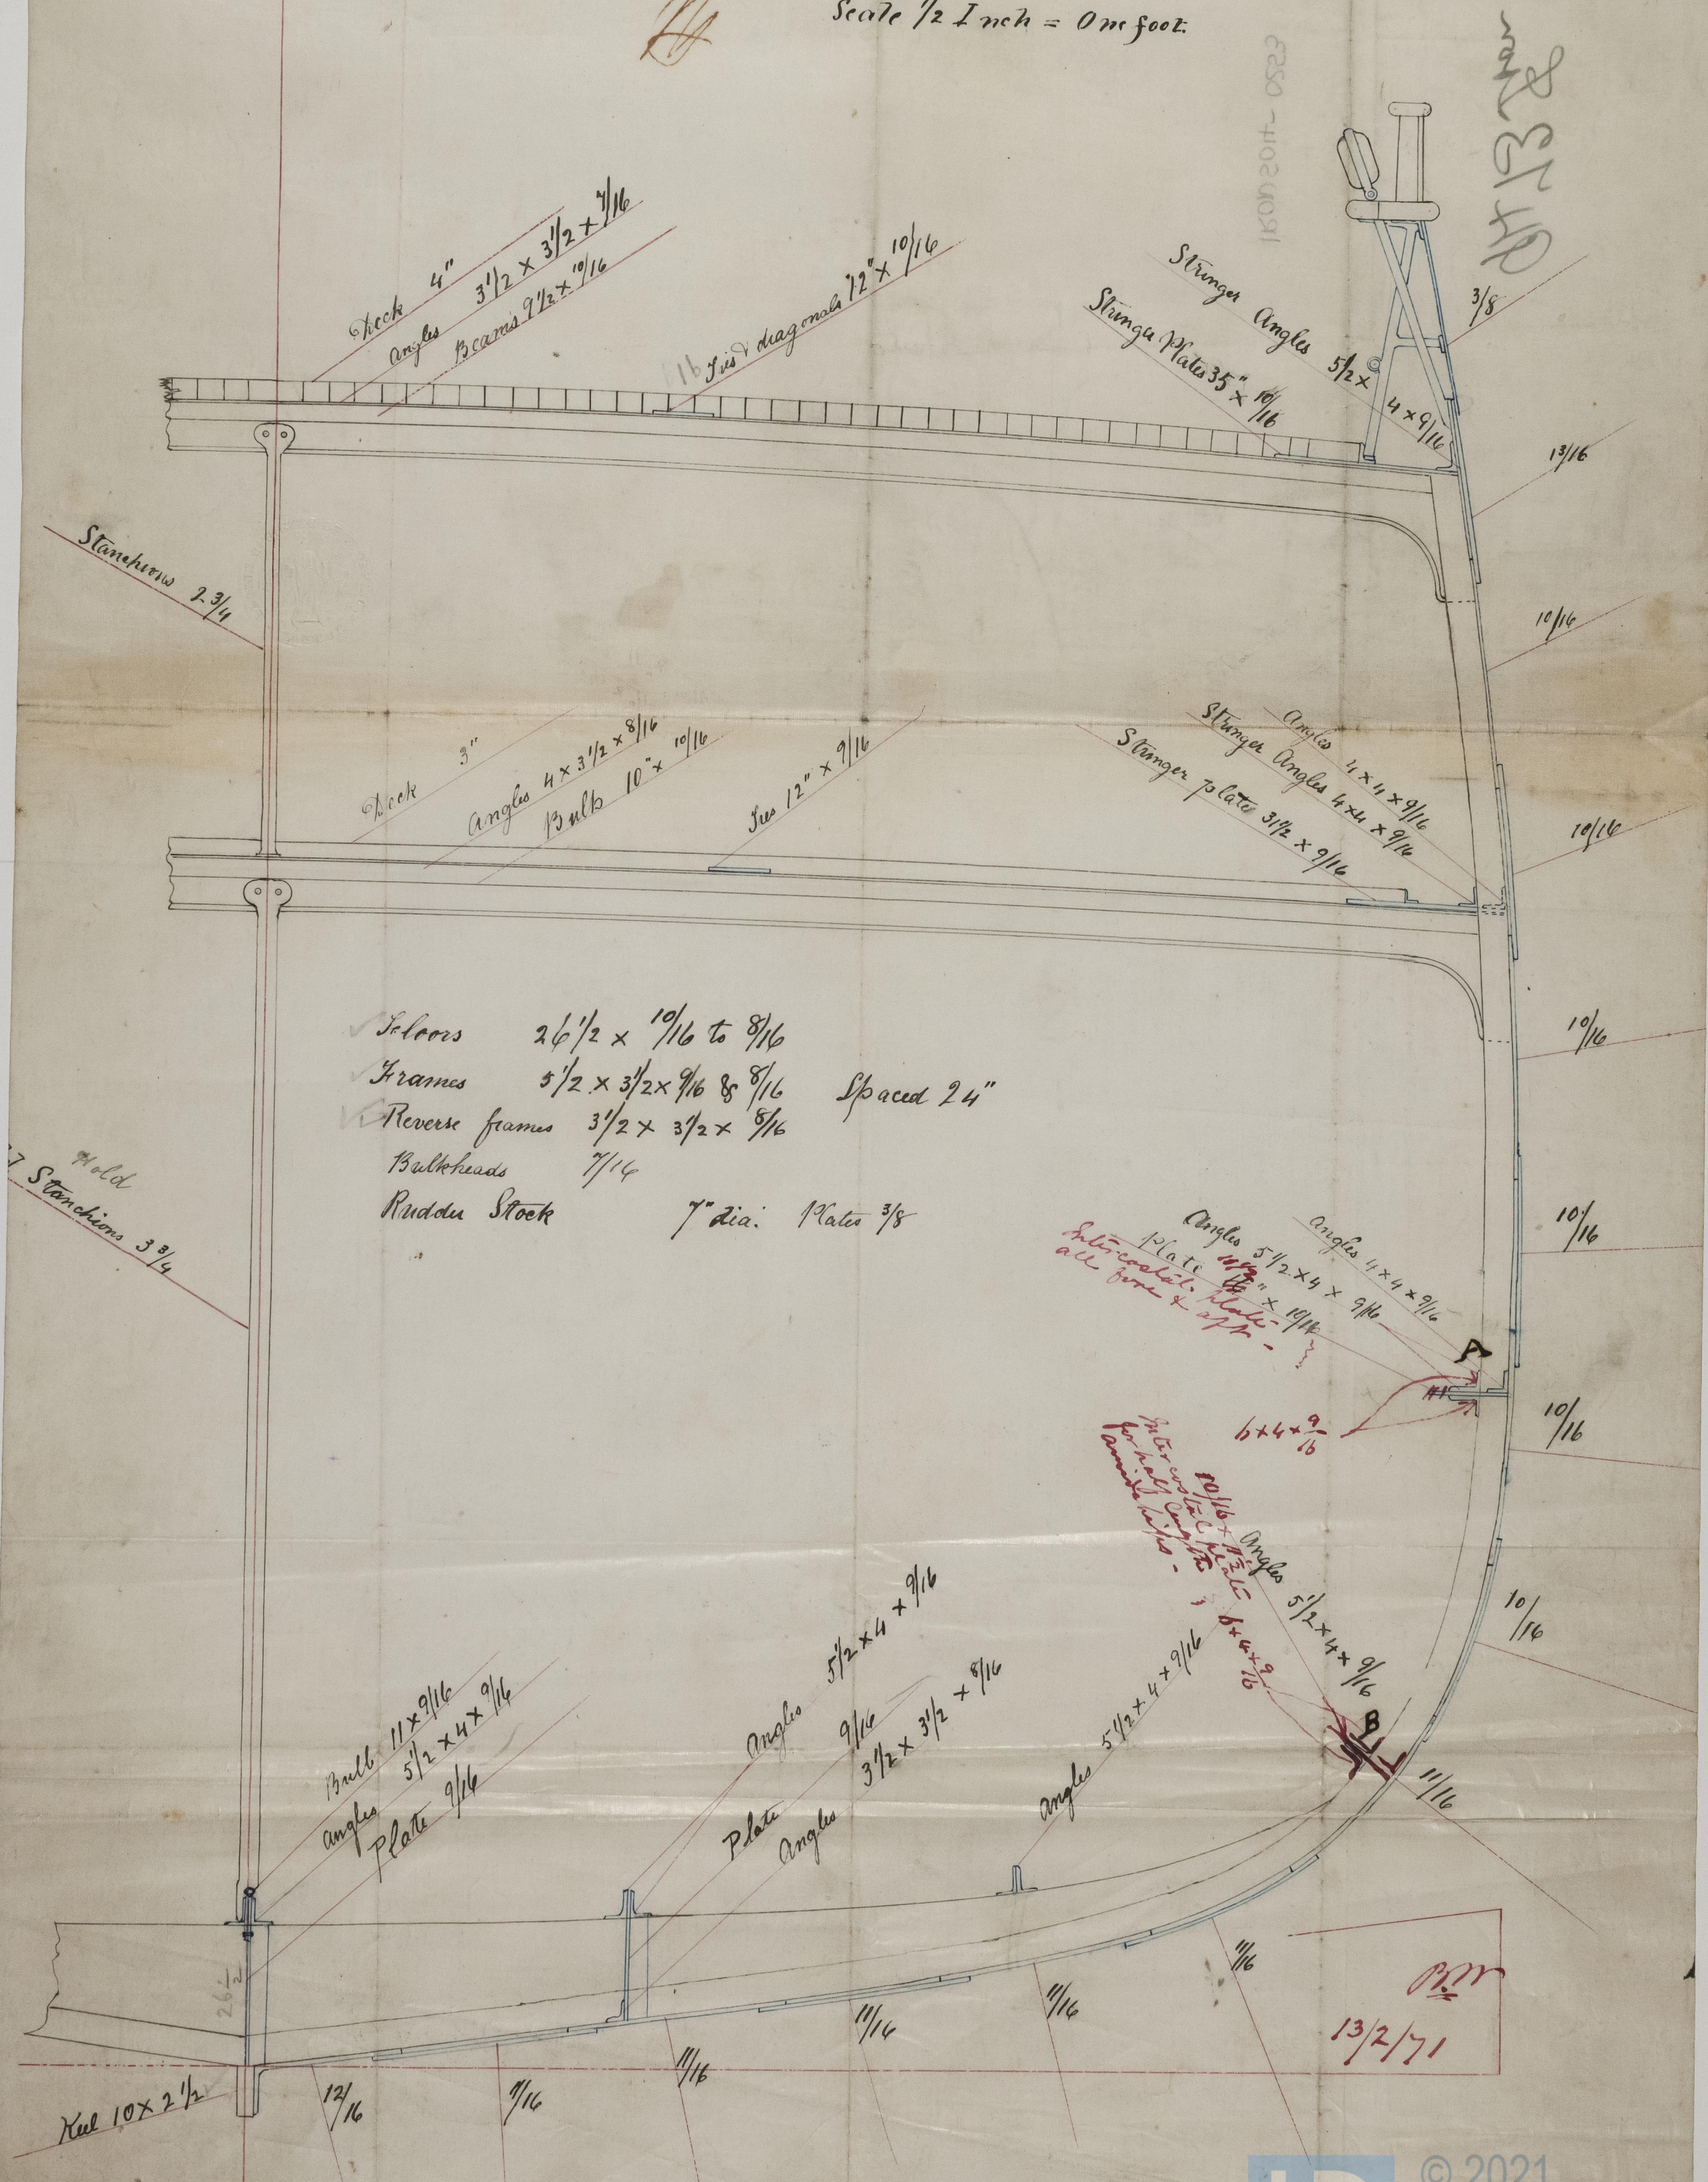

[illegible]

Handwritten: 1800

166



IRON SO₄ - 0253

500 fms = 400 1/2 fms

22nd Nov 1912







John Wapell

16/10/19
N/C available 2

(Faint handwritten notes in red ink, possibly bleed-through from the reverse side of the page.)

13/5/22


11/11

