


3rd May 1871

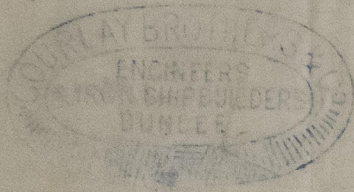


MIDSHIP SECTION

SCREW STEAMER N^o 53
Scale $\frac{3}{4}$ " = 1 Foot

Dimensions
Length of keel & fore rake 235 Feet
Breadth Moulded 30 "
Depth do 19 " 3 inches
Depth in hold to floor 18 " 2 1/2 "
Frames spaced 28 inches apart

Rec 6/5/71
H

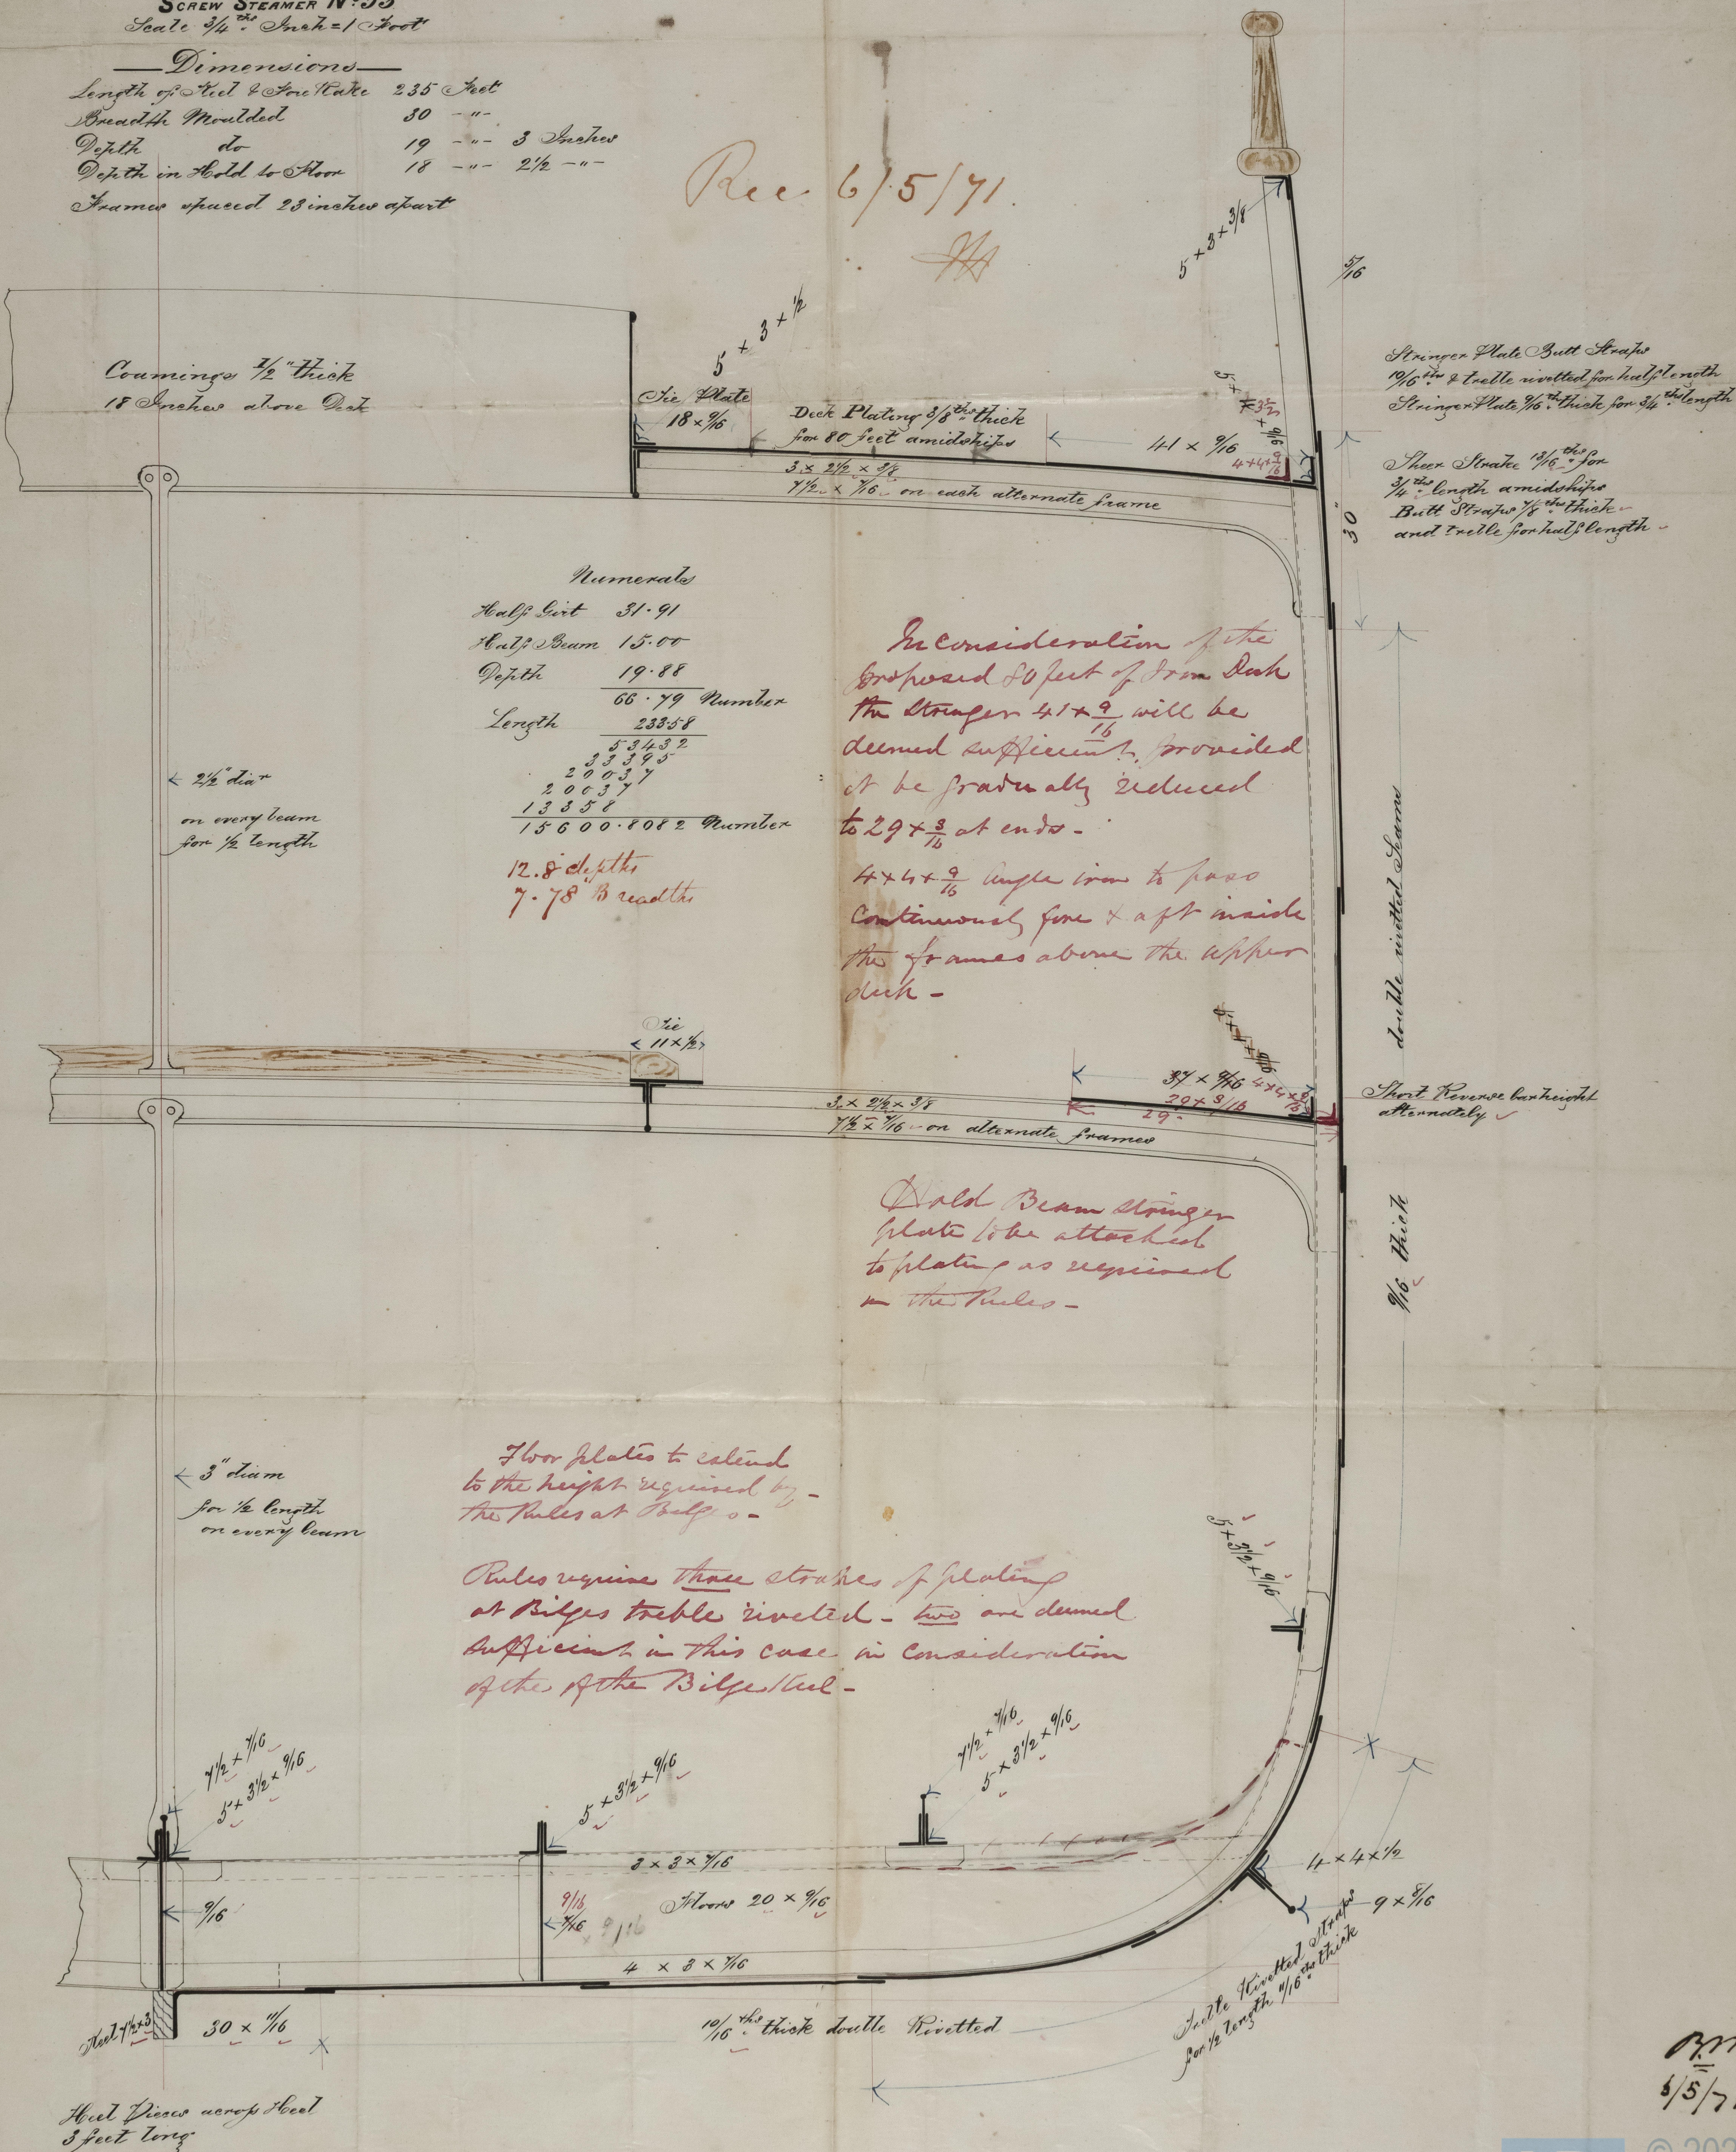

AM
5/5/71