


Report No 3026
J.S. "Maud"

Midship Section
of
No 123. S.S.

Rec 5/5/71

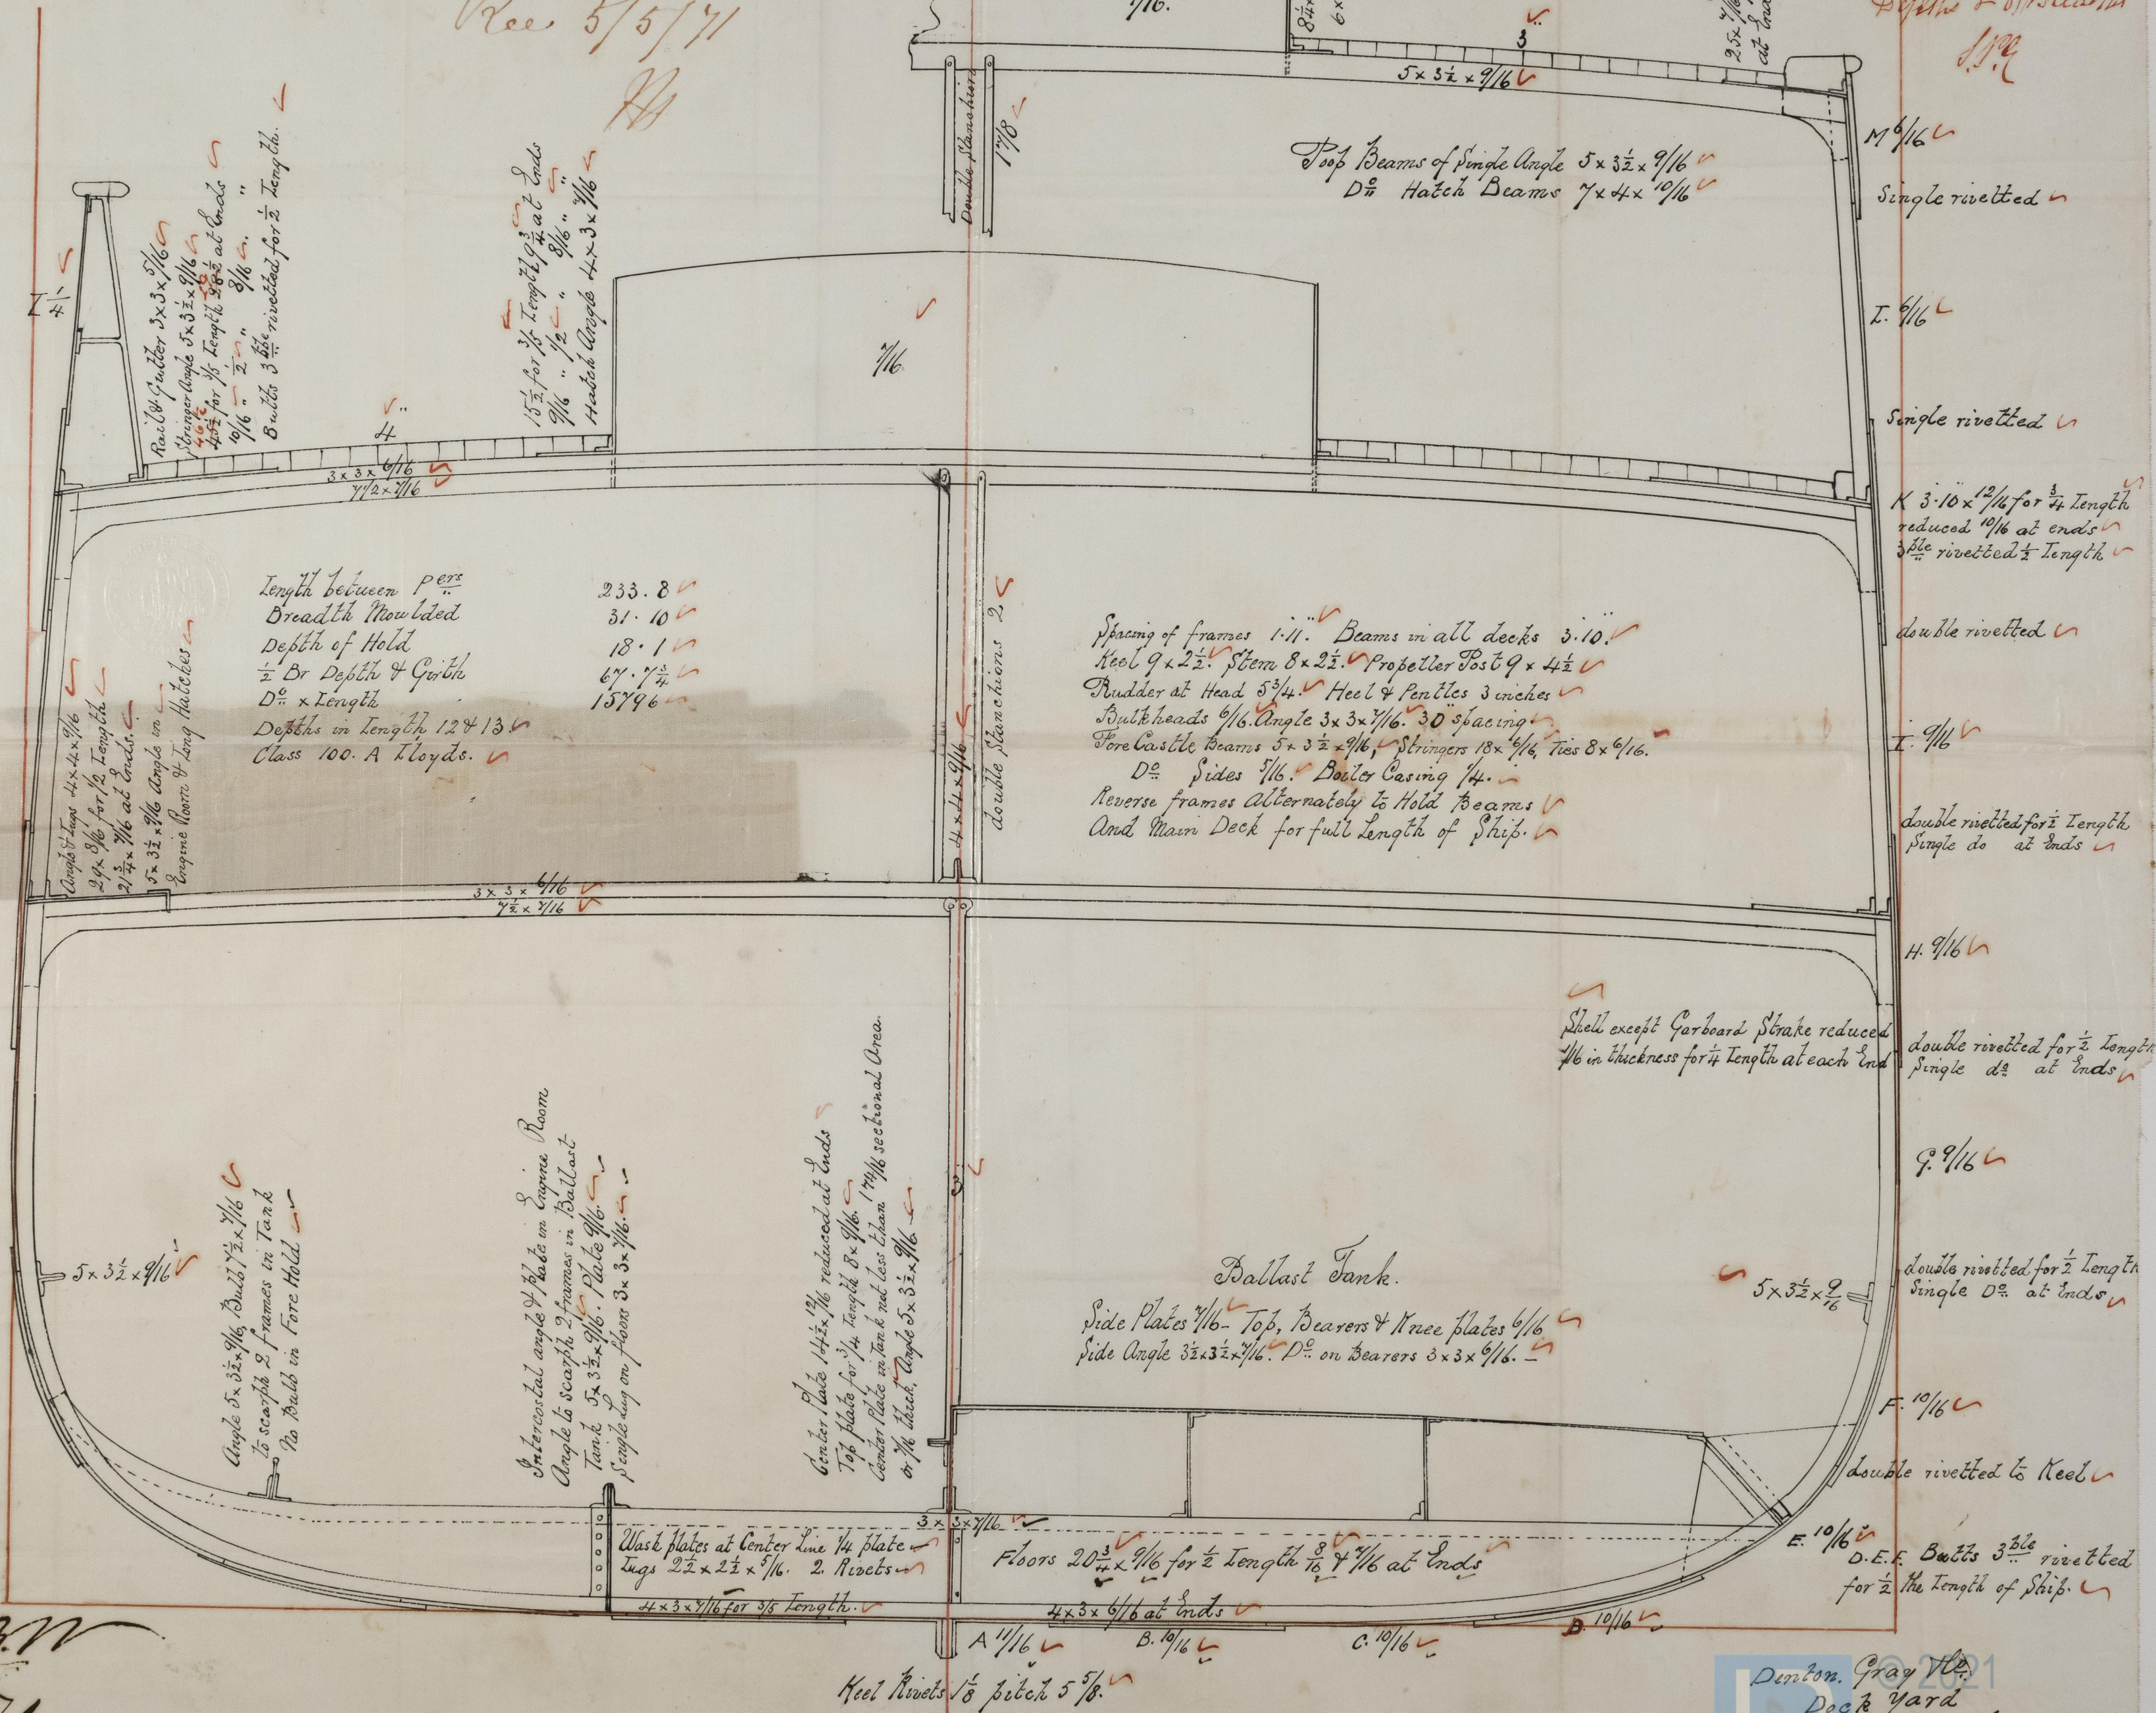

5/3/71