

24  
Toward

Length  $218.8 \times 59.0 = 12.909$


Length 218.8

Breadth 28.5 = 7.67 Breadths

Depth  $13.7 = 13.9$  Depths



St. J. 15/3/71

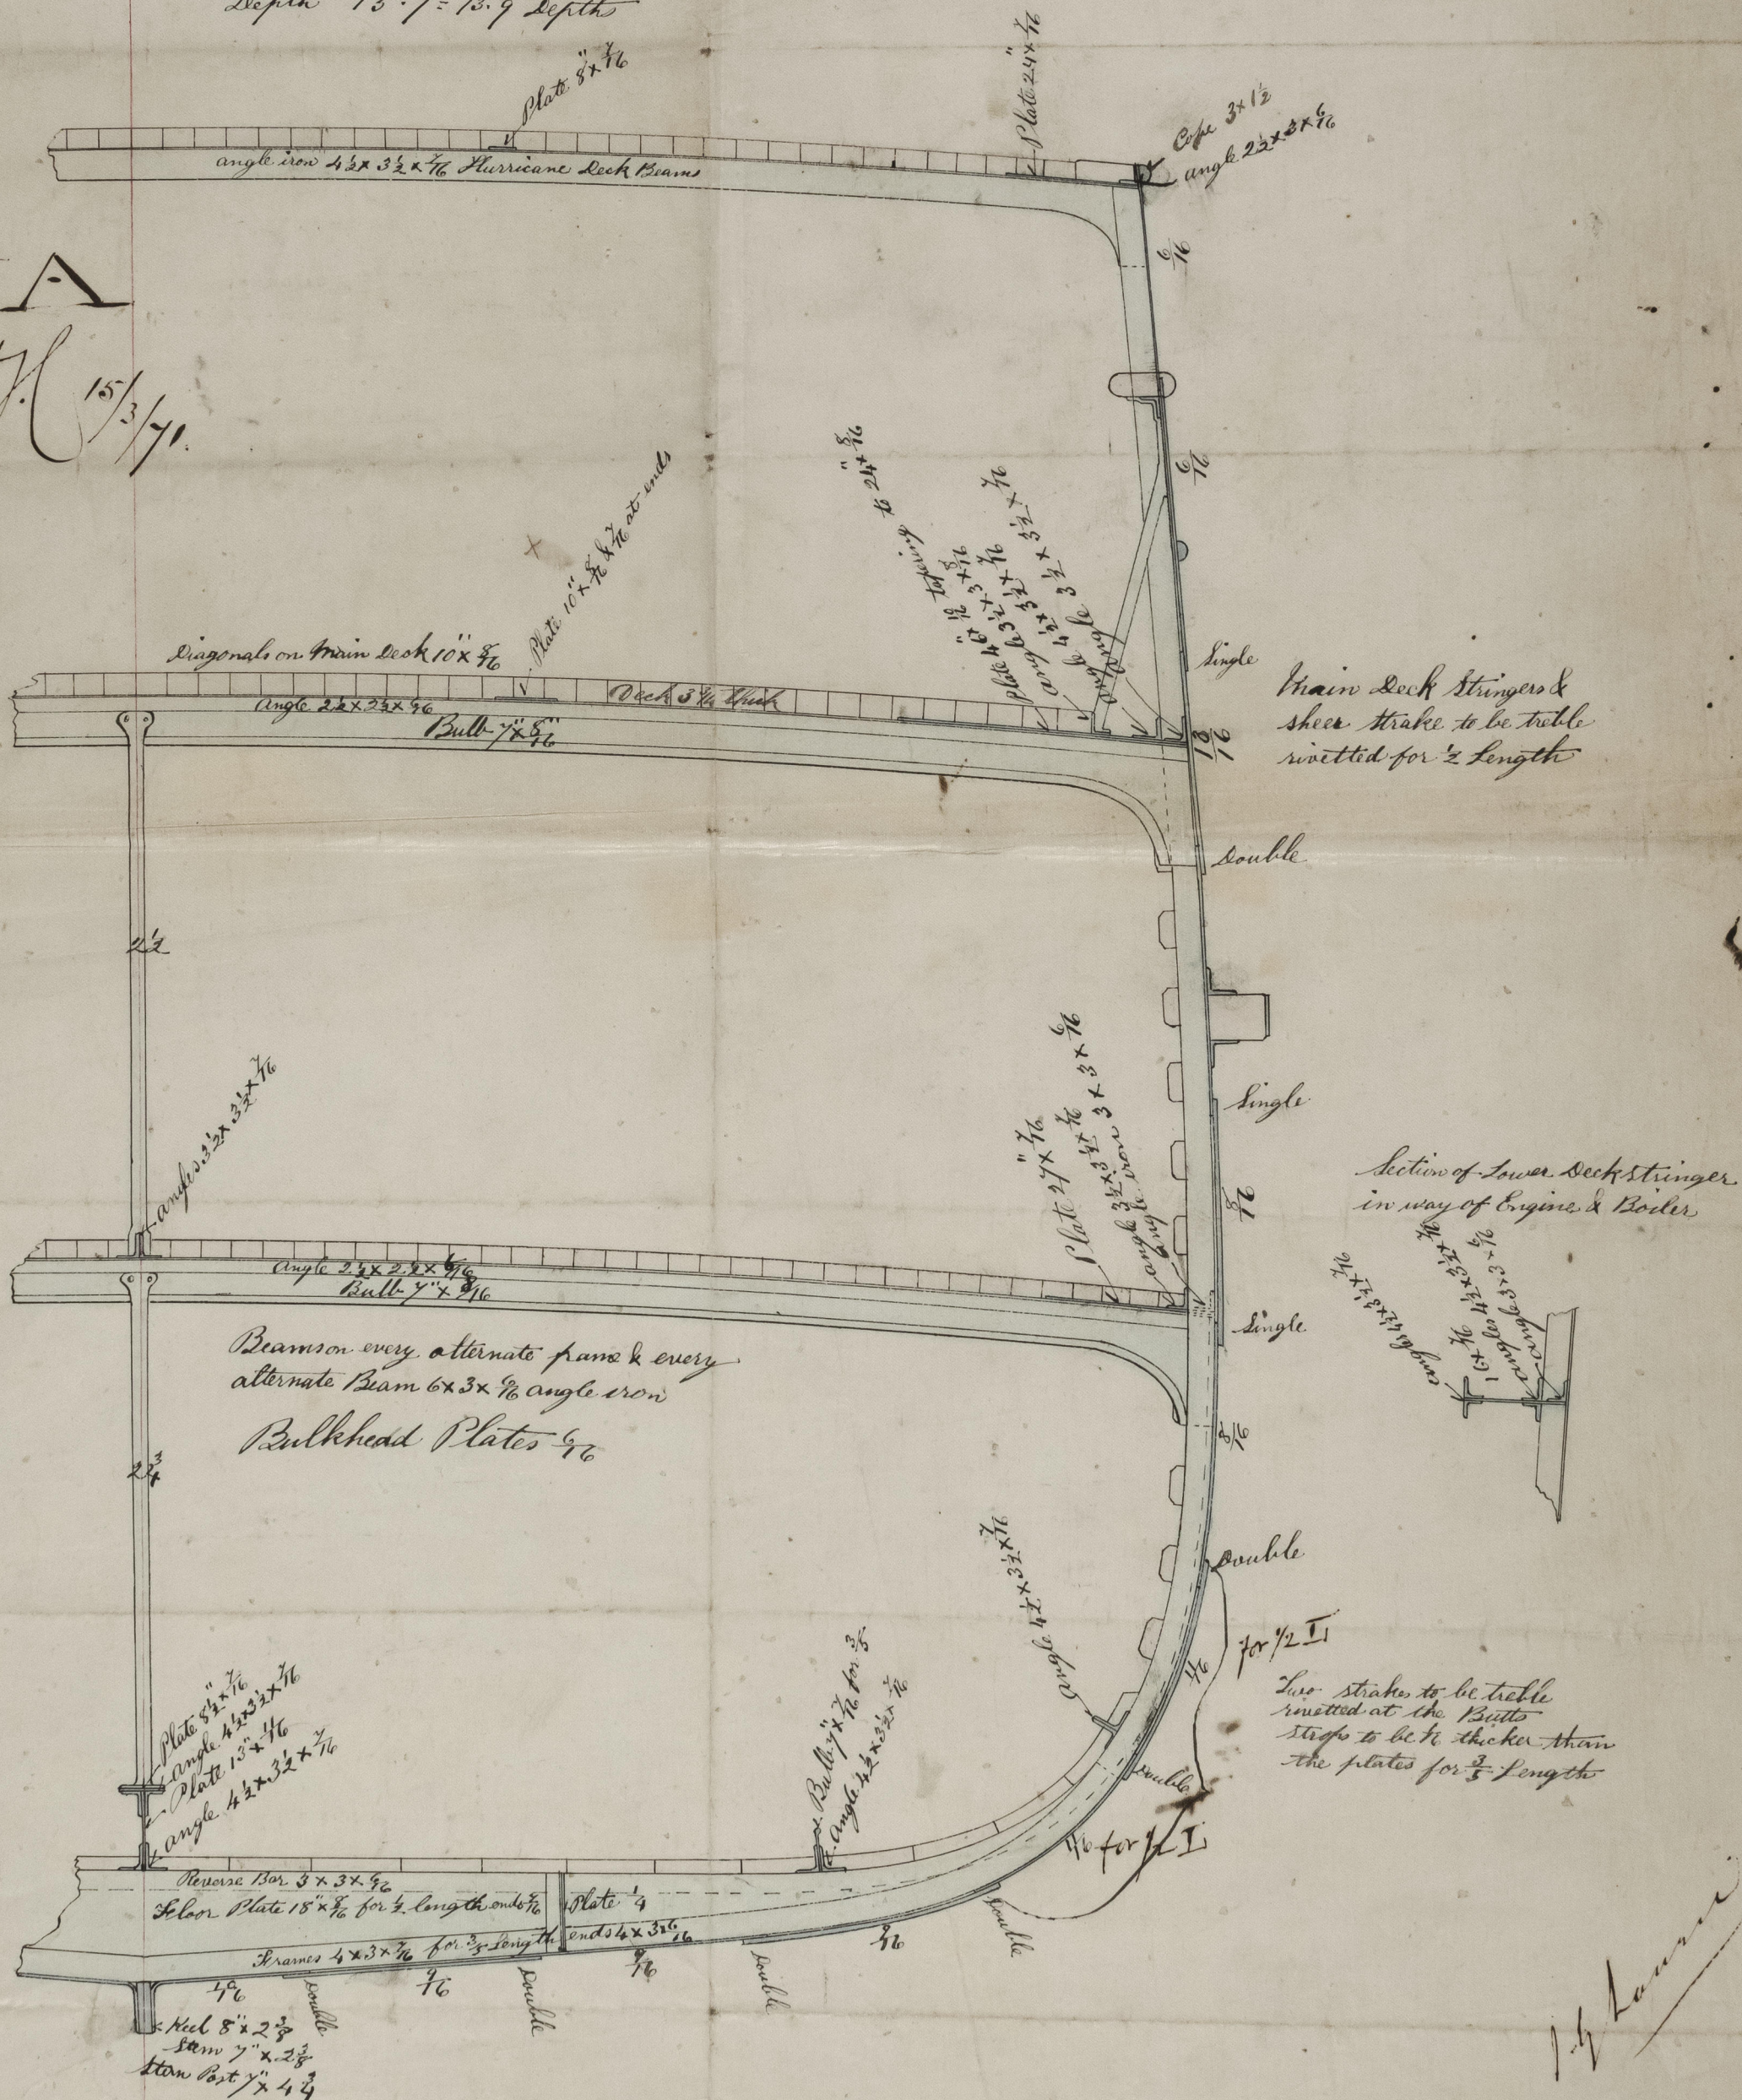

