


"Phetis"

Rec 15/7/11

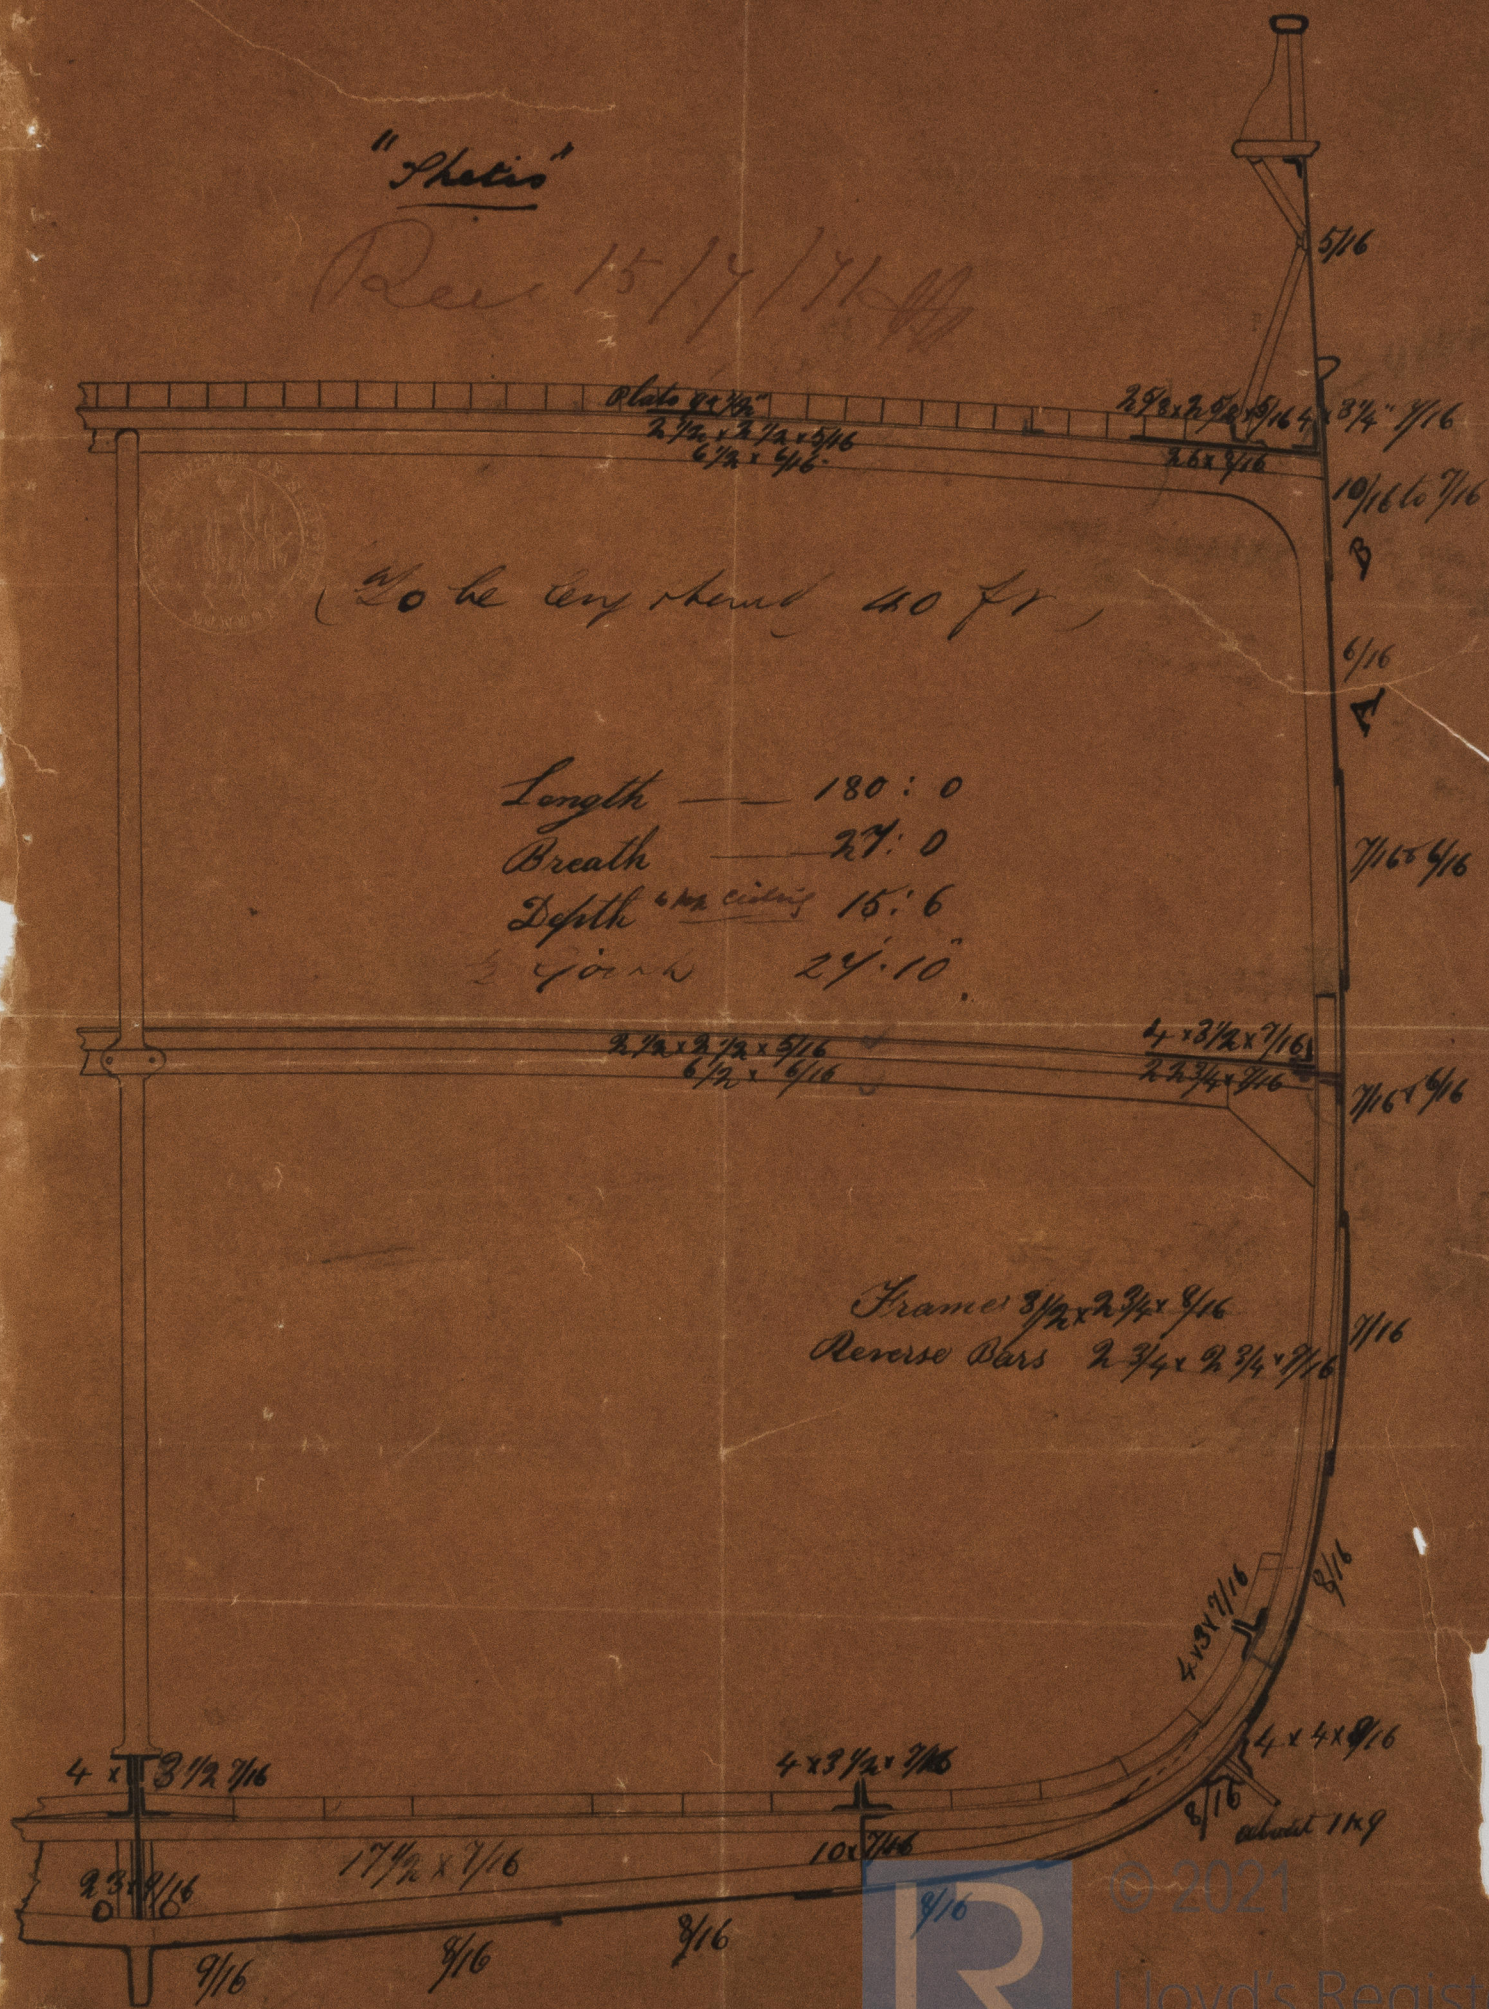

(To be long round 40 ft)

Length — 180 : 0


Breadth — 27 : 0

Depth ^{at keel} 15 : 6

to gun 24 : 10

Frame 3 1/2 x 2 3/4 x 7/16
Reverse Bars 2 3/4 x 2 3/4 x 7/16

17/7/11

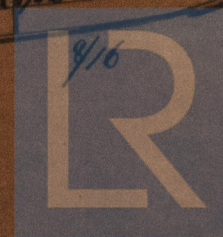

© 2021
Lloyd's Register
Foundation

IRON 504-0332