


Middleton Ship Yard
May 4th 1871

Midship Section of S. S. No 158 - Parnassus
Length per rule 248.5 x 33.5 x 24.0 to spar deck
Nos $\frac{67.14}{18,698} - \frac{81.16}{22,597}$ Depths 11.6 & 16.3 Breadth 8.3

Class 100 A, 3 Deck Steam vessel for Cargo

Scale 1/2 inch

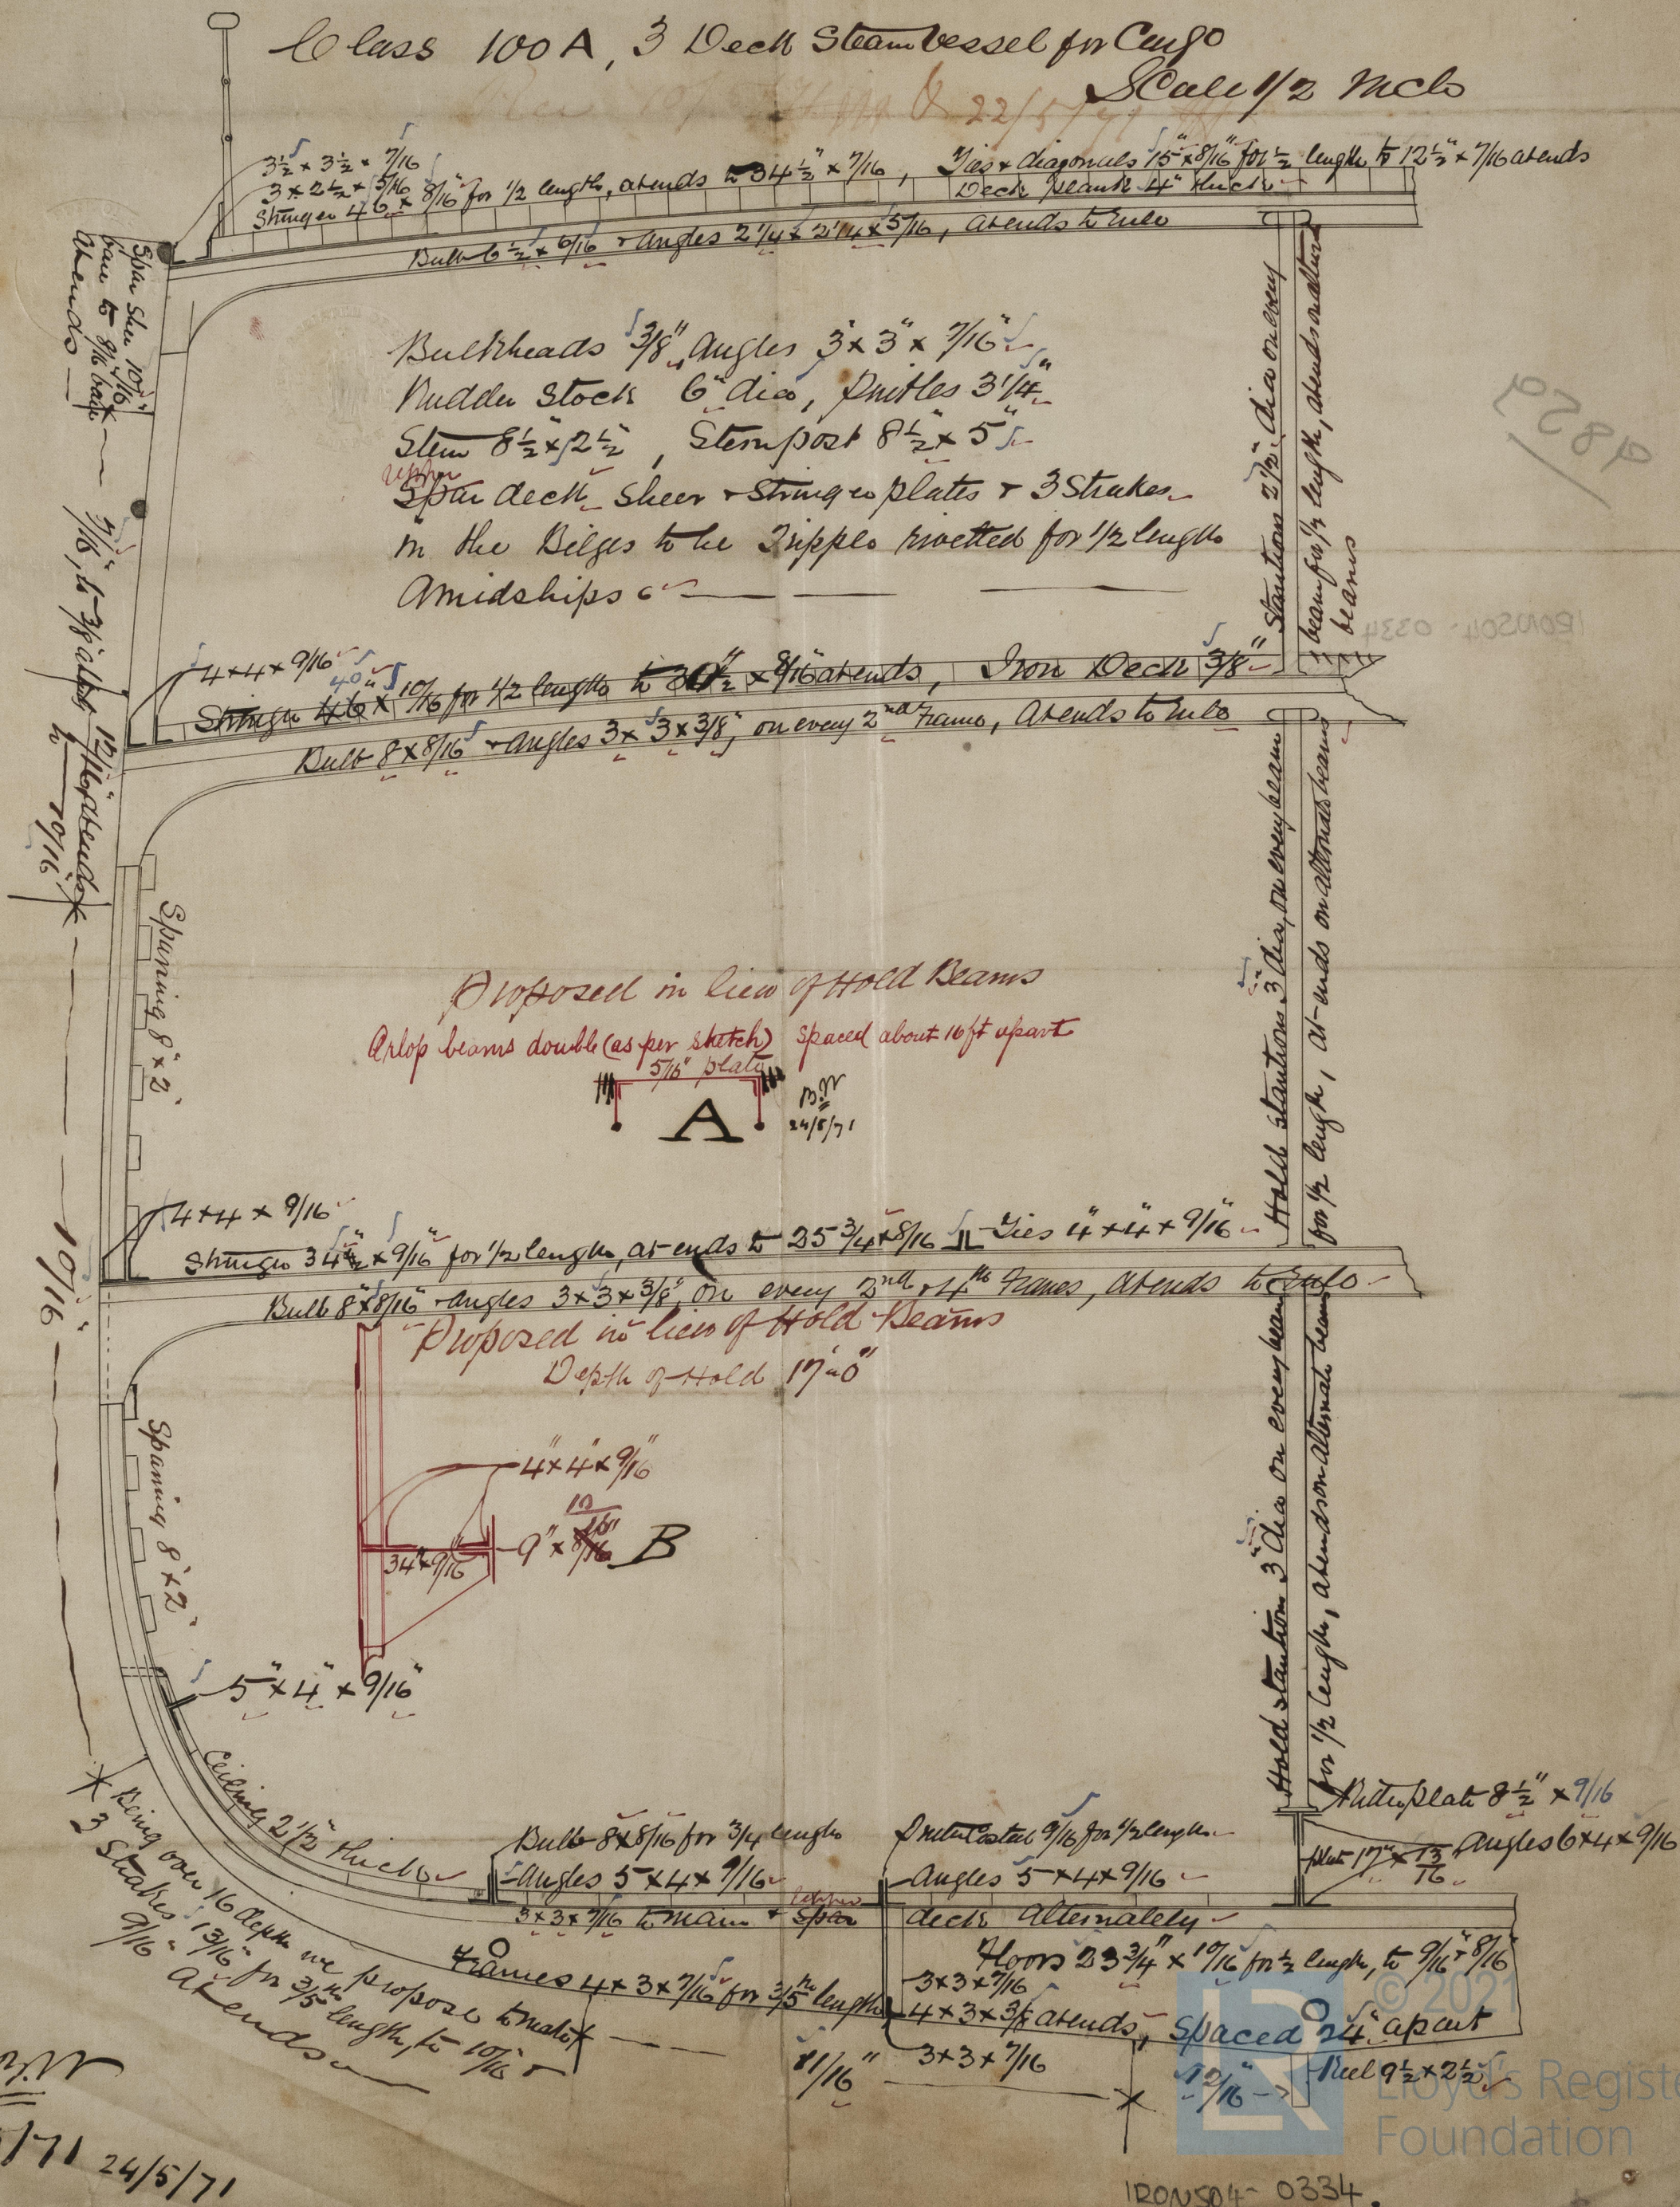

$$\begin{array}{r} 18,098 \\ 67.14 \\ \hline 201,871 \end{array}$$

$$\begin{array}{r} 201,871 \\ 20.5 \\ \hline 4,138,426 \end{array}$$

[illegible]




1870
 1871
9859

IRONSOL-0334



(Faint handwritten notes and calculations, possibly related to the survey or map.)