


9945 Iron S.S. Adelaide, as lengthened.

Forecastle stringers 18. 7/16
 " " 6. 1/16
 " Beams - 3 + 2 1/2 + 7/16

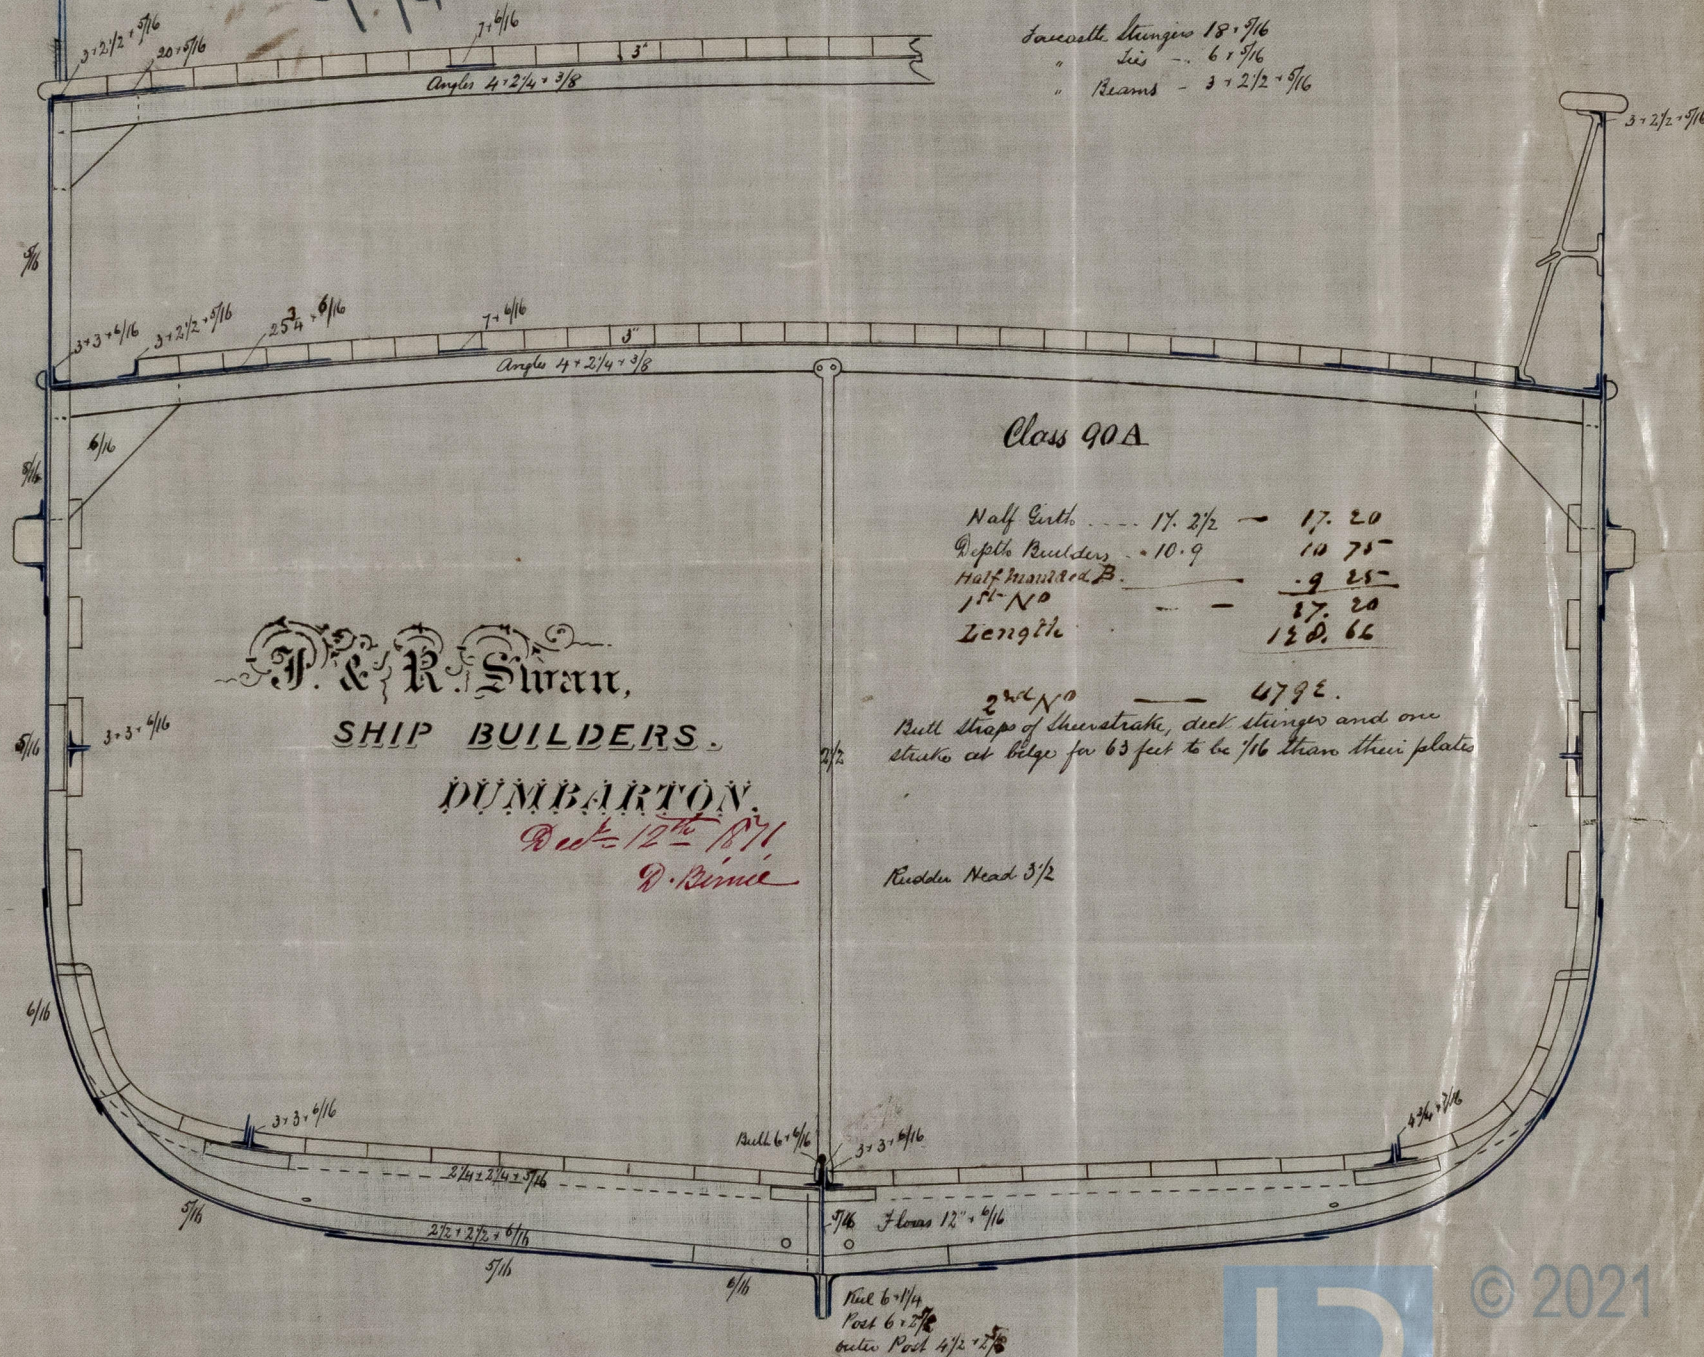

J. & R. Swan,
SHIP BUILDERS,
DUMBARTON.
Built 12th 1871
D. Rennie

Class 90A

Half Girth	17. 2 1/2	17. 20
Depth Builders	10. 9	10. 75
Half main and B.		9. 25
1st No		17. 20
Length		120. 66

2nd No 479E.
 Built sharp of the strake, deck stringers and one
 strake at bilge for 63 feet to be 7/16 than their plate

Rudder Head 3 1/2



© 2021

Lloyd's Register
 Foundation