


Midship Section

Run 1872/69

9957 tons

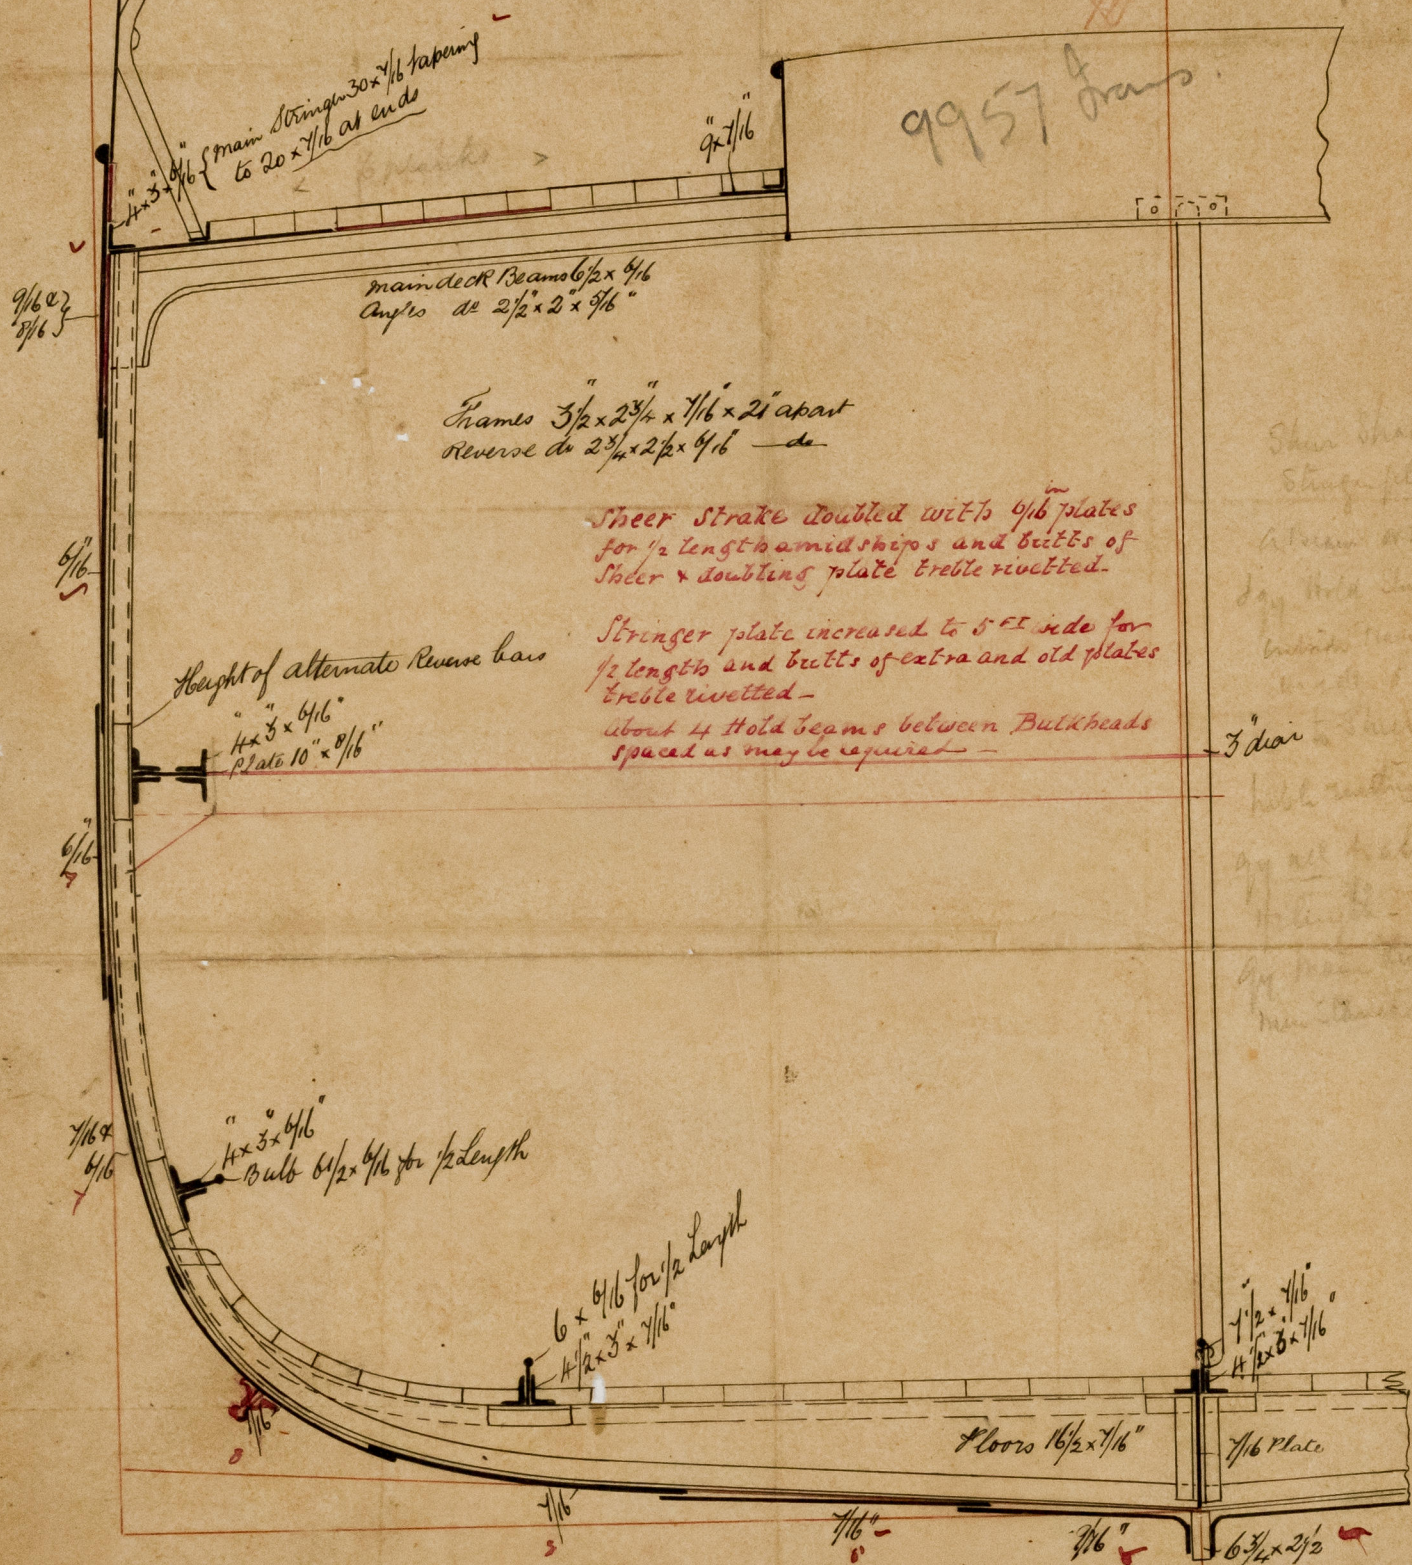

Sheer Strake doubled with 7/16 plates for 1/2 length amidships and butts of sheer & doubling plate treble rivetted.

Stringer plate increased to 5 ft wide for 1/2 length and butts of extra and old plates treble rivetted -

about 14 Hold Beams between Bulkheads spaced as may be required -

Sheer Strake
Stringer plate
Alt. beam at bow
Qty Hold Beams
Between main & bulk
main & bulk
3' dia
bulk head
Qty all hold
main & bulk
main & bulk

Scale 1/2 inch to a foot

$$216.6 + 25 + 44.3 = 8.66 = 15.2$$

To be lengthened 3' 6" amidships.
Increased Tonnage under main

S. S. "Vine"

IRON 505-0024

Dimensions at present

Length on load line	185
Breadth of beam	25
Depth in hold	14

1872 69