


S.S. Agnes Louisa
Report Number 3060


No. 22 S.S.

Length R.P.	185.0	✓
Reddish Cakeworm	28.6	✓
Moalddid	28.4	✓
Depth	16.9 1/2	✓
in hold & floor	16.0	✓
Class 90 A		✓

Rev 25/3/41.

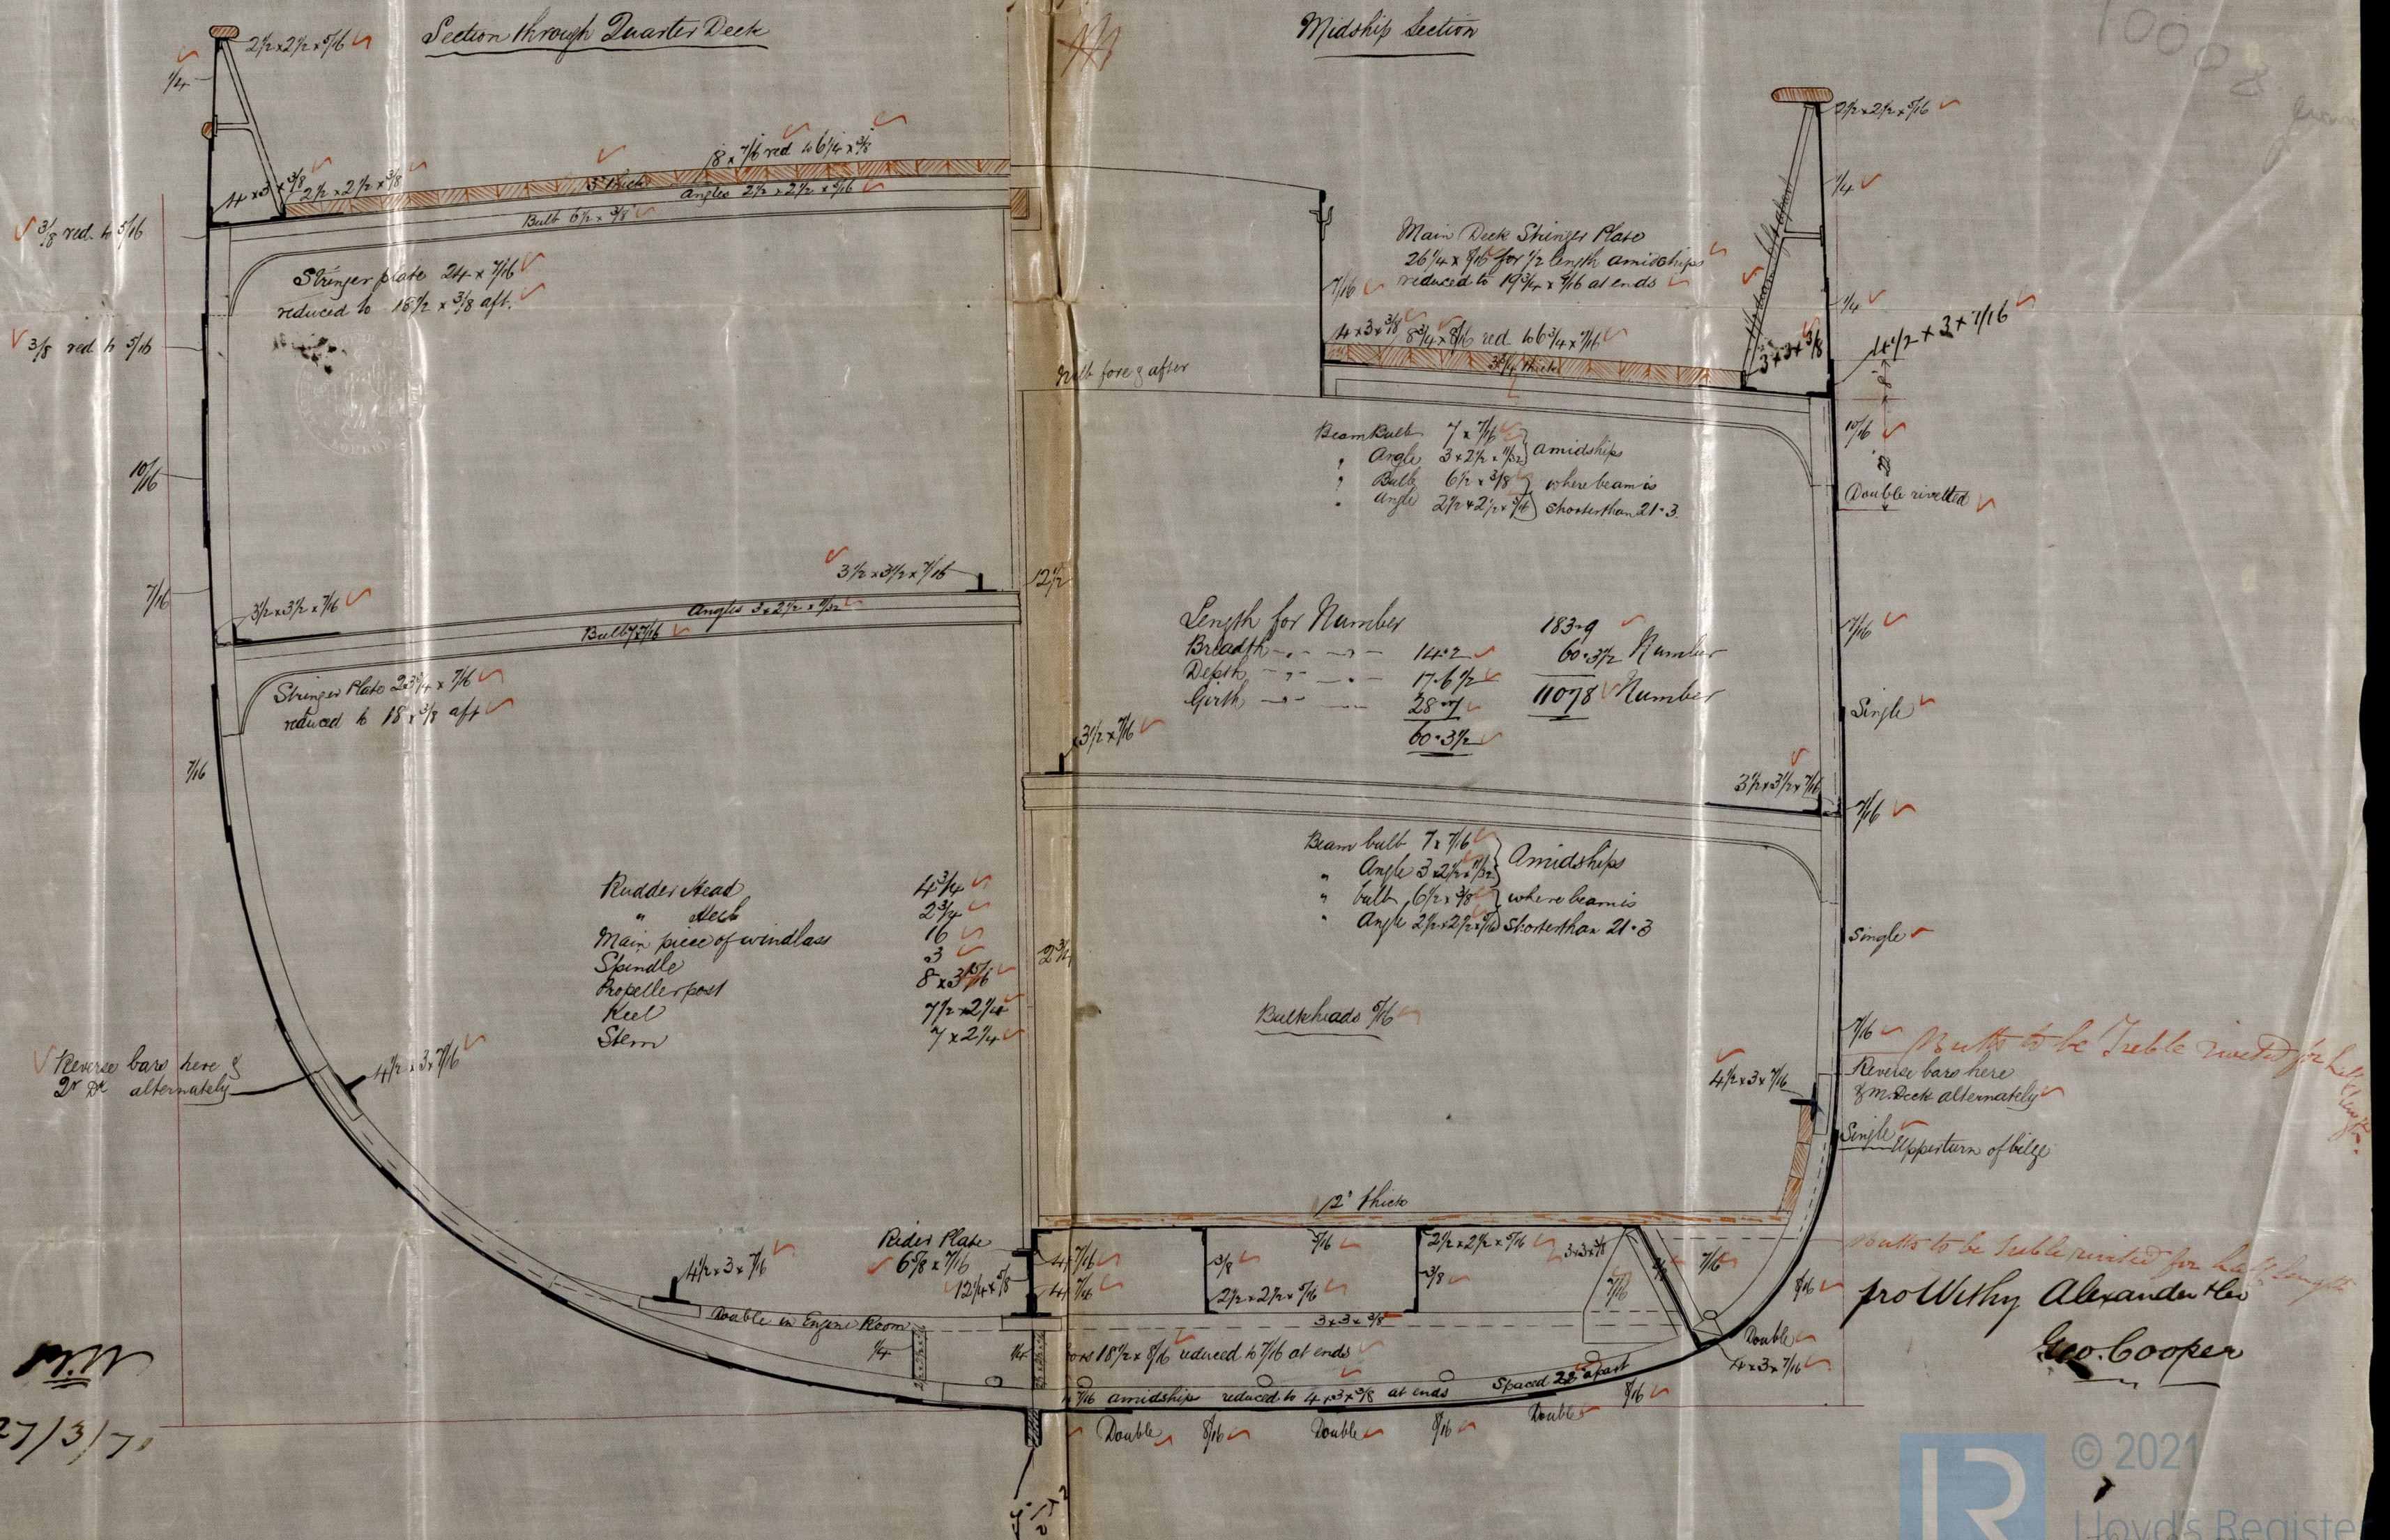

27/3/71

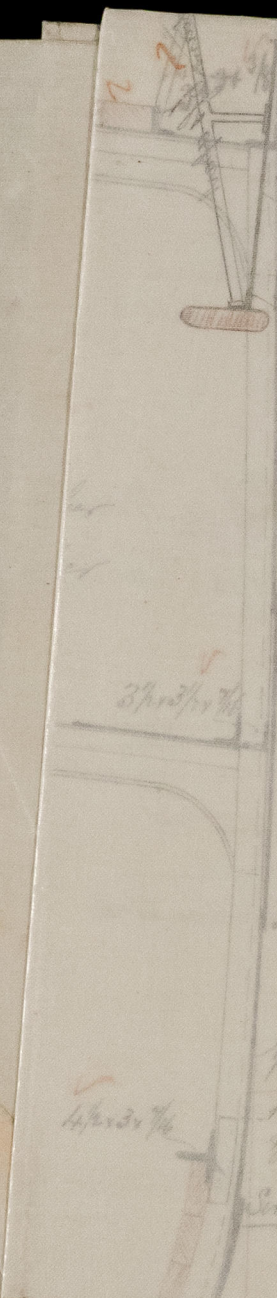

10008. Irons

IRONSOS-0041


Single

Handwritten in red ink:
 11/16
 15 2/16

Single

Handwritten in red ink:
 11/16 - Matt to be Suble printed
 Reverse bars here
 of m. back alternate

Single
 Apertures of legs

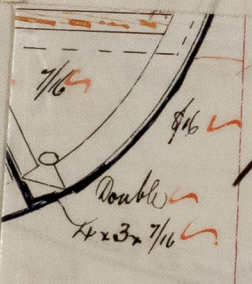

Handwritten in red ink:
 Balls to be Suble printed for half length
 pro Withy Alexander Es
 Geo. Cooper



© 2021

Lloyd's Register
 Foundation