


S.S. "Agnes Louise"
Report No. 3060

N^o 22 S.S.
1/4 scale

Rec 25/3/71
JH

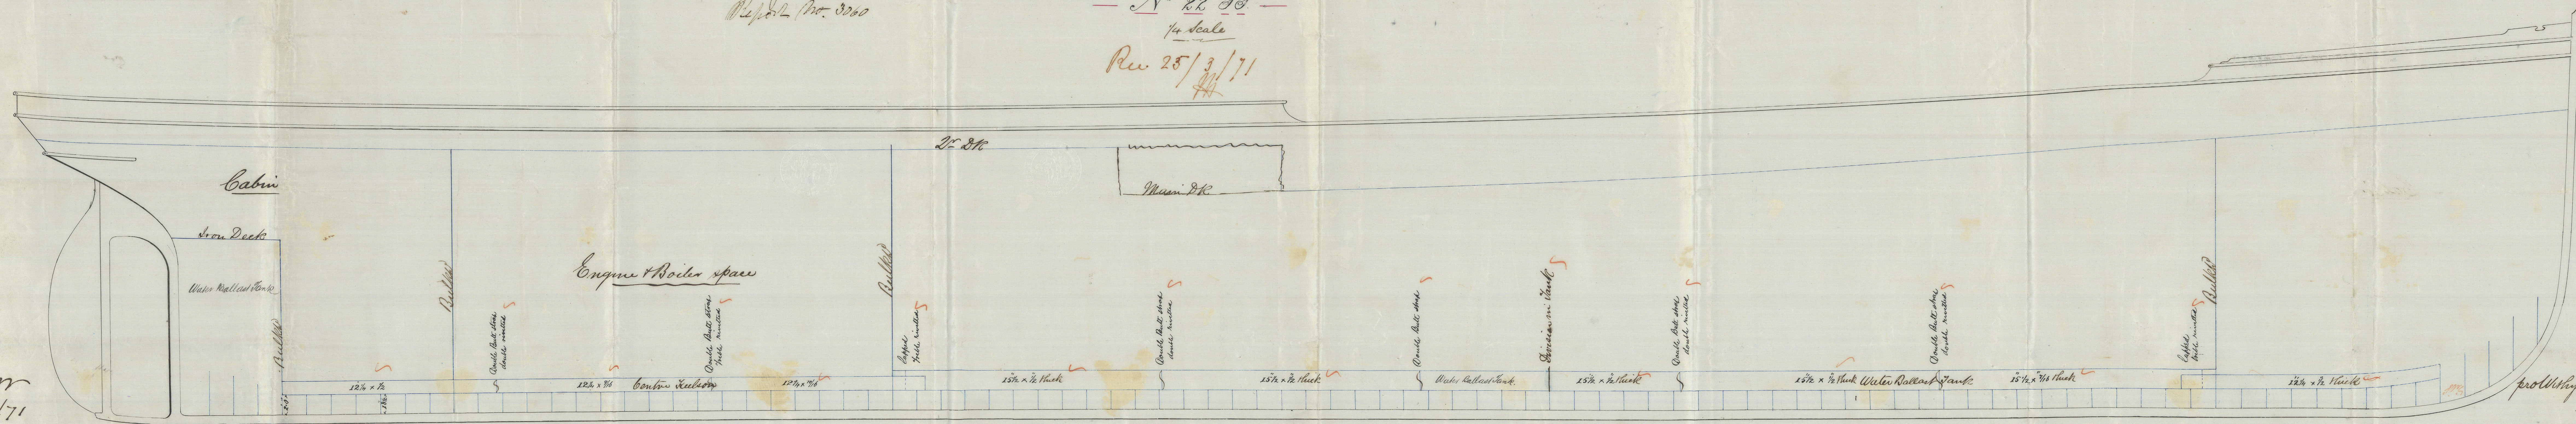

B.M.
27/3/71

prod. Wm. Alexander & Co.
