

Report No. 3061 S. S. Albatross

# MIDSHIP SECTION

Nº 117SS

SCALE 1/2 INCH TO THE FOOT

225'0" x 28'0" x 24'3"

Length from inside of Stem to Fore part of post 223'9"  
Breadth extreme 28'0"  
Depth of Lower Hold 17'3"

Living Deck all Fore & Aft  
Water Ballast in After Hold & partially in Fore  
Classed 90 ft at Lloyd's  
Over 11 depths and 4 breadths

Girls 29'3"  
Depth 18'8 1/2"  
Beam 14'0" 5/8"  
67' 11 1/2" = 224' 138 7/16"  
65' 13'00"  
65' 14'300"

Rec. 157/1/71 & 11/15/71  
H. Rec. 20/2/72



Edges single riveted

Double riveted throughout the longitudinal seams

17 feet

Main Bulk of upper deck beam stringer plates consist of two strakes of plate round the bilge to be 1/16" thicker than the plates they connect and treble riveted for 1/2 the vessel's length amidships.

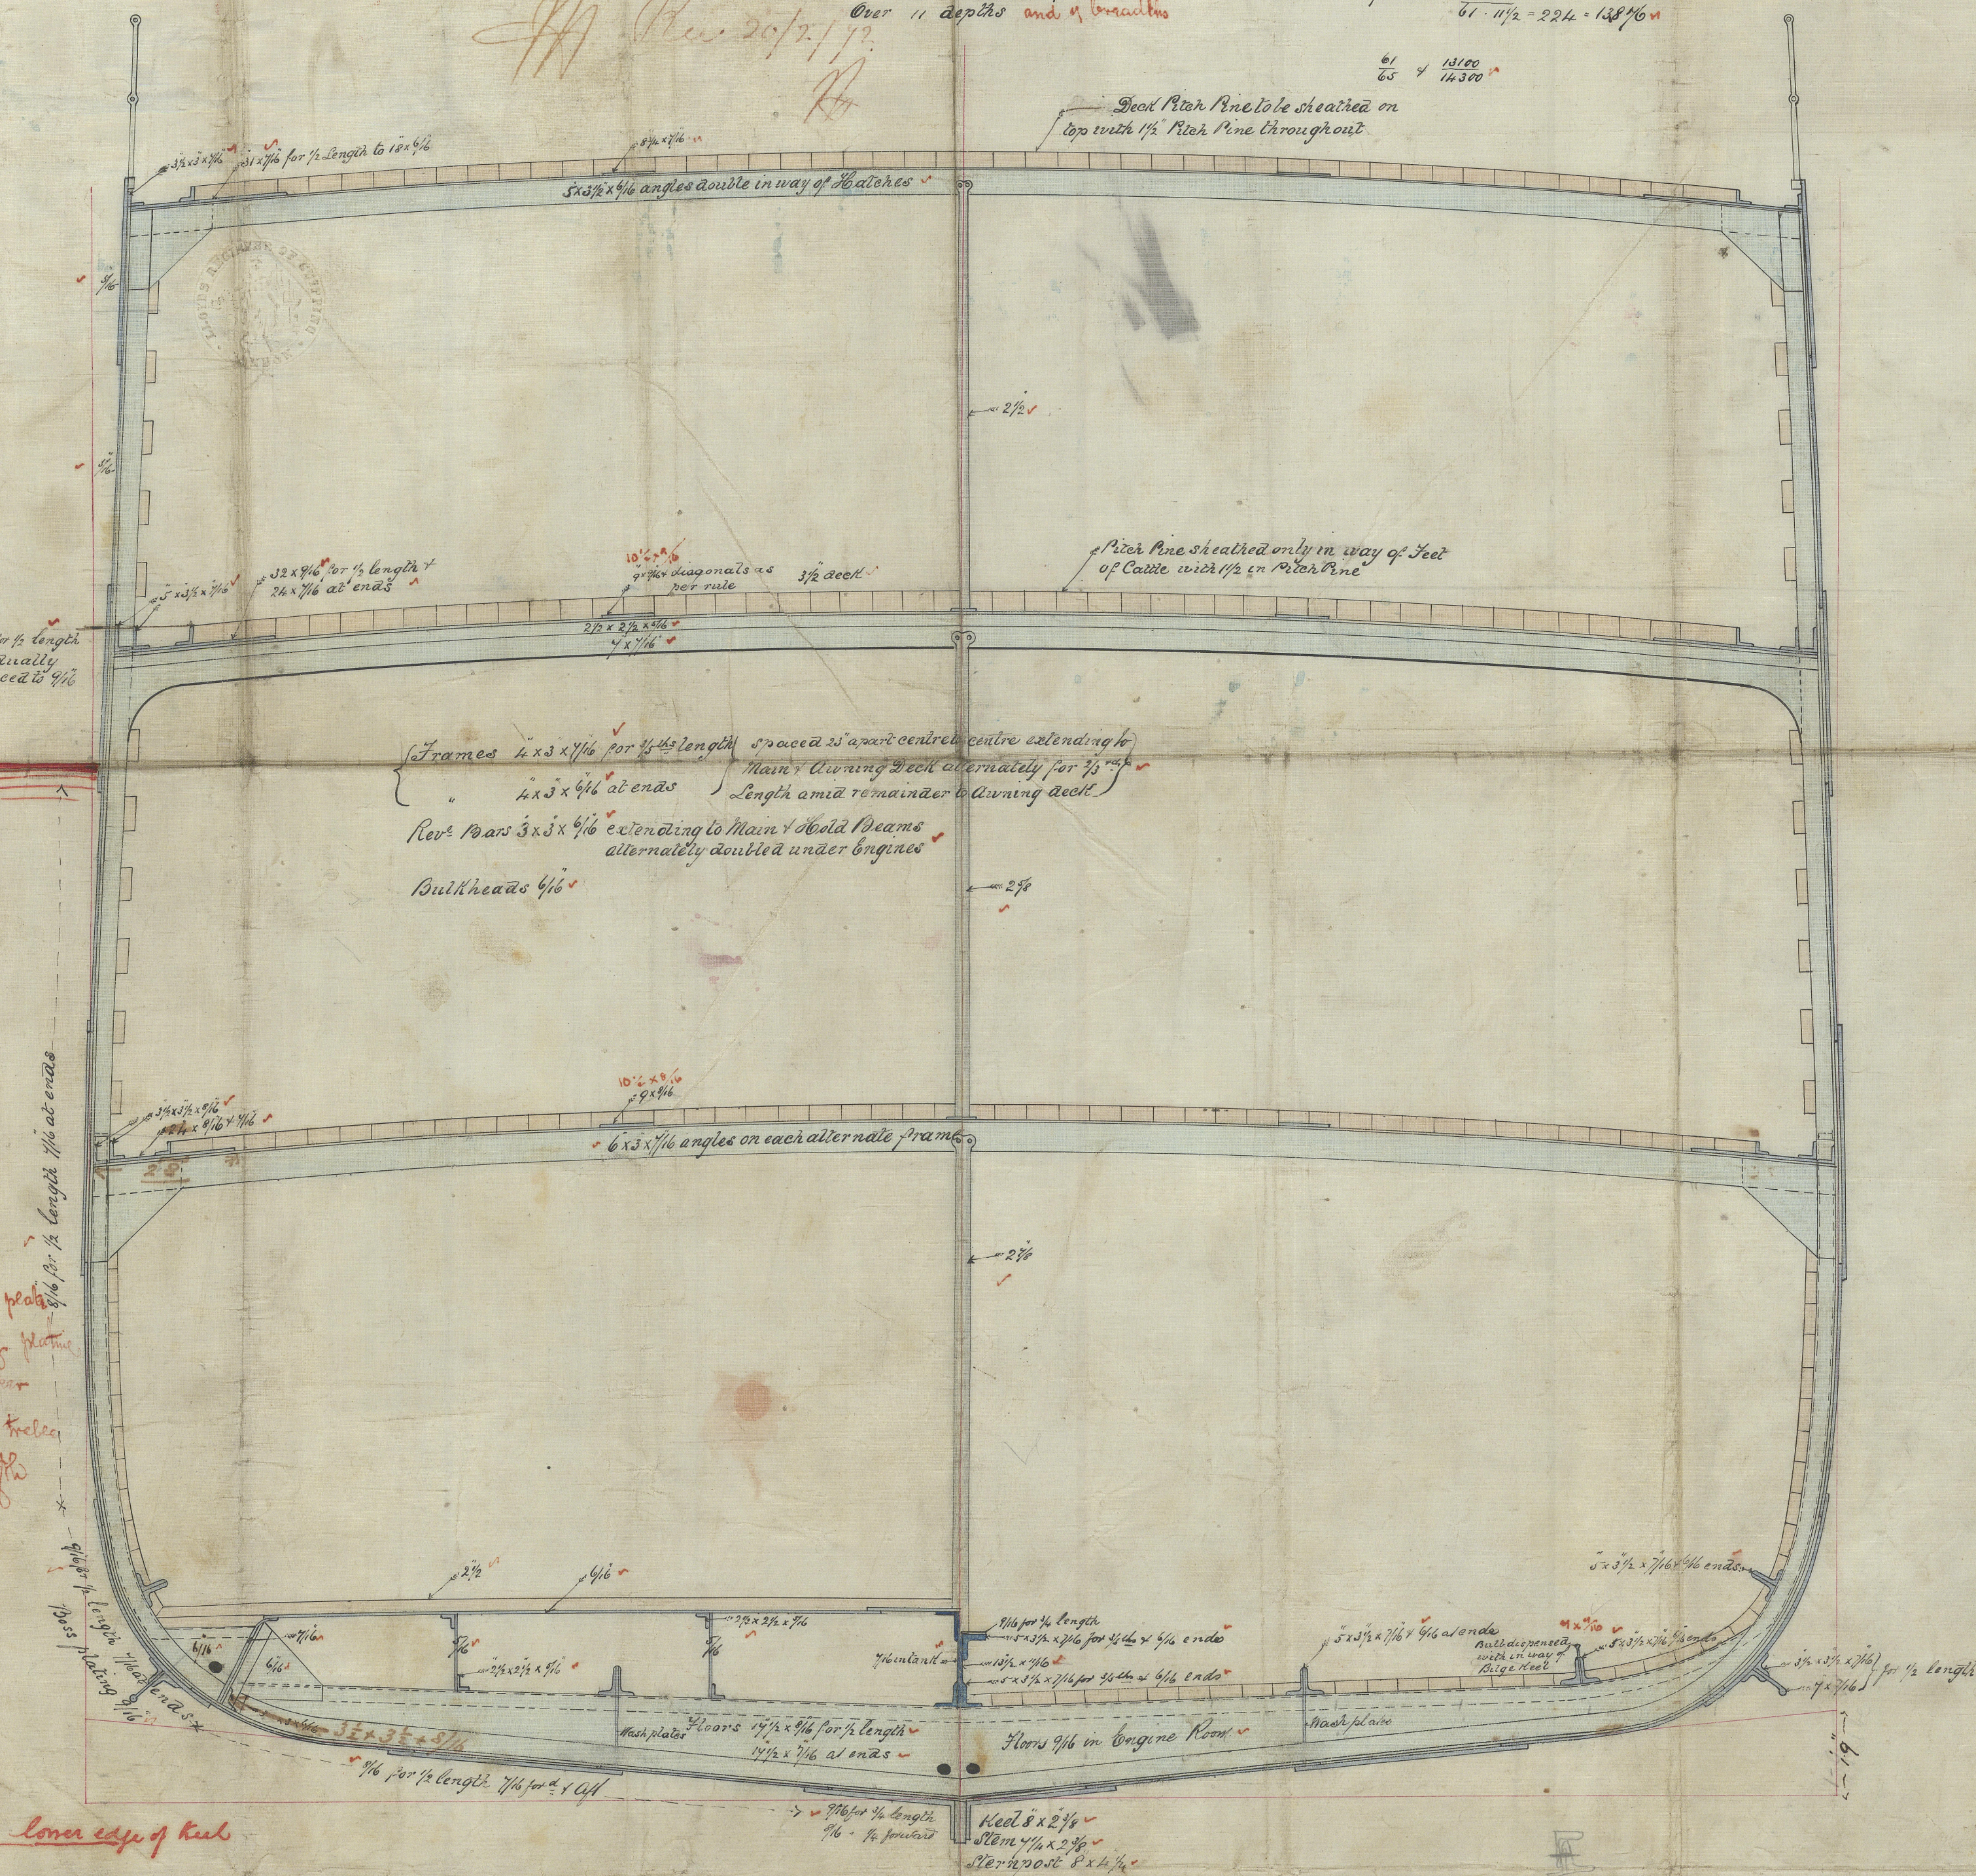

July 12<sup>th</sup> 1871

Rec'd July 13<sup>th</sup> 1871



© 2021 Lloyd's Register Foundation