


Scantling of S.S. "Albanian" of Hull $242 \times 28.9 \times 19.8$
 and Supposed arrangement $\frac{242}{40} = 28.2$ Total length

Approximate HP- 66.9 and 10.865 when lengthened 40 ft
 9 Breadths and 13 depths in length

Rec 11/12/71

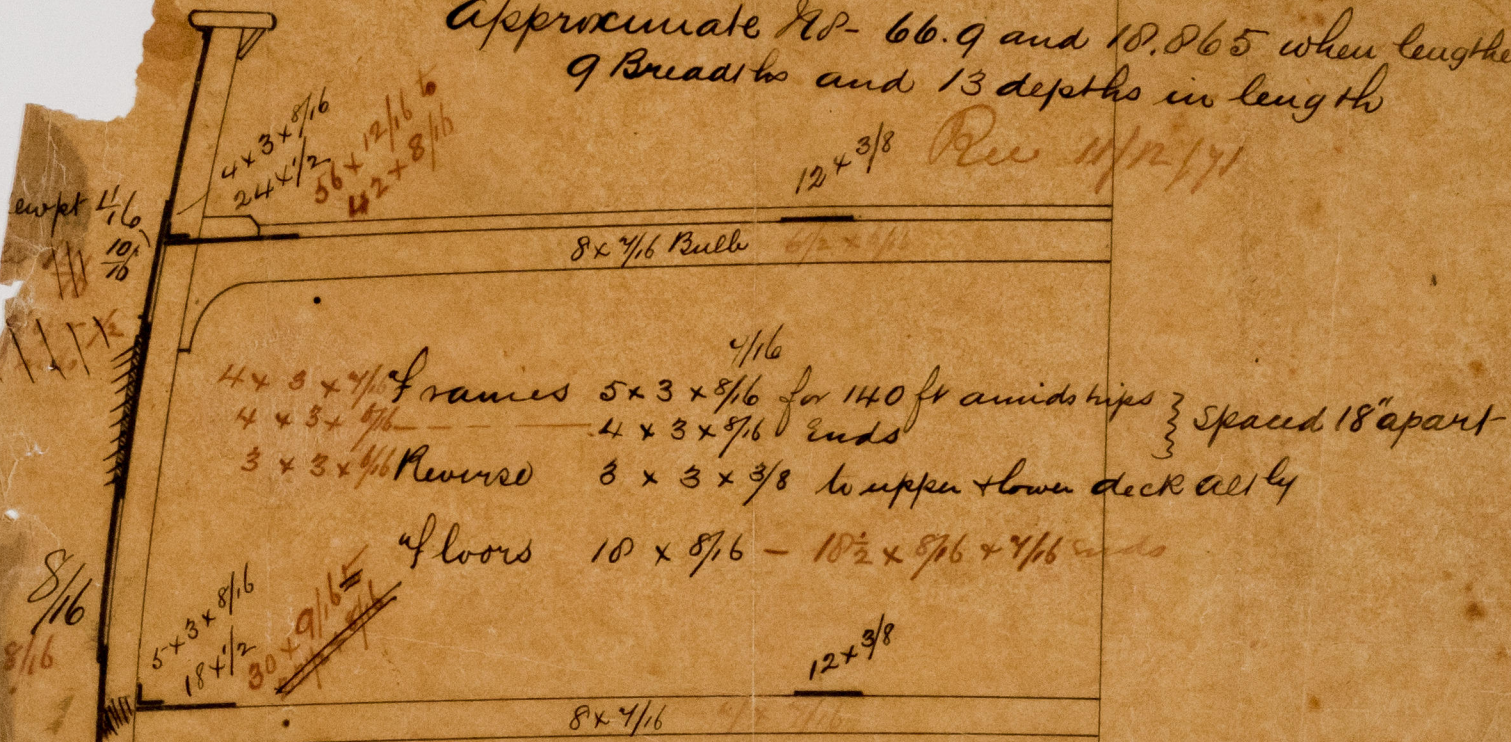

Scantling for 90 A marked in Red



Recd London 17.10.71

© 2021

Lloyd's Register Foundation

TRANSOS-0066

10085


Jan

11/12/20

Rec'd



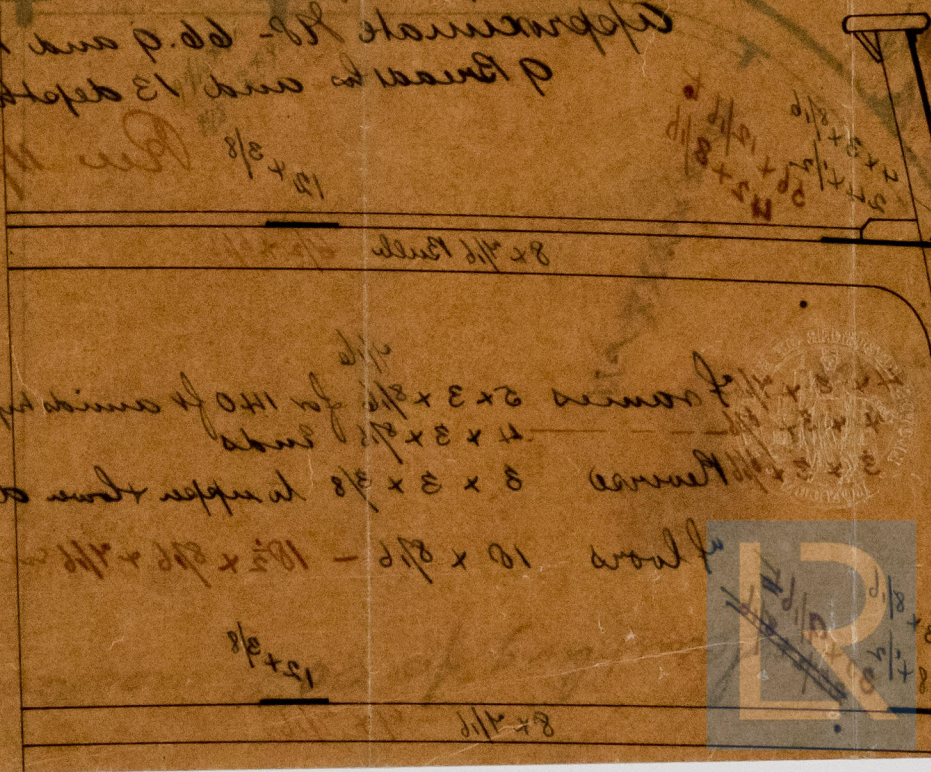

10 x 8/16 - 10 x 8/16 - 10 x 8/16

© 2021

Lloyd's Register
Foundation