

No 82

Dimensions per rule

Length ----- 228'-0"


Breadth --- 35'-0

Depth from top of keel --- 24' - 10"

Half Girch & Mid Sec. 36'-3"

Scale $\frac{1}{4}" = 1 \text{ foot.}$


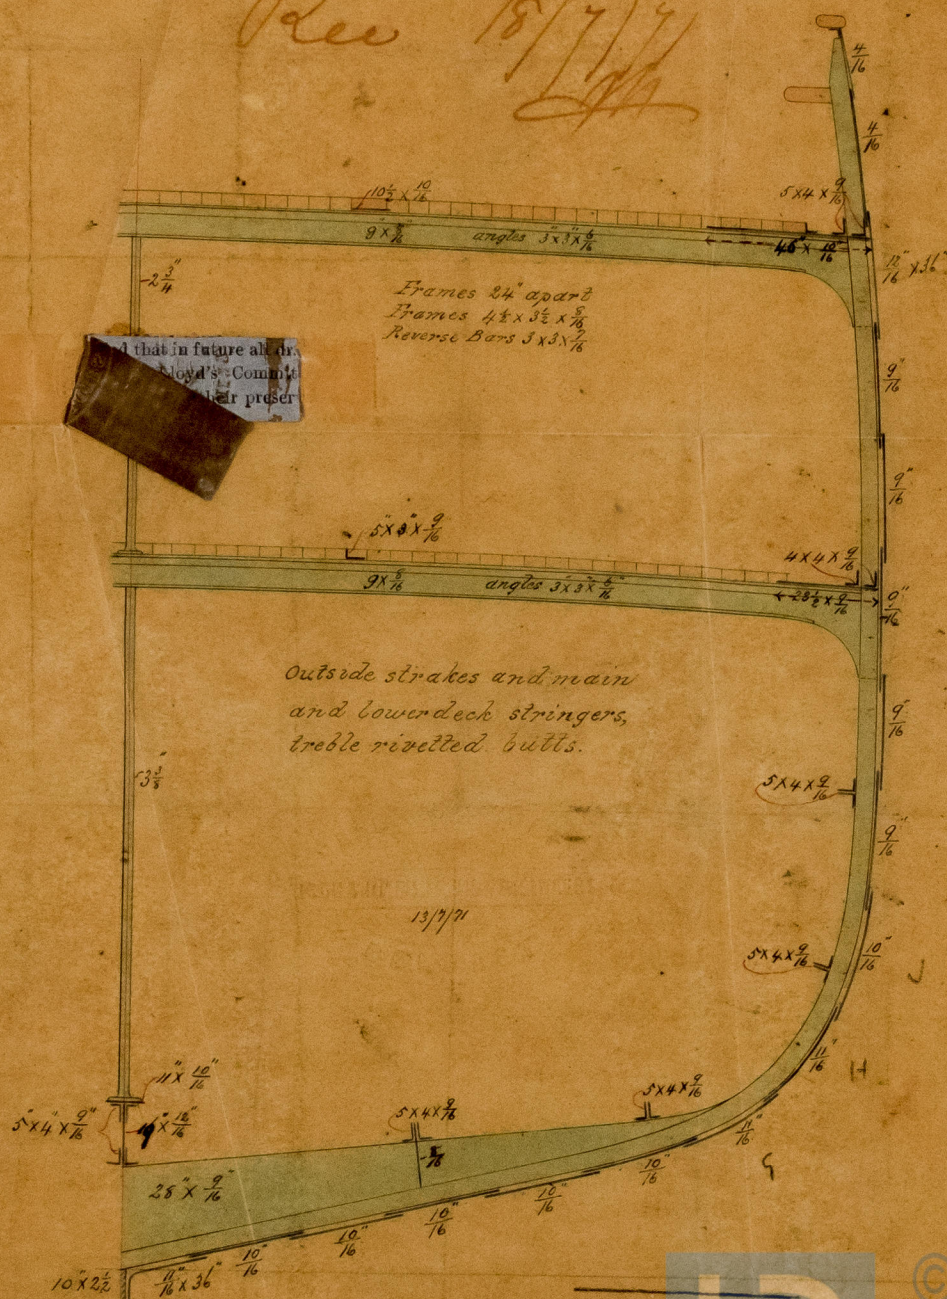

B. 72
18/7/71