

Class 10 A
Requisition N^o 592.

Yrsk 28.9

S. S. H^c 148

Revenue for Frames 60.9
Q^c for Plating and Reel 121.61

Rec 6/11/91



over 6 funder
Beachth
over 11 - under 12
Depth

36 for $\frac{1}{2}$ length 22 $\frac{1}{2}$ at Stern
8 $\frac{1}{2}$ " 6 $\frac{1}{2}$ " "
Butts 3 $\frac{1}{2}$ rivets for $\frac{1}{2}$ length
Stinson and 3 $\frac{1}{2}$ x 3 $\frac{1}{2}$ "

$$I \frac{1}{4}$$

Single wafted

18 6/16

Single rivetted.

$3 \frac{1}{2} \times \frac{1}{4}$ for $\frac{1}{2}$ length -

Bullets 3¹¹/₁₆ rivetted for 1/2 length

Double pivoted

H. 8/16

Single rivetted

Q. 8 1/6"

Single rivetted

$F^{8/16}$

Double rivetted as per Rule
Single at ends.

9 1/2"


Accepted

44 treble pivoted
Vessels Length

H. MURRAY & CO
Iron Shipbuilders
PORT GLASGOW

© 2021 Lloyd's Register Foundation

IRONSOS-020

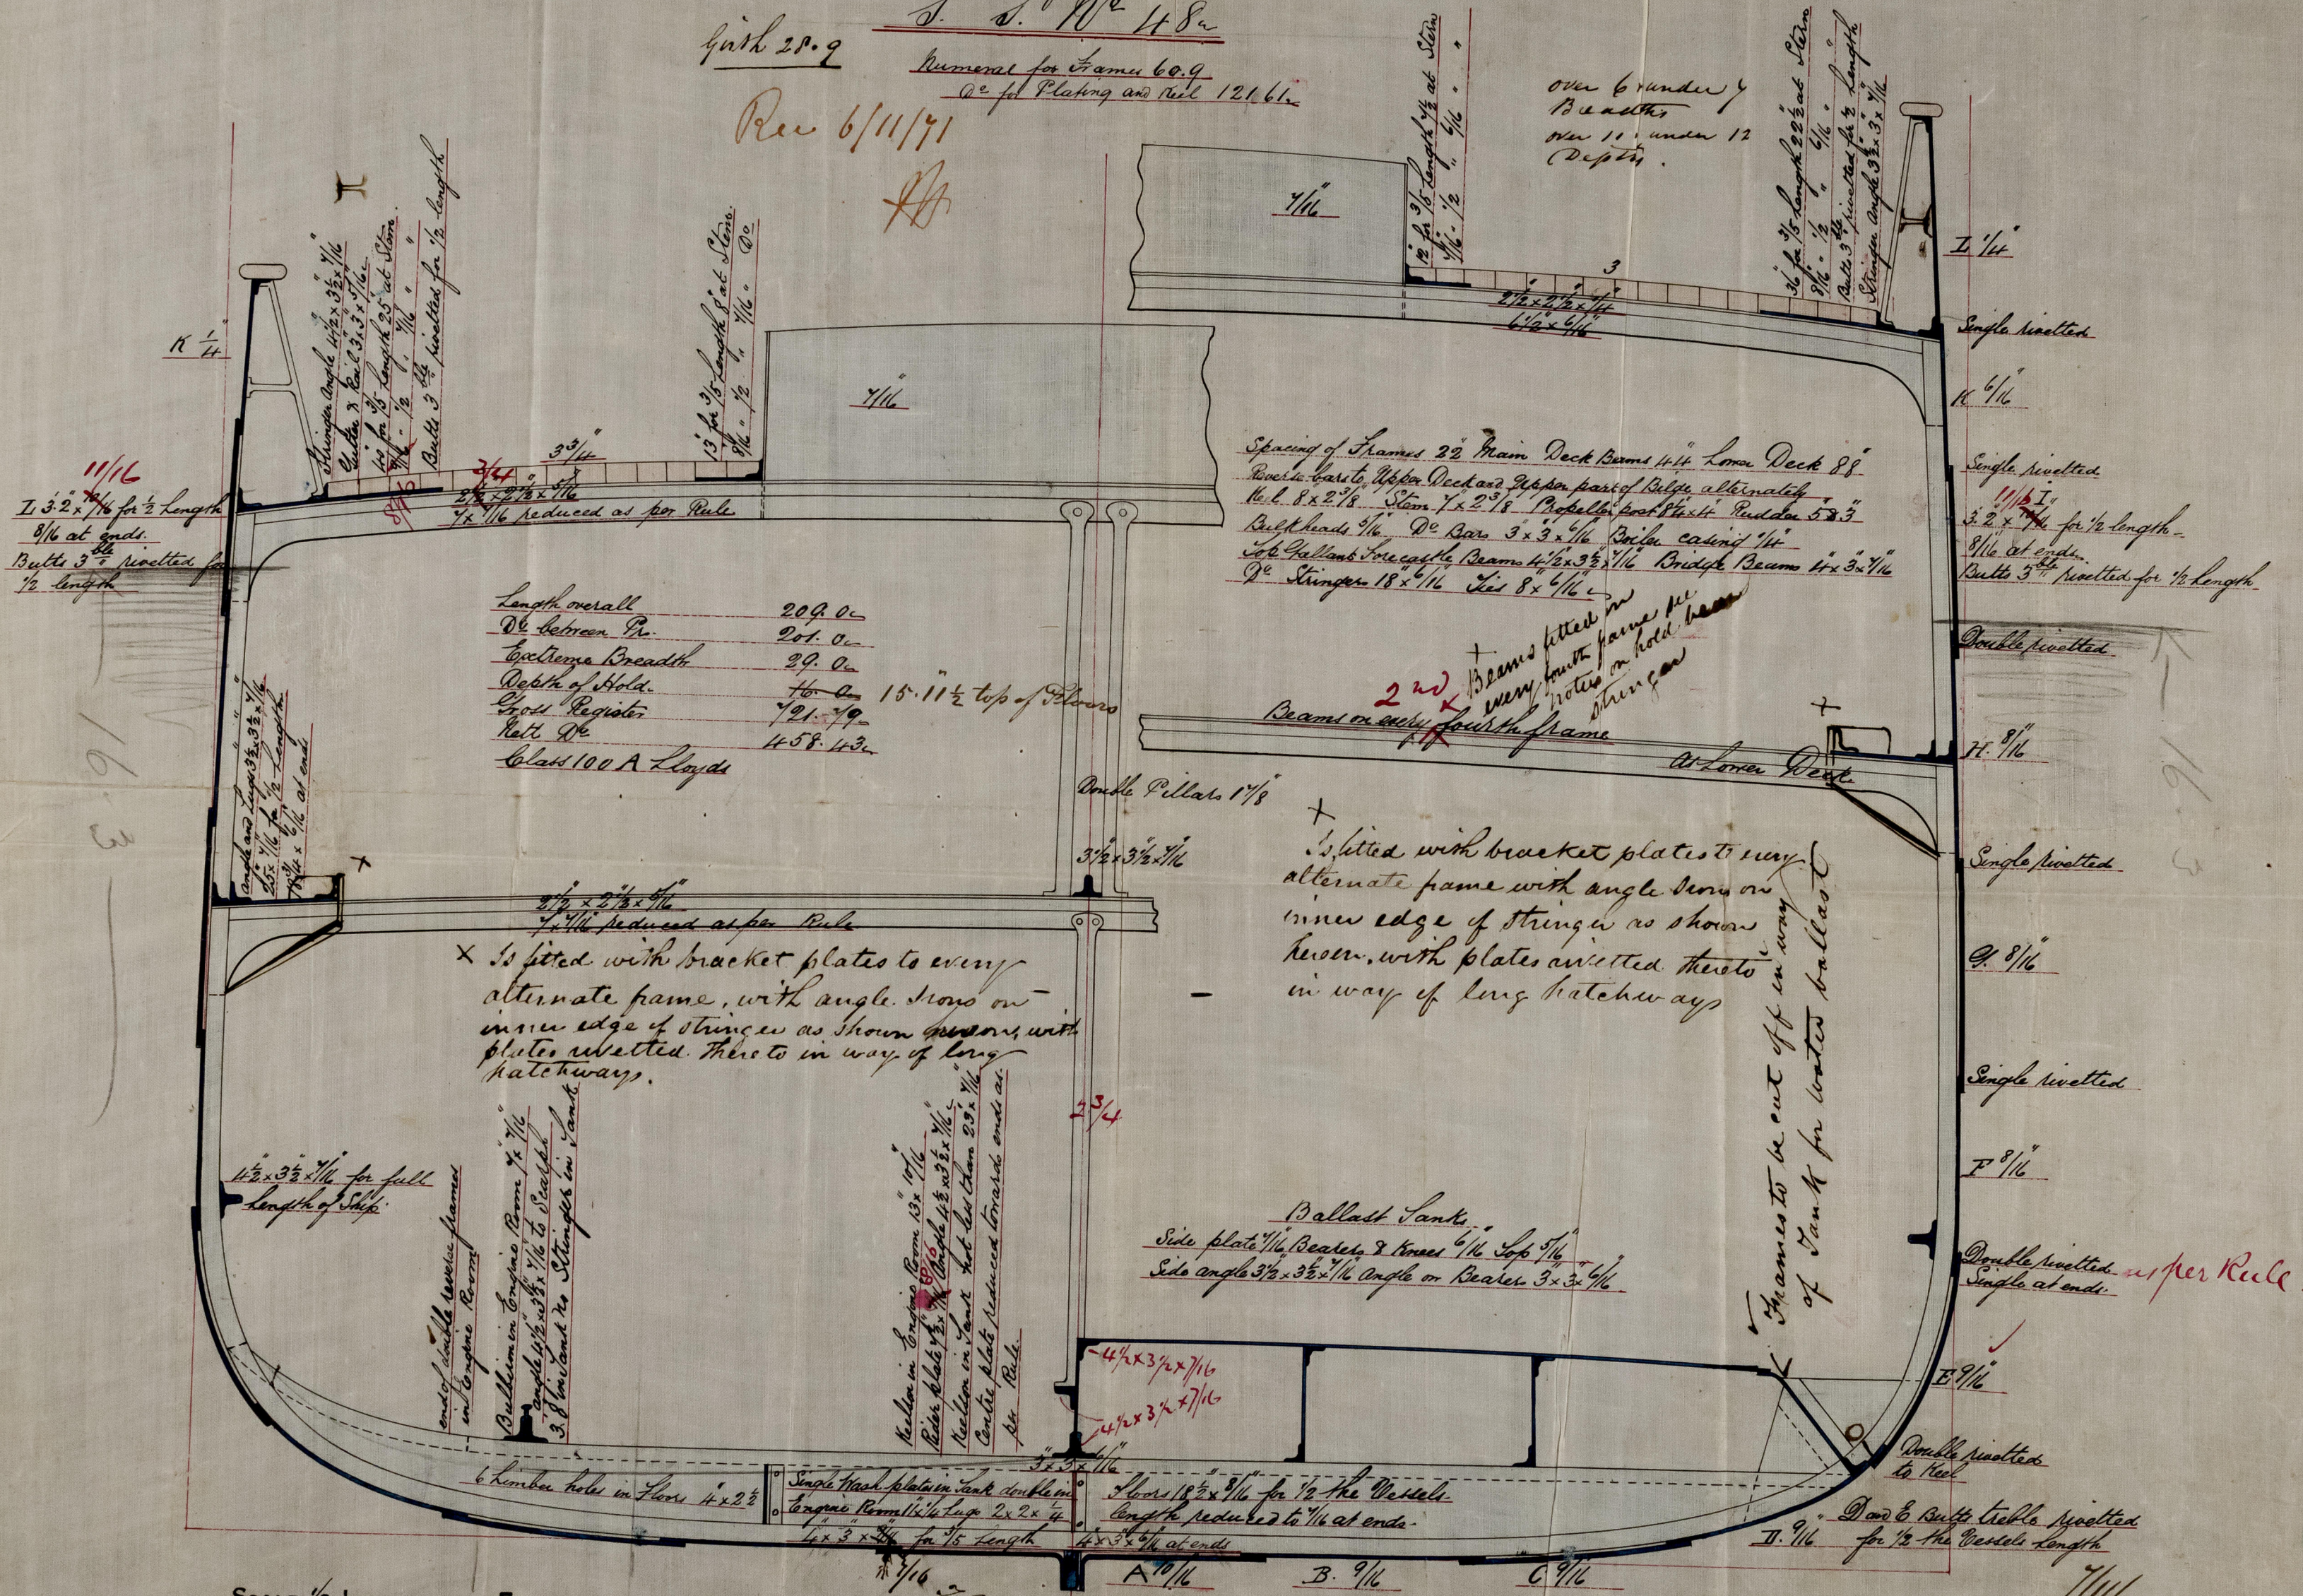

SCALE $\frac{1}{2}$ INCH TO THE FOOT