No 77

MIDSHIP SECTION

— Scale 1/2" inch, —

Dimensions

Length between perps	285 feet
Beam (moulded)	36 "
Depth (do)	26 "

Clipper Bow.

To class 100 A and marked in register book "Spar decked"

Numbers.

1/2 girth	32·2
1/2 Breadth	18·0
Depth to main deck	19·0
	69·2

69·2 × 283 = 19583

69·2 × 278·67 = 19,270

At three decks nos 76·2 × 283 = 21564

SS "Vibilia"

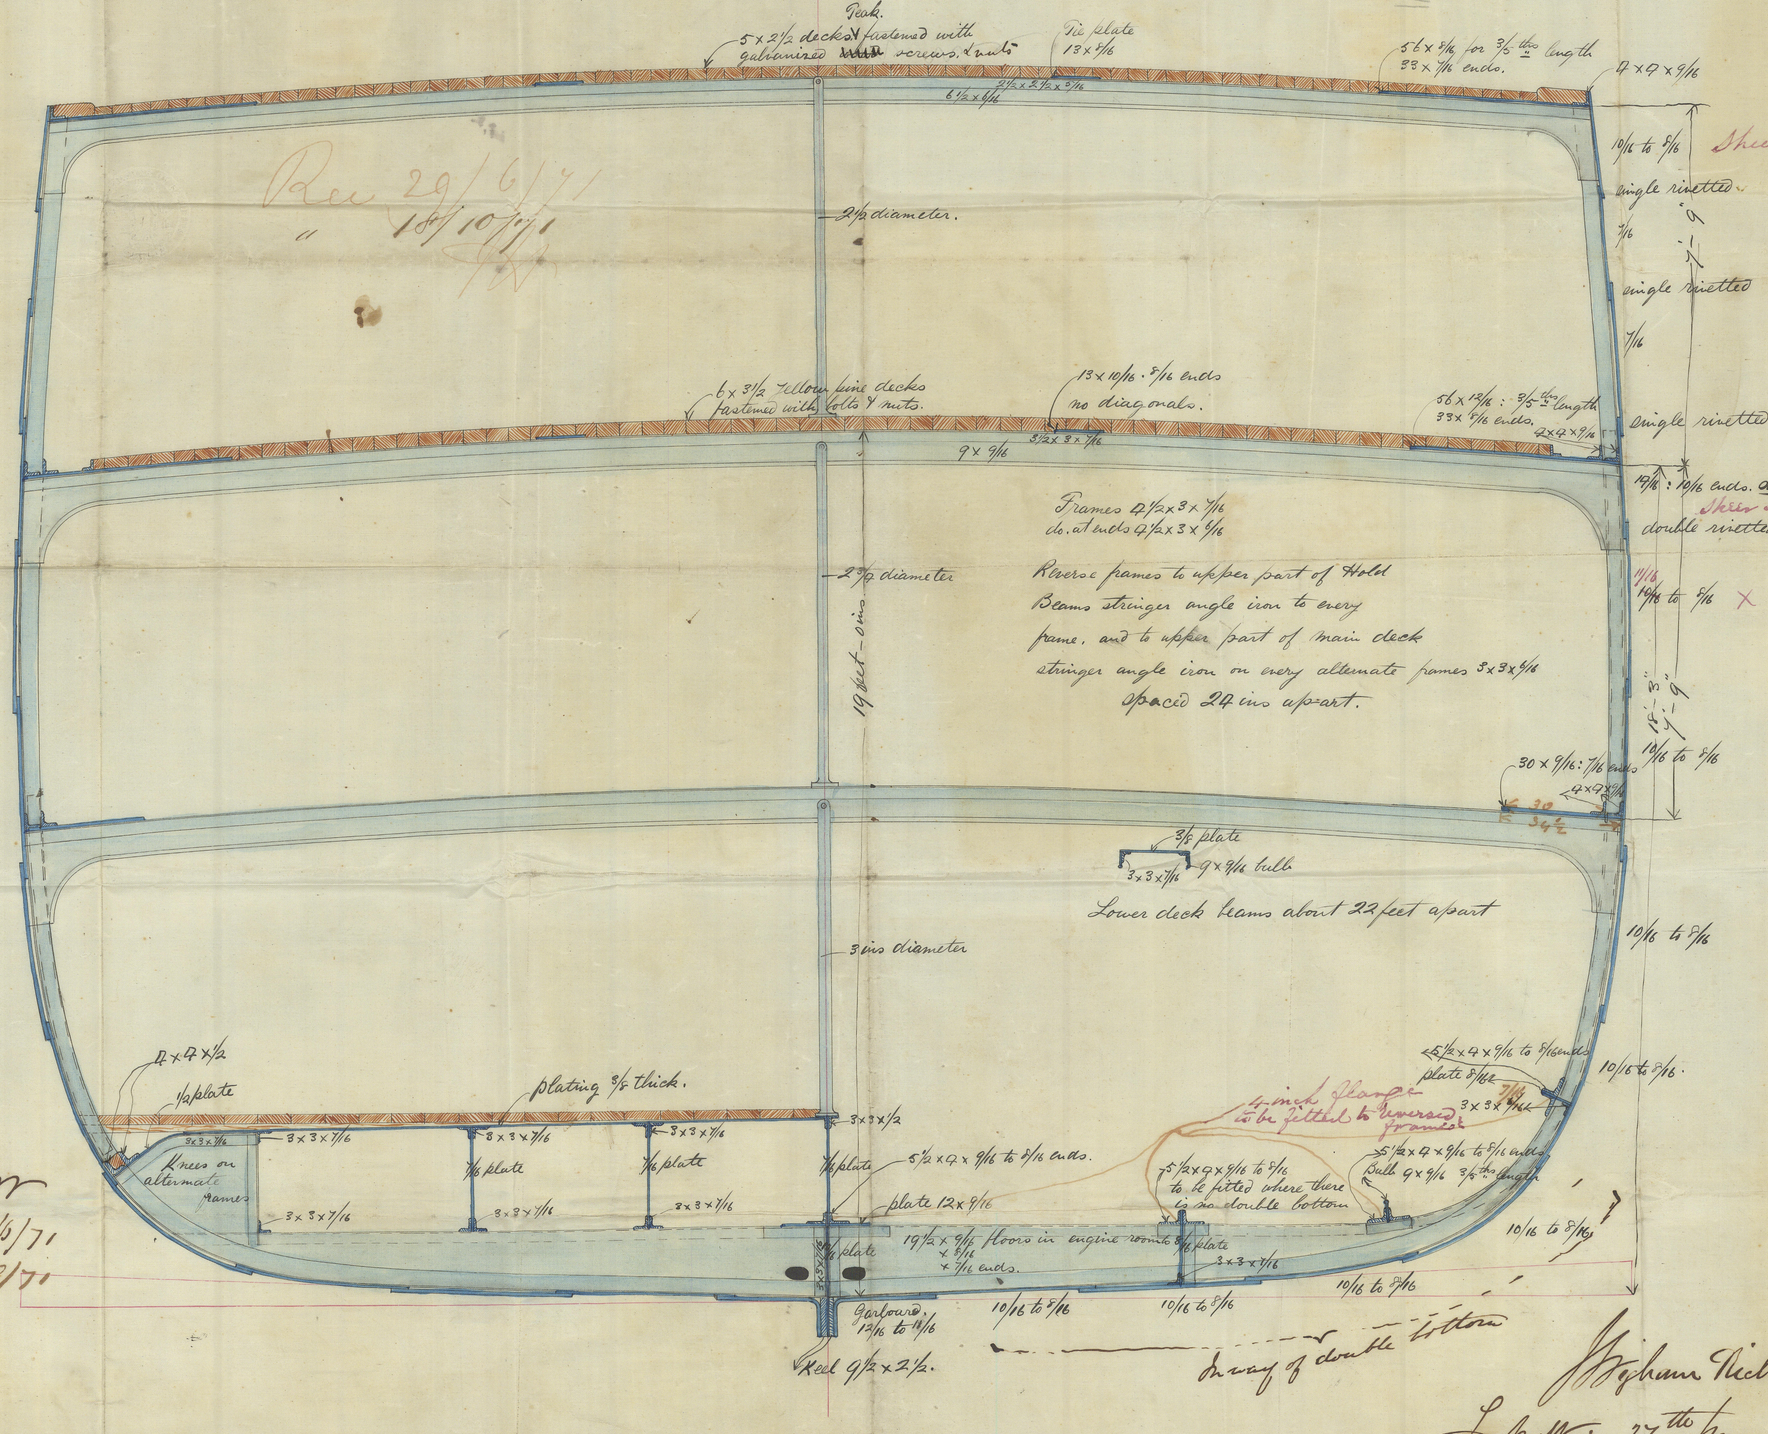

Rec 29/6/71
" 18/10/71

B.W.
30/6/71
18/10/71

J Wigham Richardson & Co

Lowbulker 27th June 1871

© 2021 Lloyd's Register Foundation