


No 52.3
 Scale 1/8 inch = 1 foot.

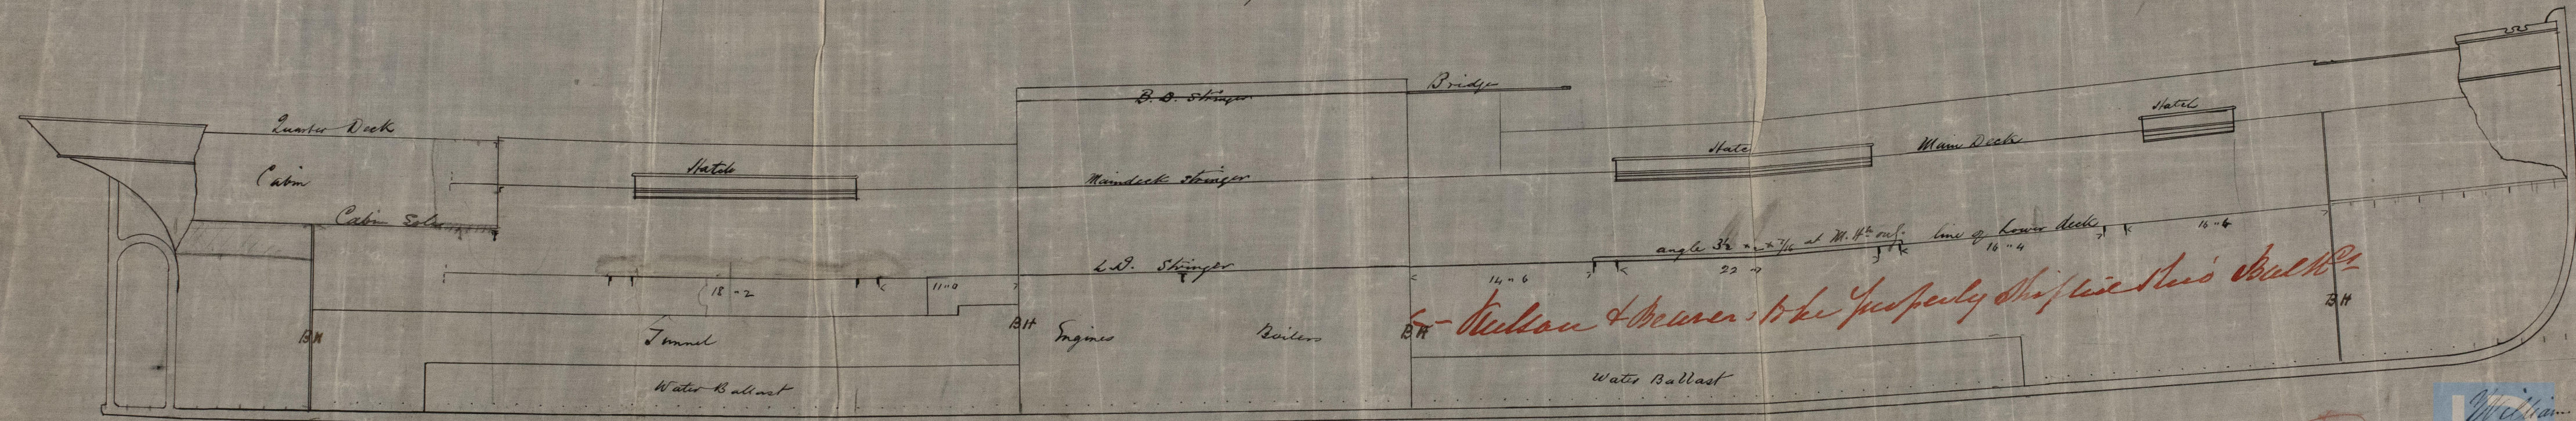


Thos 7/11/71
 William O. Brown
 Master
 Foundation

IRON 50 5-0238