

S. Nos 52-3

To class 90 A

Proportions

Scale $\frac{1}{2}$ in = 1 foot


	Feet	Inches
Length	198	0
Breadth	28	5
Depth of hold	16	6 $\frac{1}{2}$
" to keel	18	0
Girth	28	9

Breadth to length 6.6
Depth " " 11.00

Sum 14.2
18.

$$\frac{28.75}{60.95} \times 198 = 12068$$

L. D. Ree 24/1/79

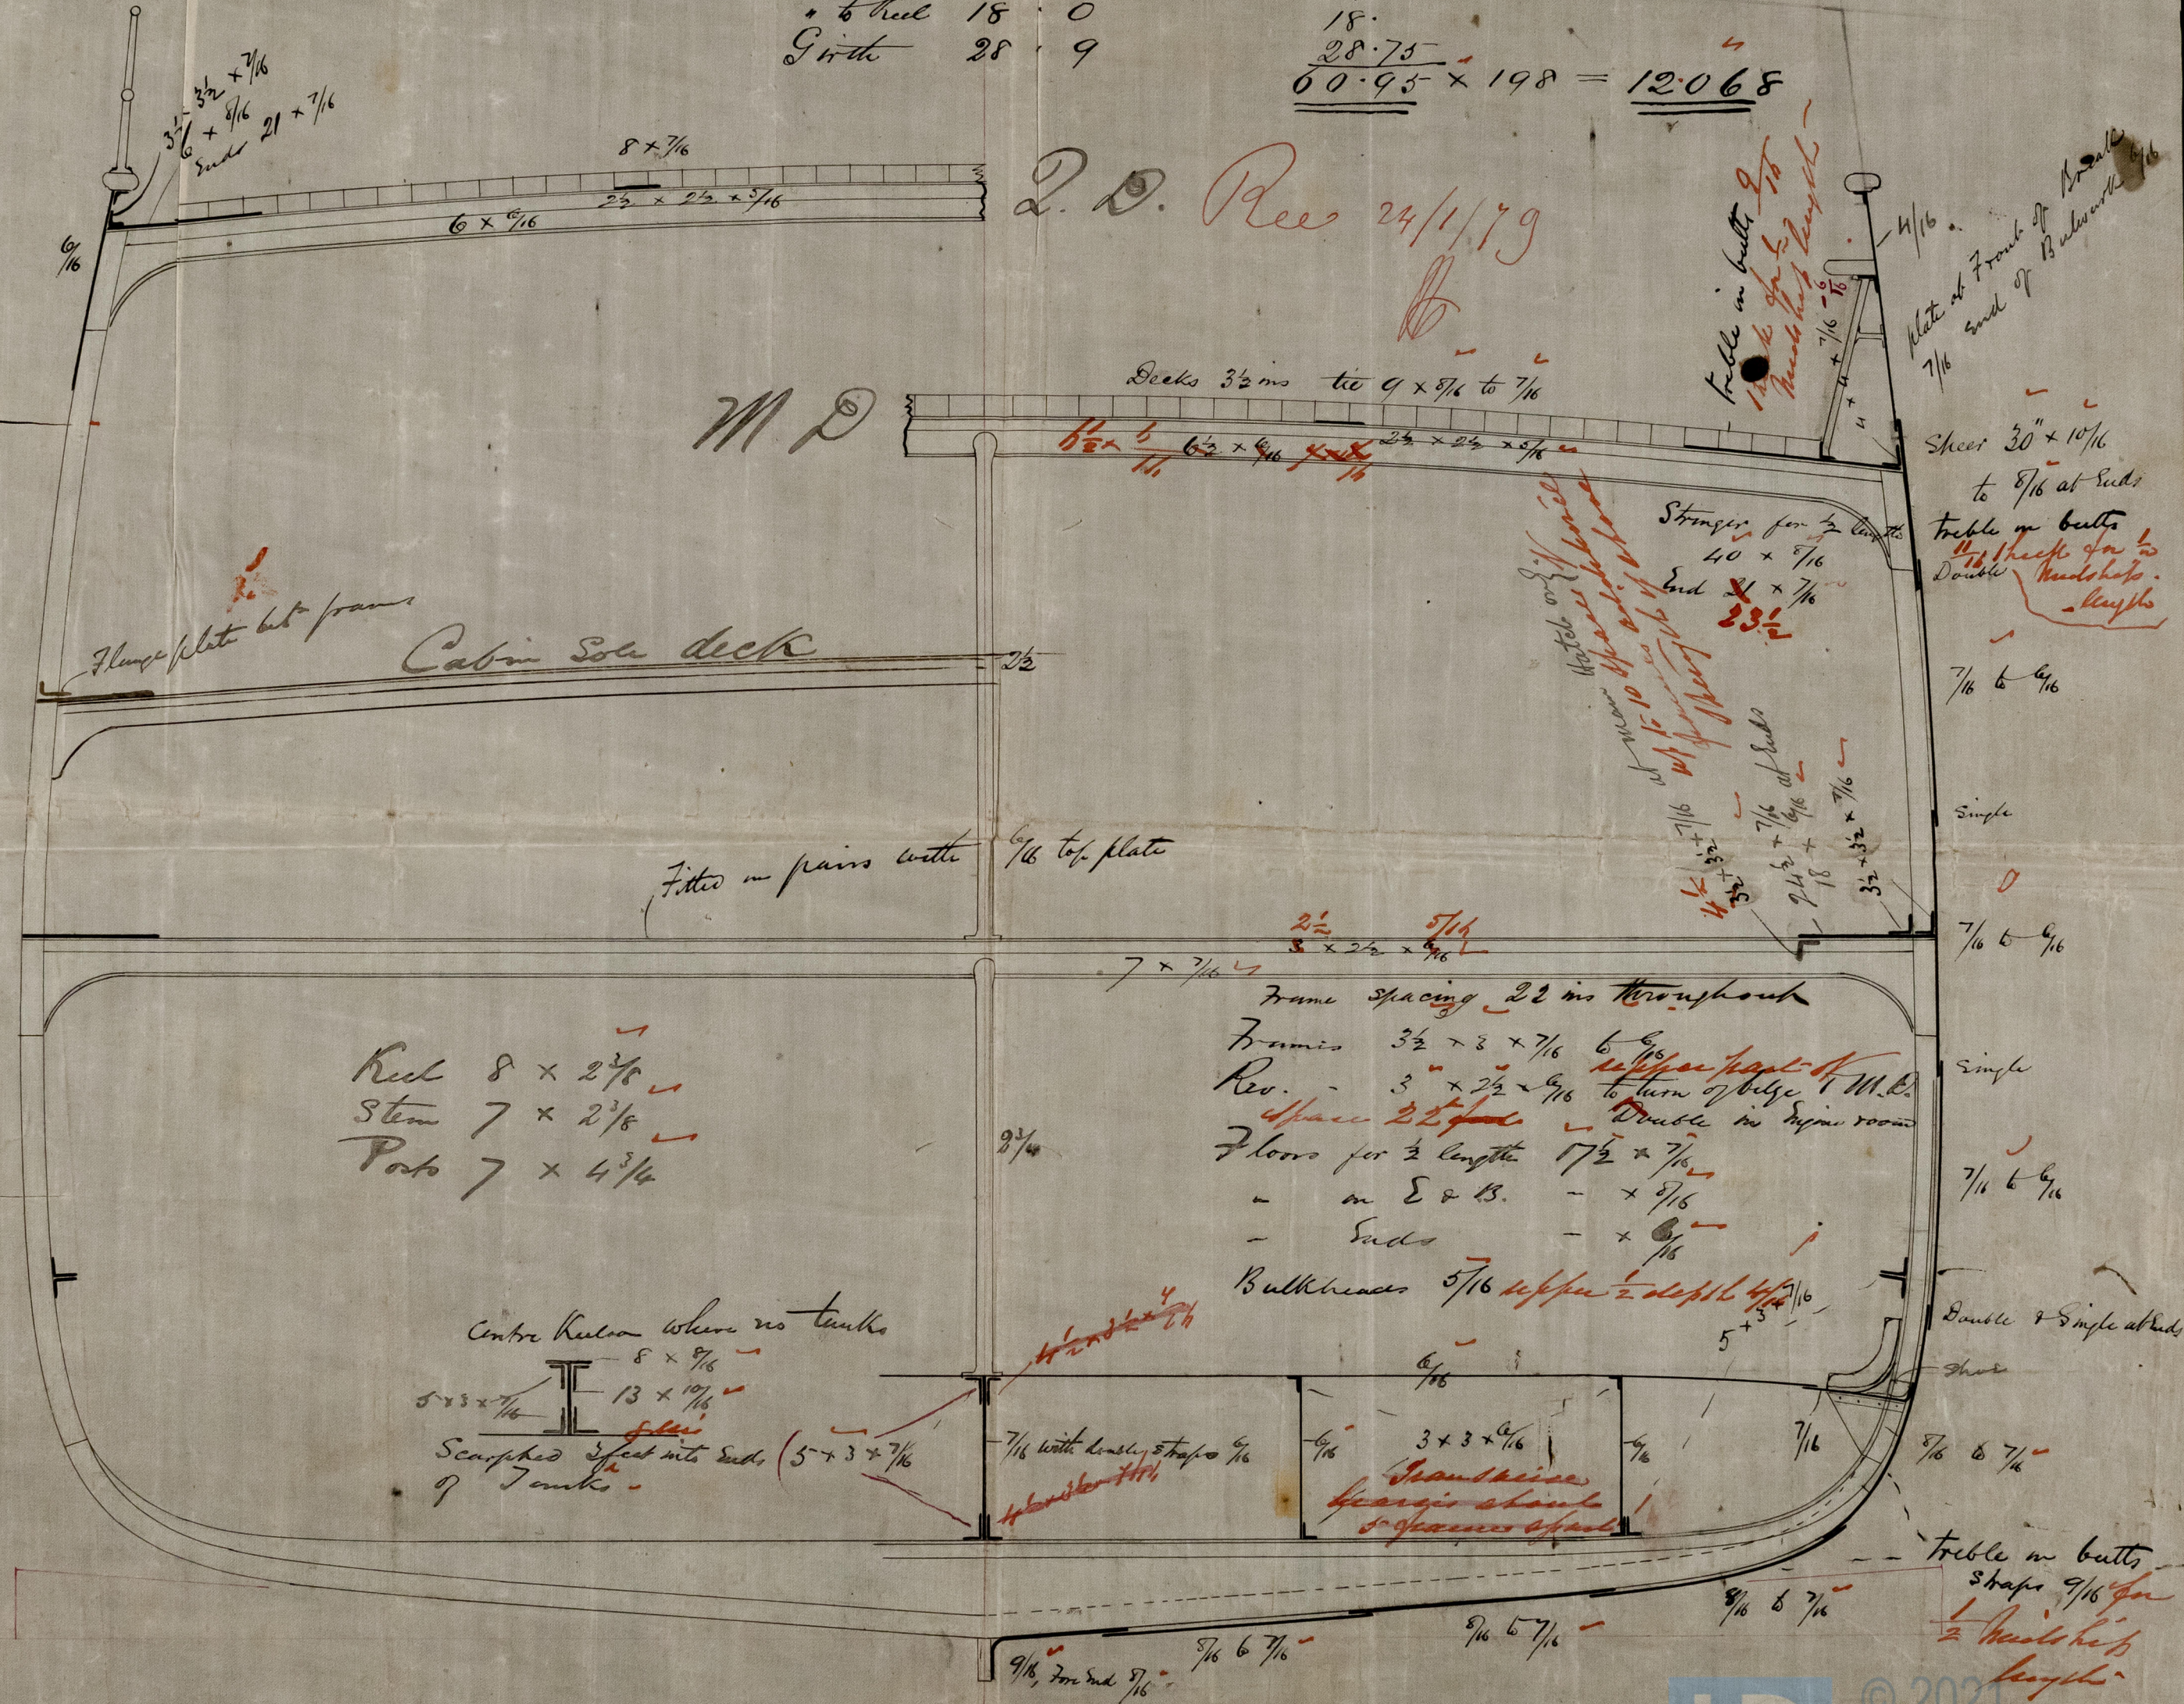

Received from Lloyd's approved Nov. 16. 1871
J. B.

© 2021
William Overton & Sons
Lloyd's Register
Foundation
7/11/71
IRONSOS-0240