


S.S. "Paknam"

Grk Rep No 6213

Iron No 10468

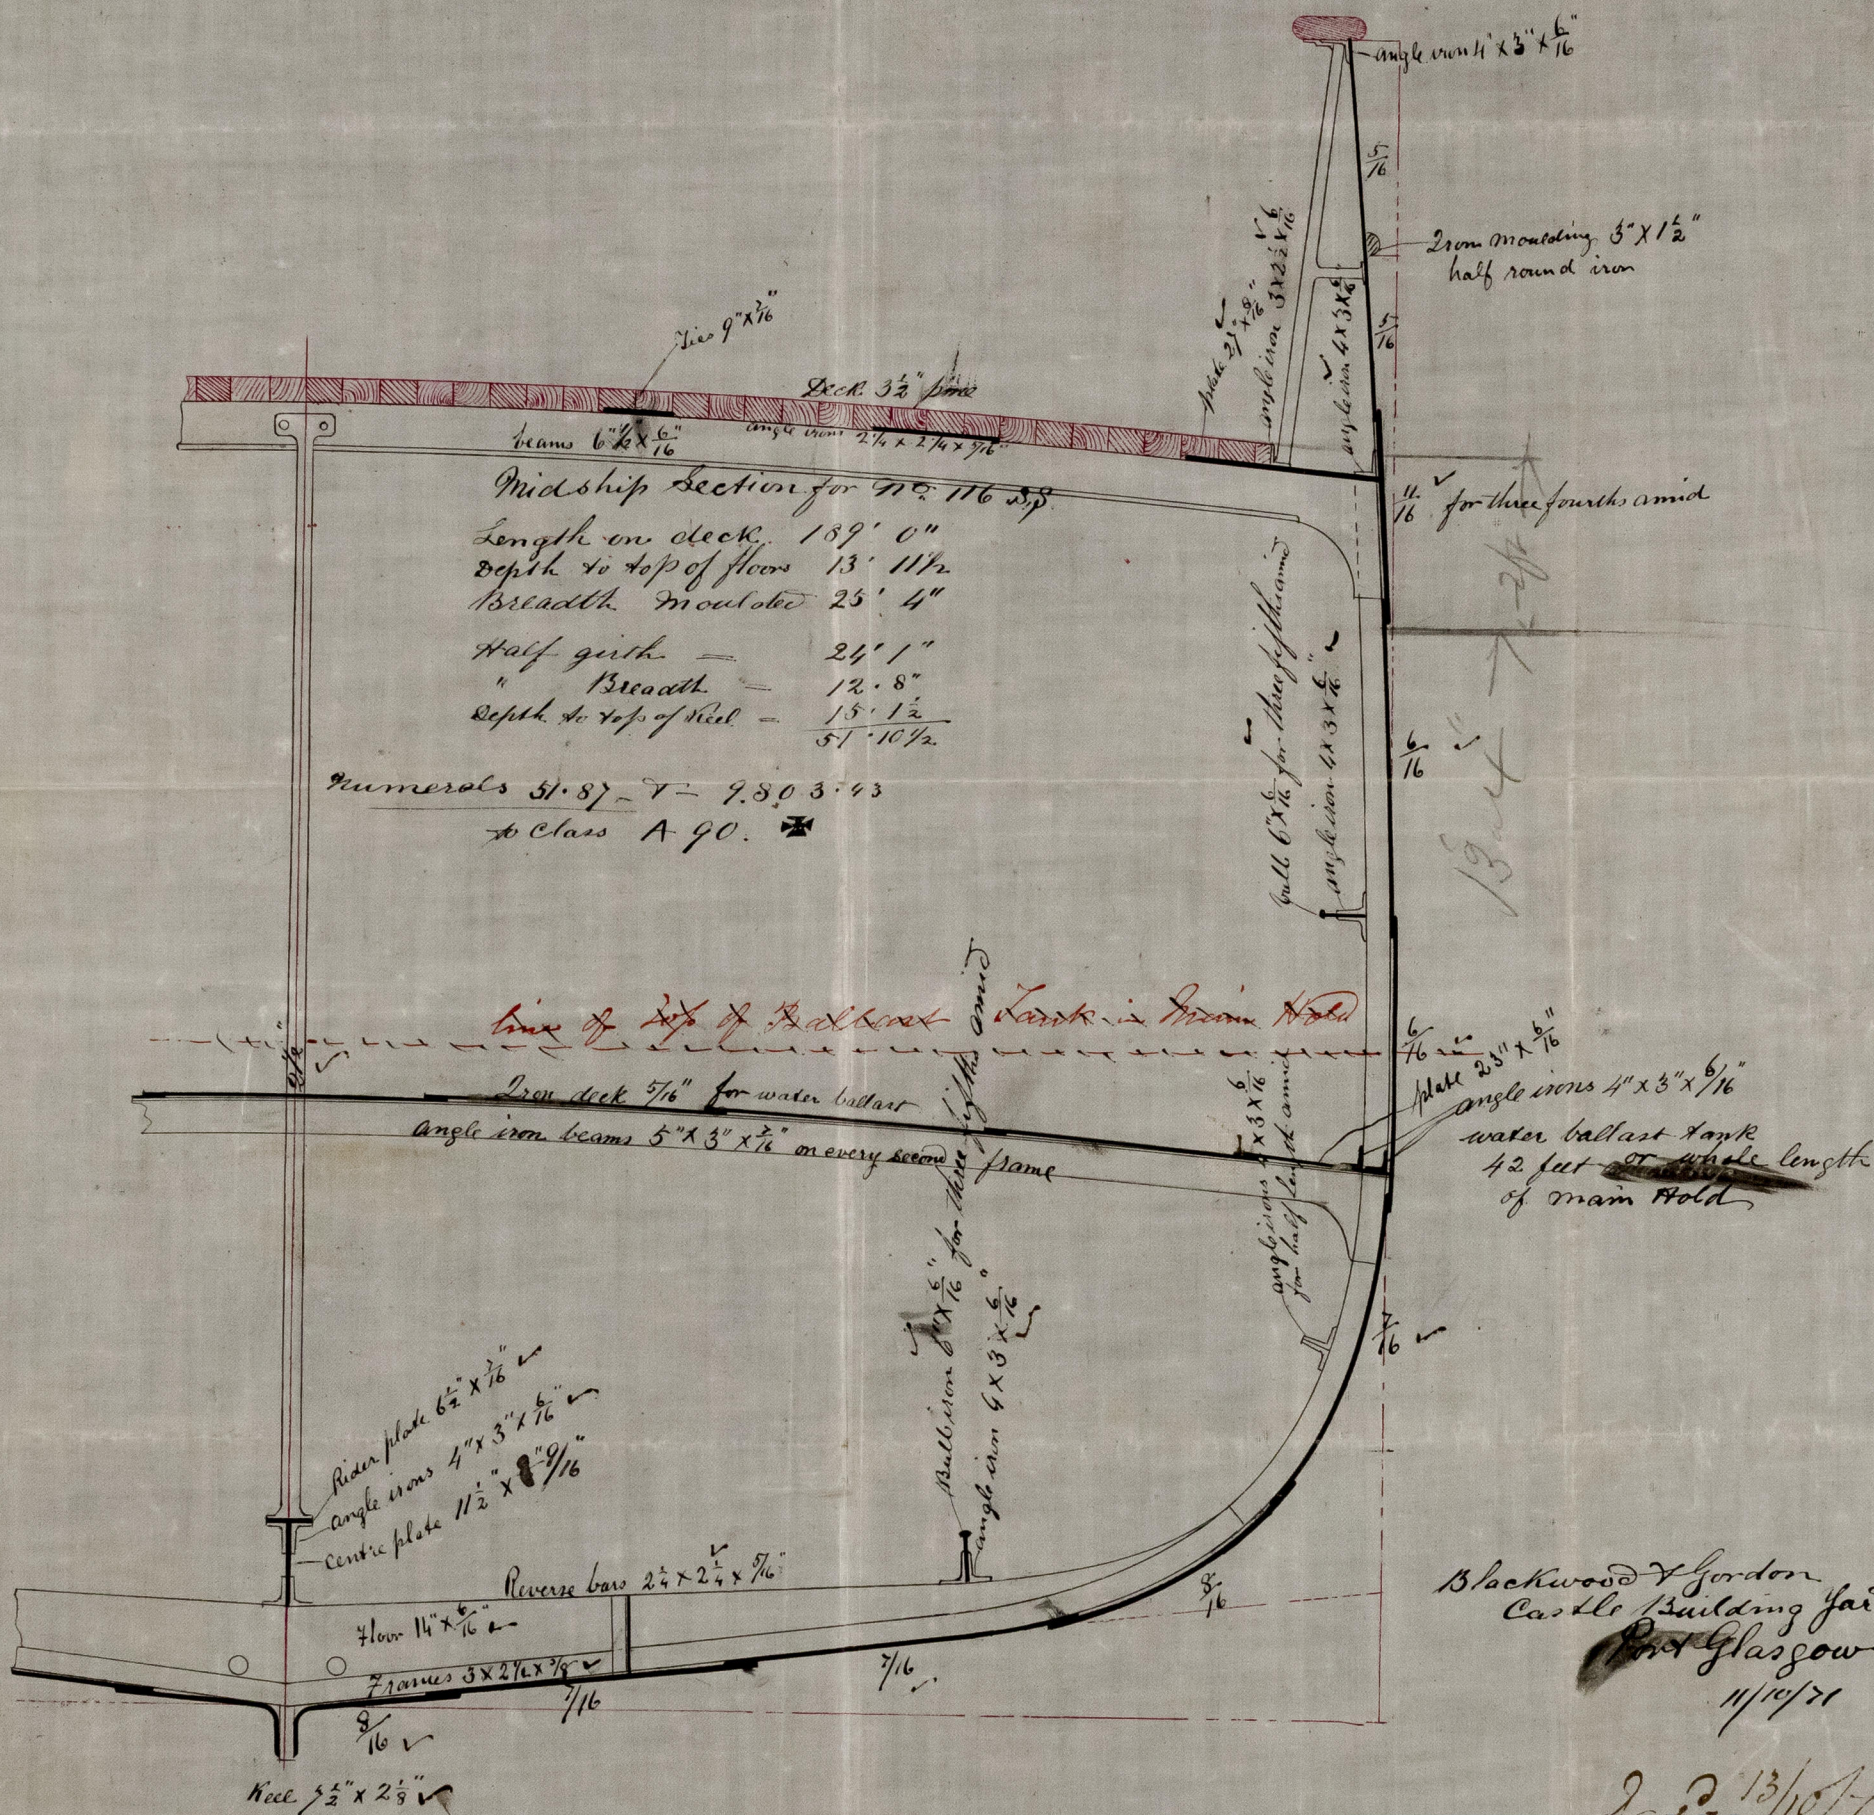

2022 13/10/71  
S.R.B.

Lloyd's Register  
Foundation

IRONSOS 0252