


+ "Minnesota"
(now Dec.)

Scale $\frac{1}{2}'' = 1 \text{ Foot.}$

Two Decks with Orlop Beams

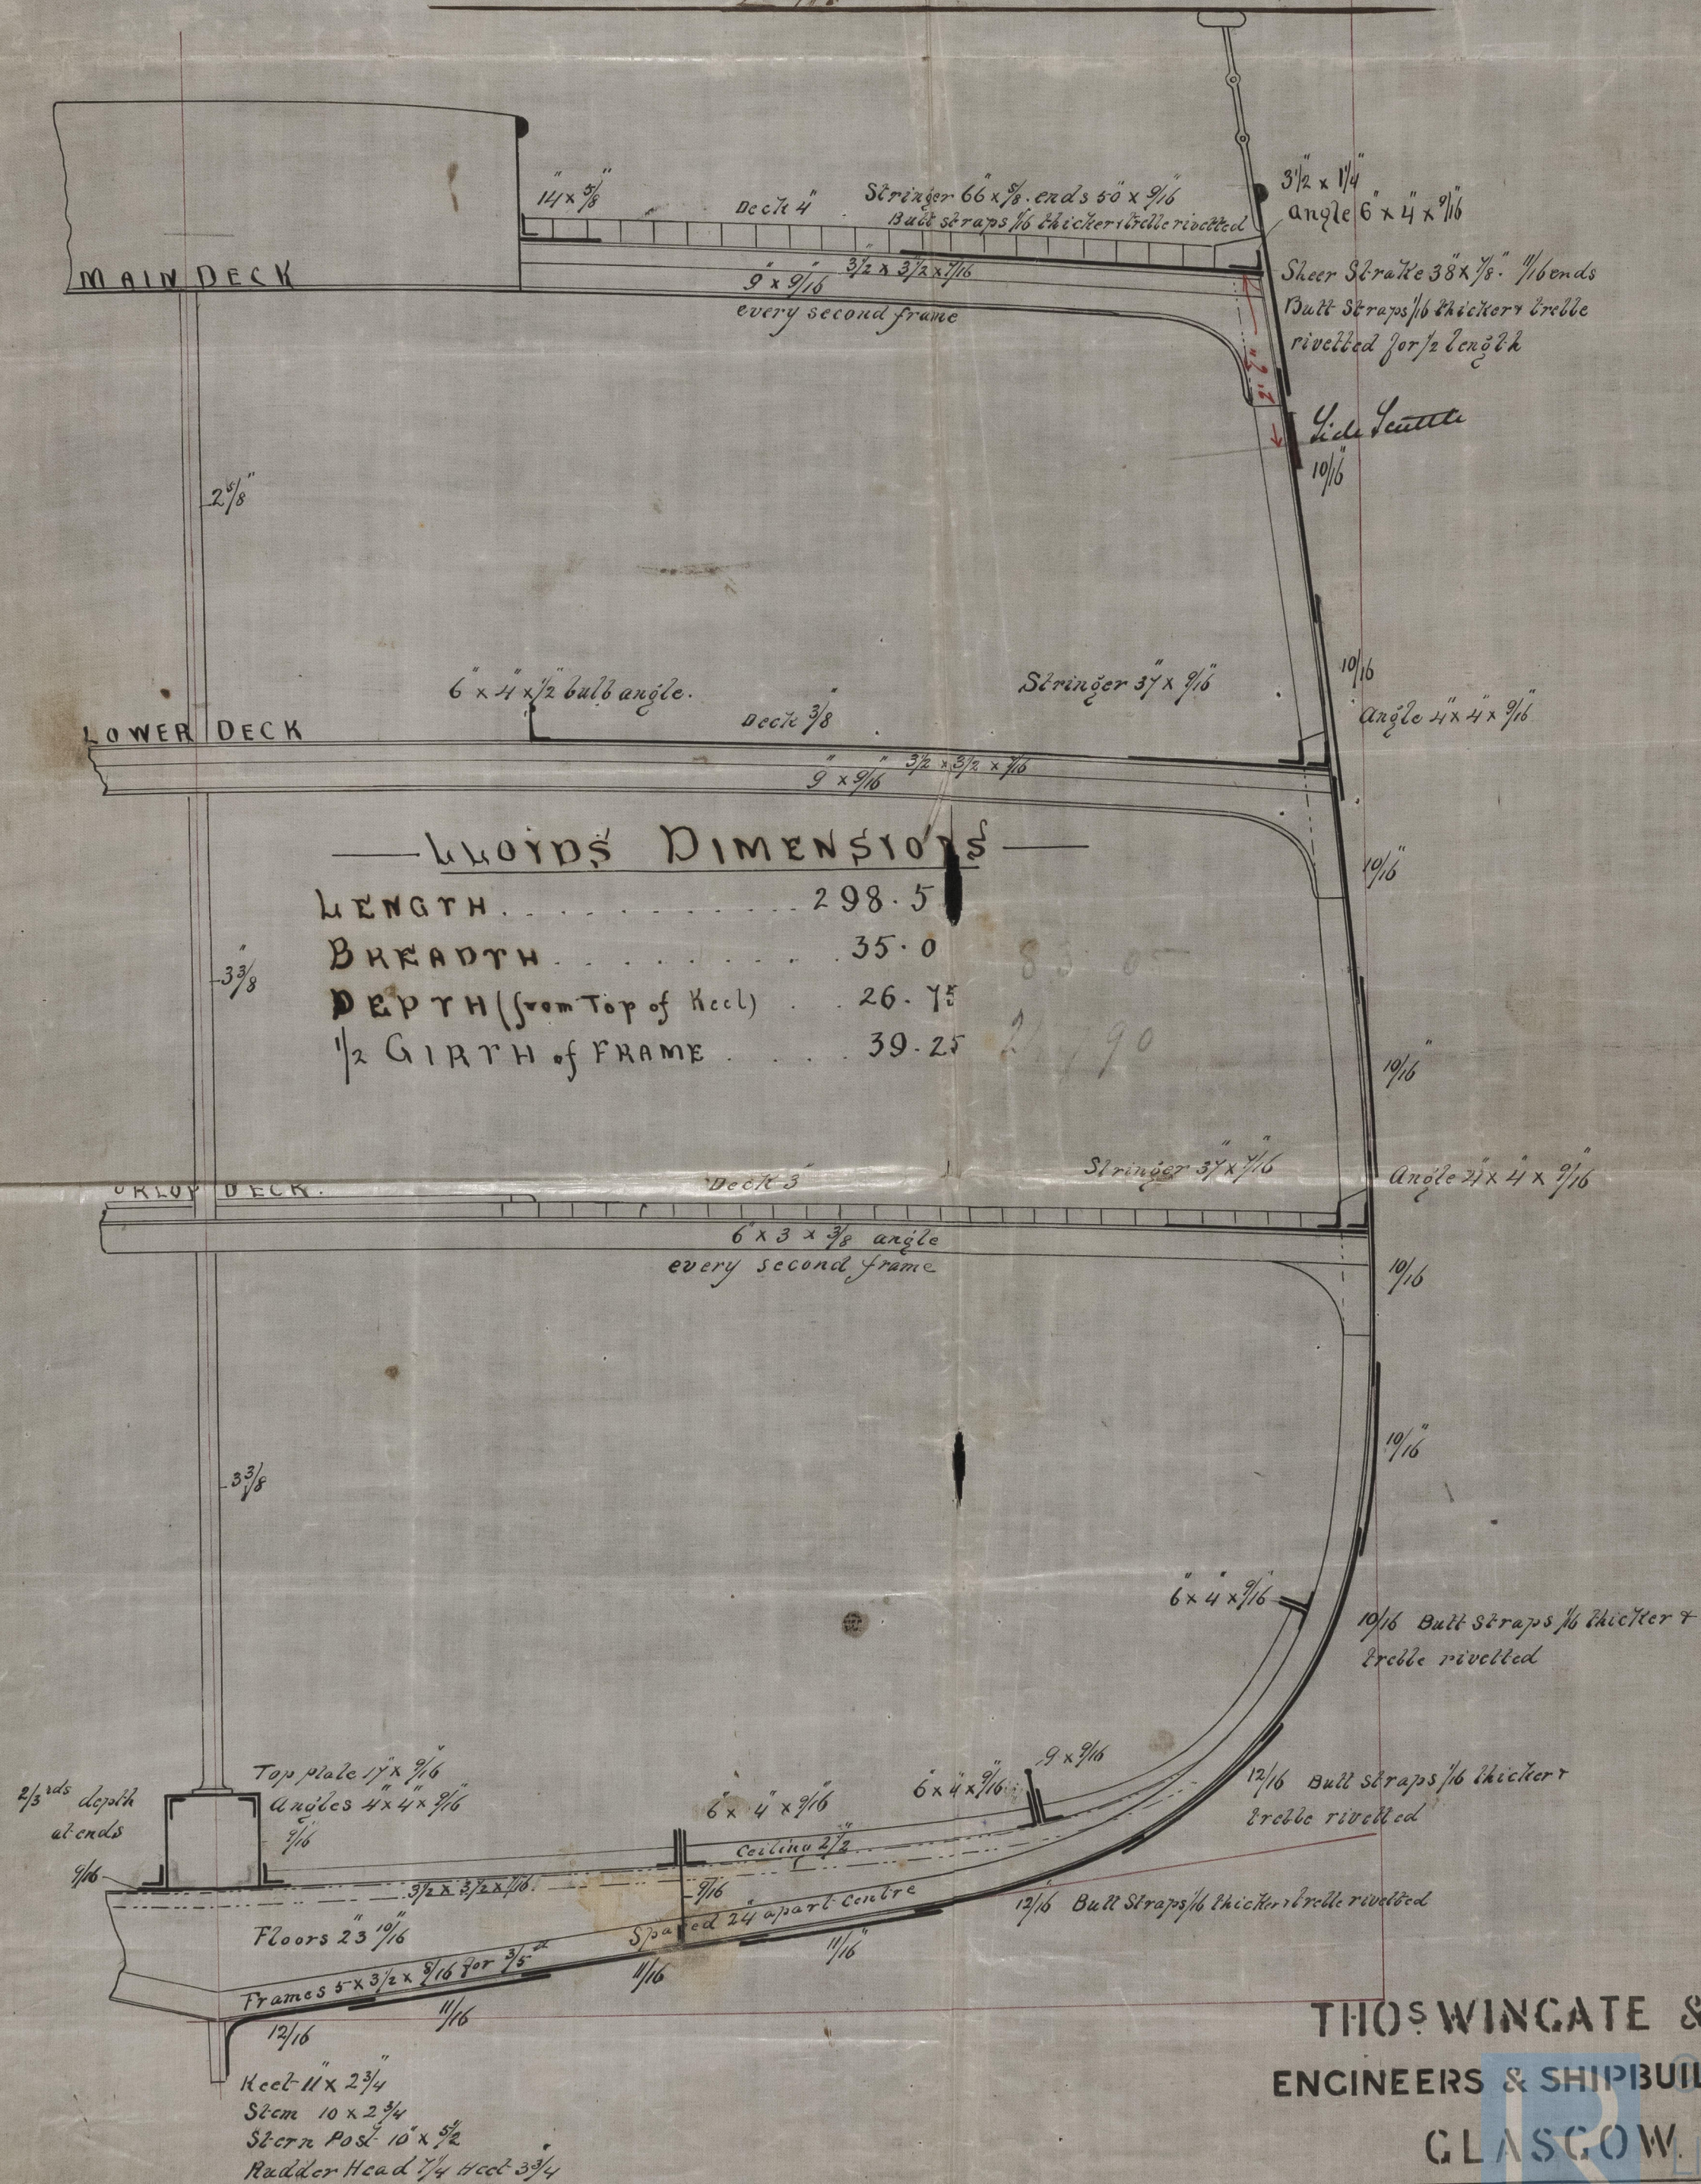

THOS WINGATE & CO
ENGINEERS & SHIPBUILDERS
GLASGOW.

GLASGOW

IRON506-coll