


John Blumer & Co  
Sunderland

$\frac{1}{2}$  inch Scale

24 June 1871

Dec 14/9/71 & 1/9/71  
M M

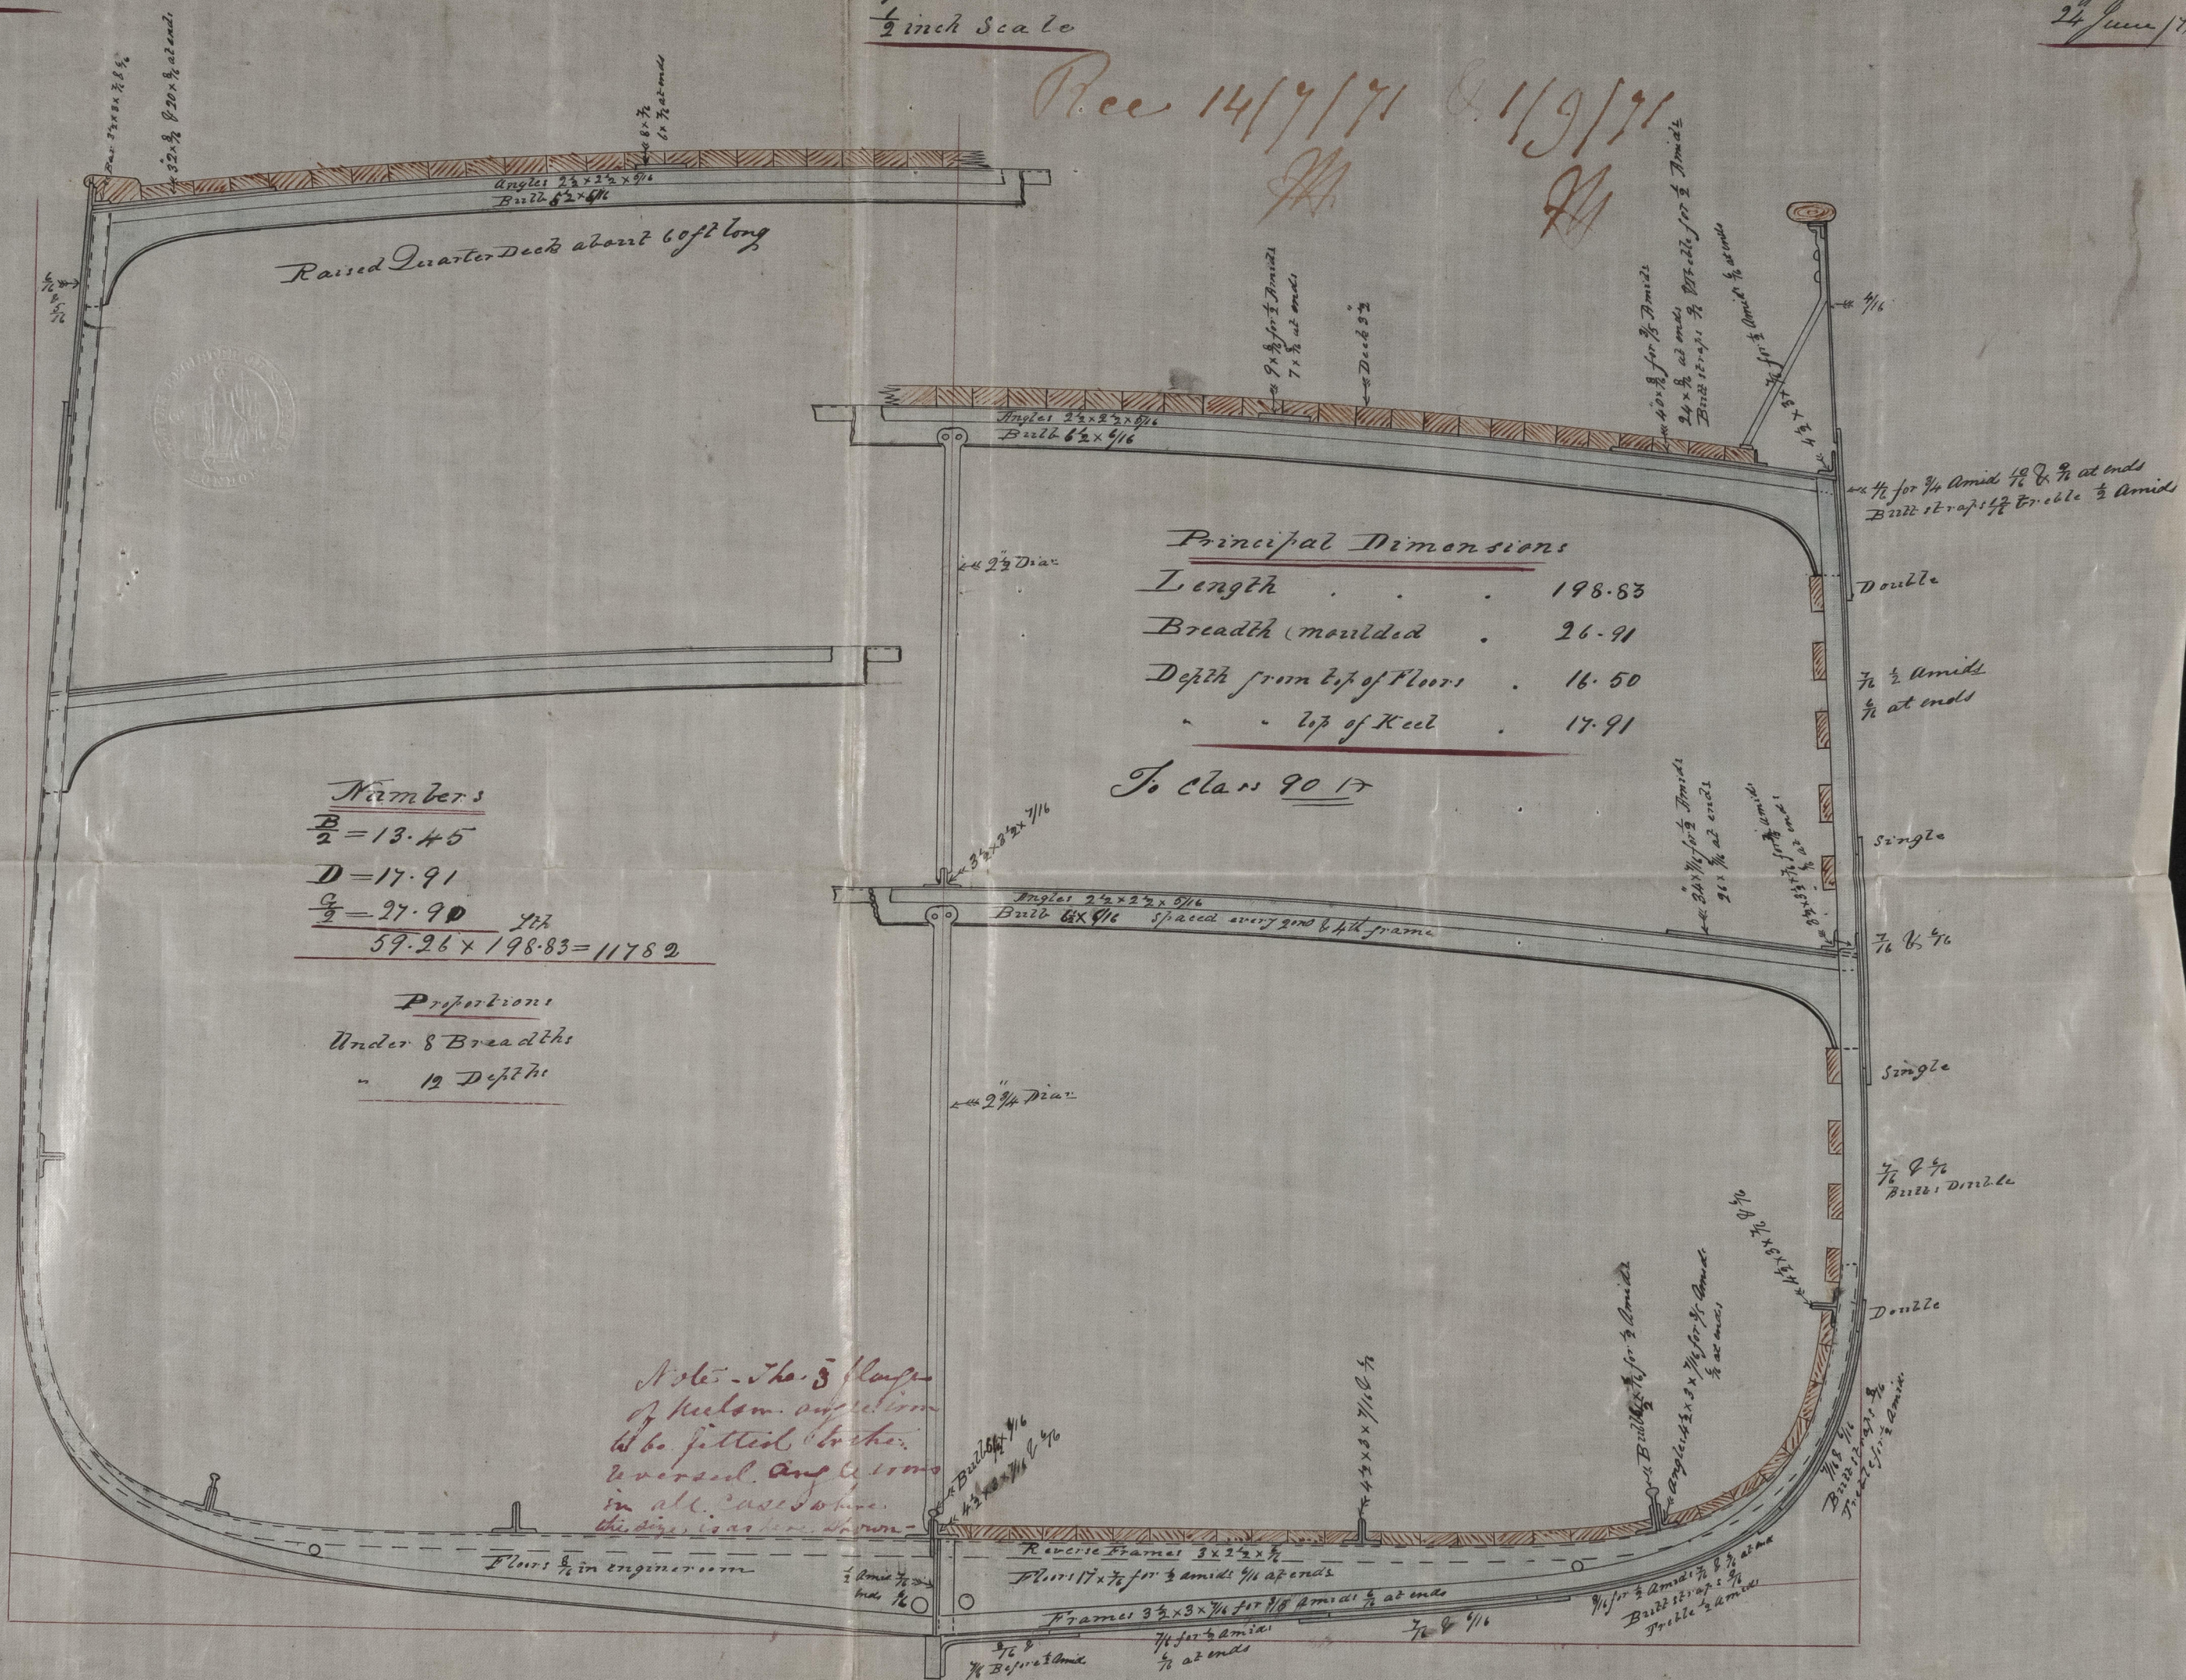

Keel  $7\frac{1}{2} \times 2\frac{1}{4}$   
 Stem  $7 \times 2\frac{1}{4}$   
 Post  $7\frac{1}{2} \times 4\frac{1}{8}$