


10682 Iron

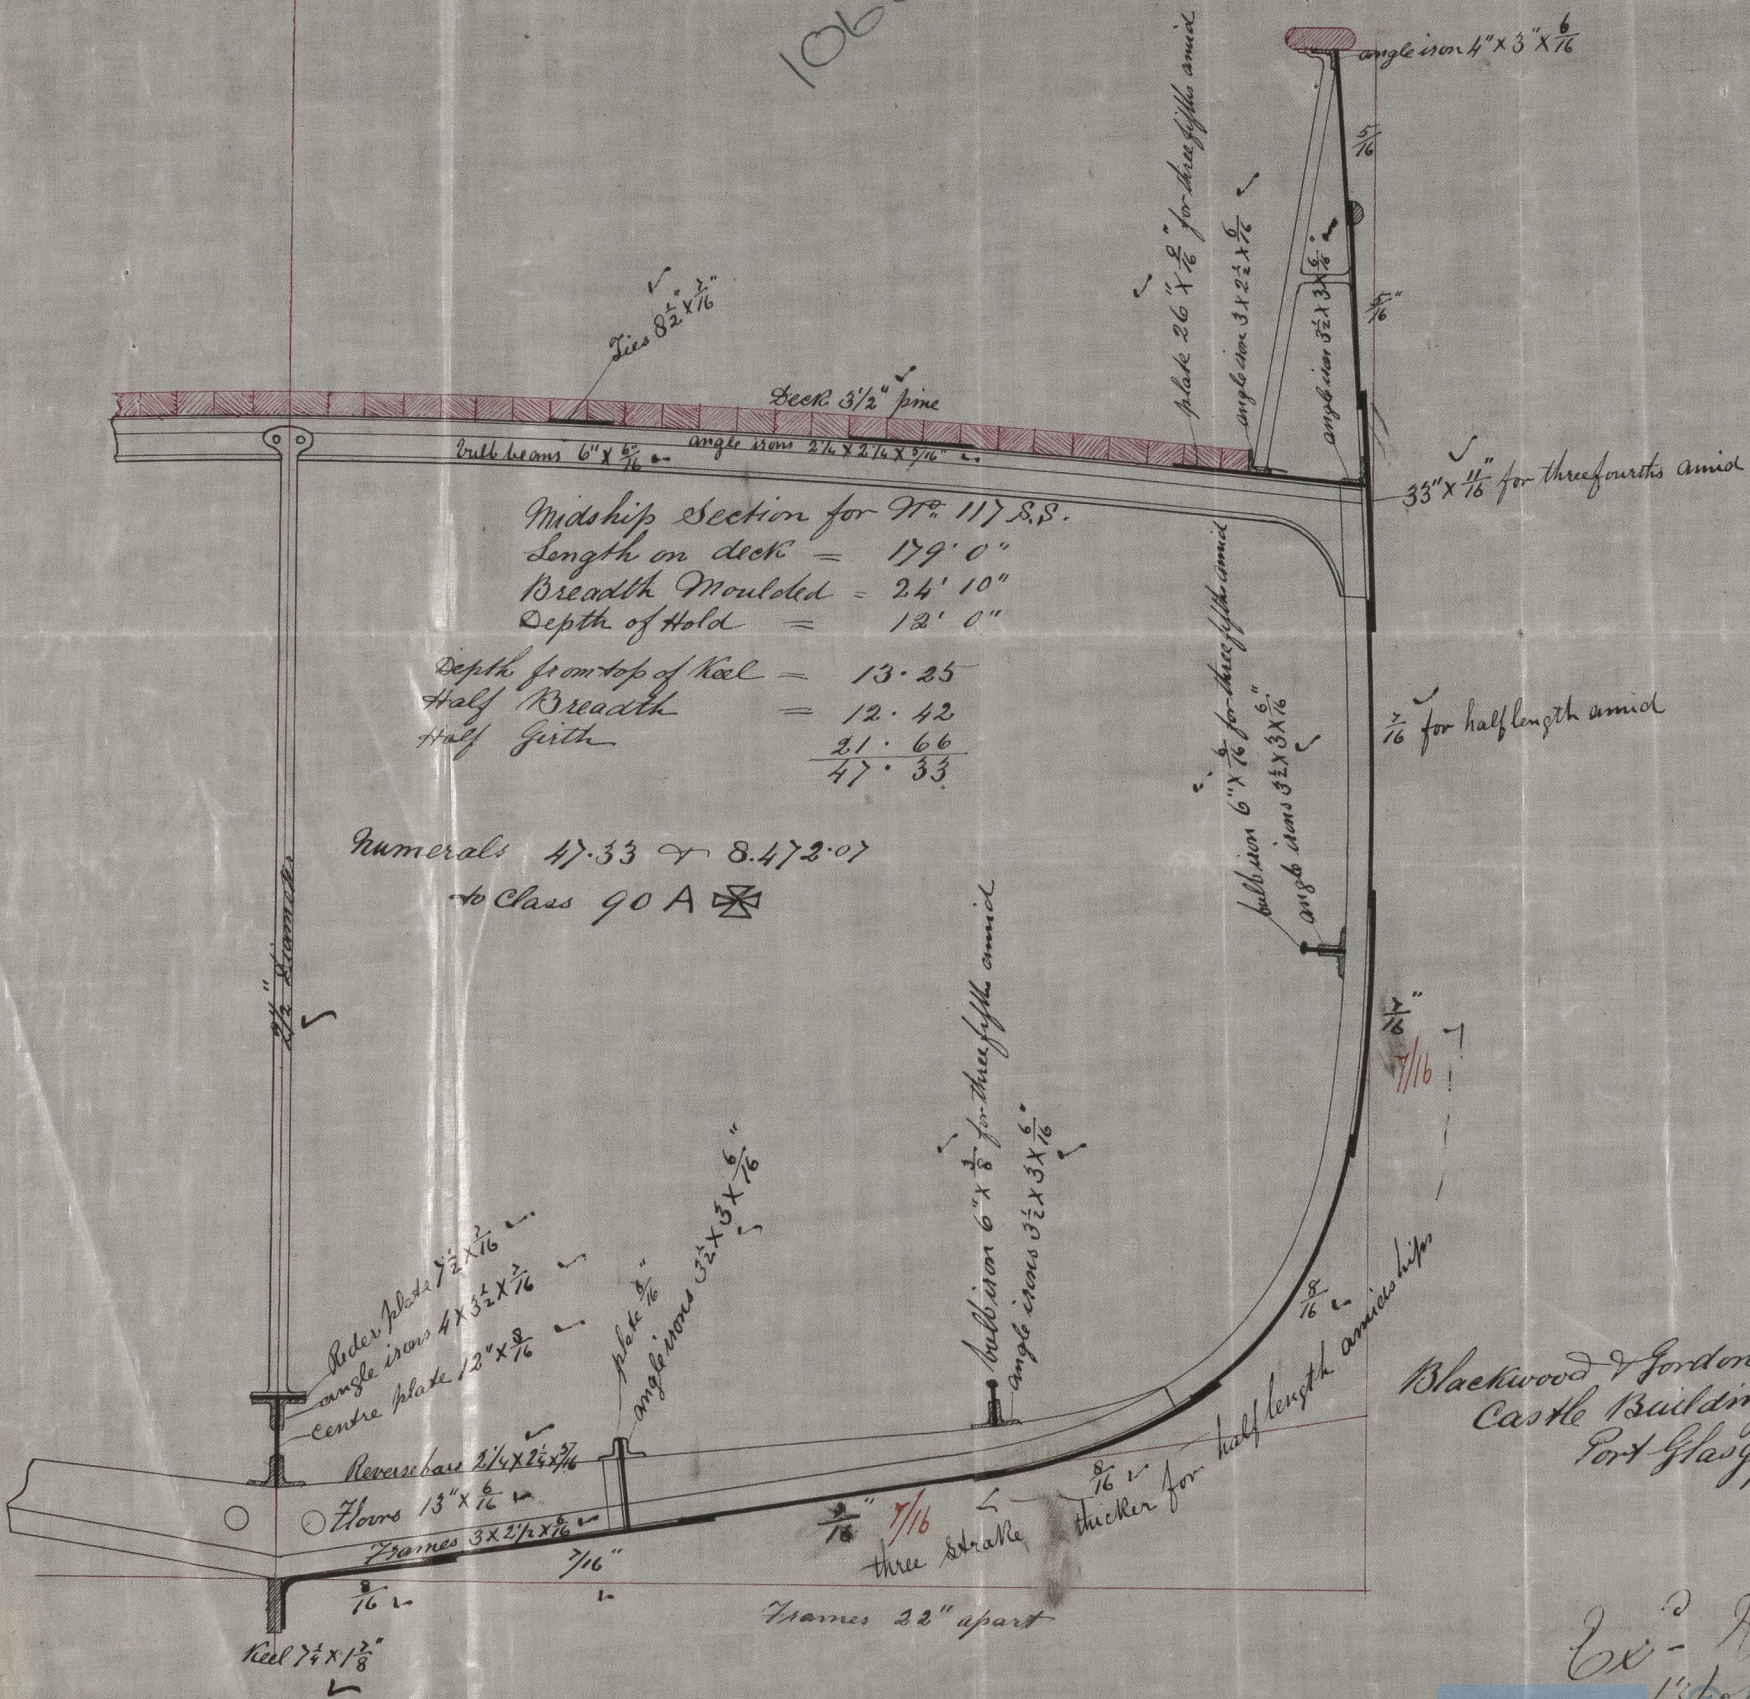

Blackwood & Gordon
 Castle Building Yard
 Port Glasgow
 12/10/11

Ex - RRL
 15/10/2021



Lloyd's Register
 Foundation