


Glasgow Report No 3569
- - do - - " 3554.

SCALE $\frac{1}{2}$ " INCH TO A FOOT

Im 10724

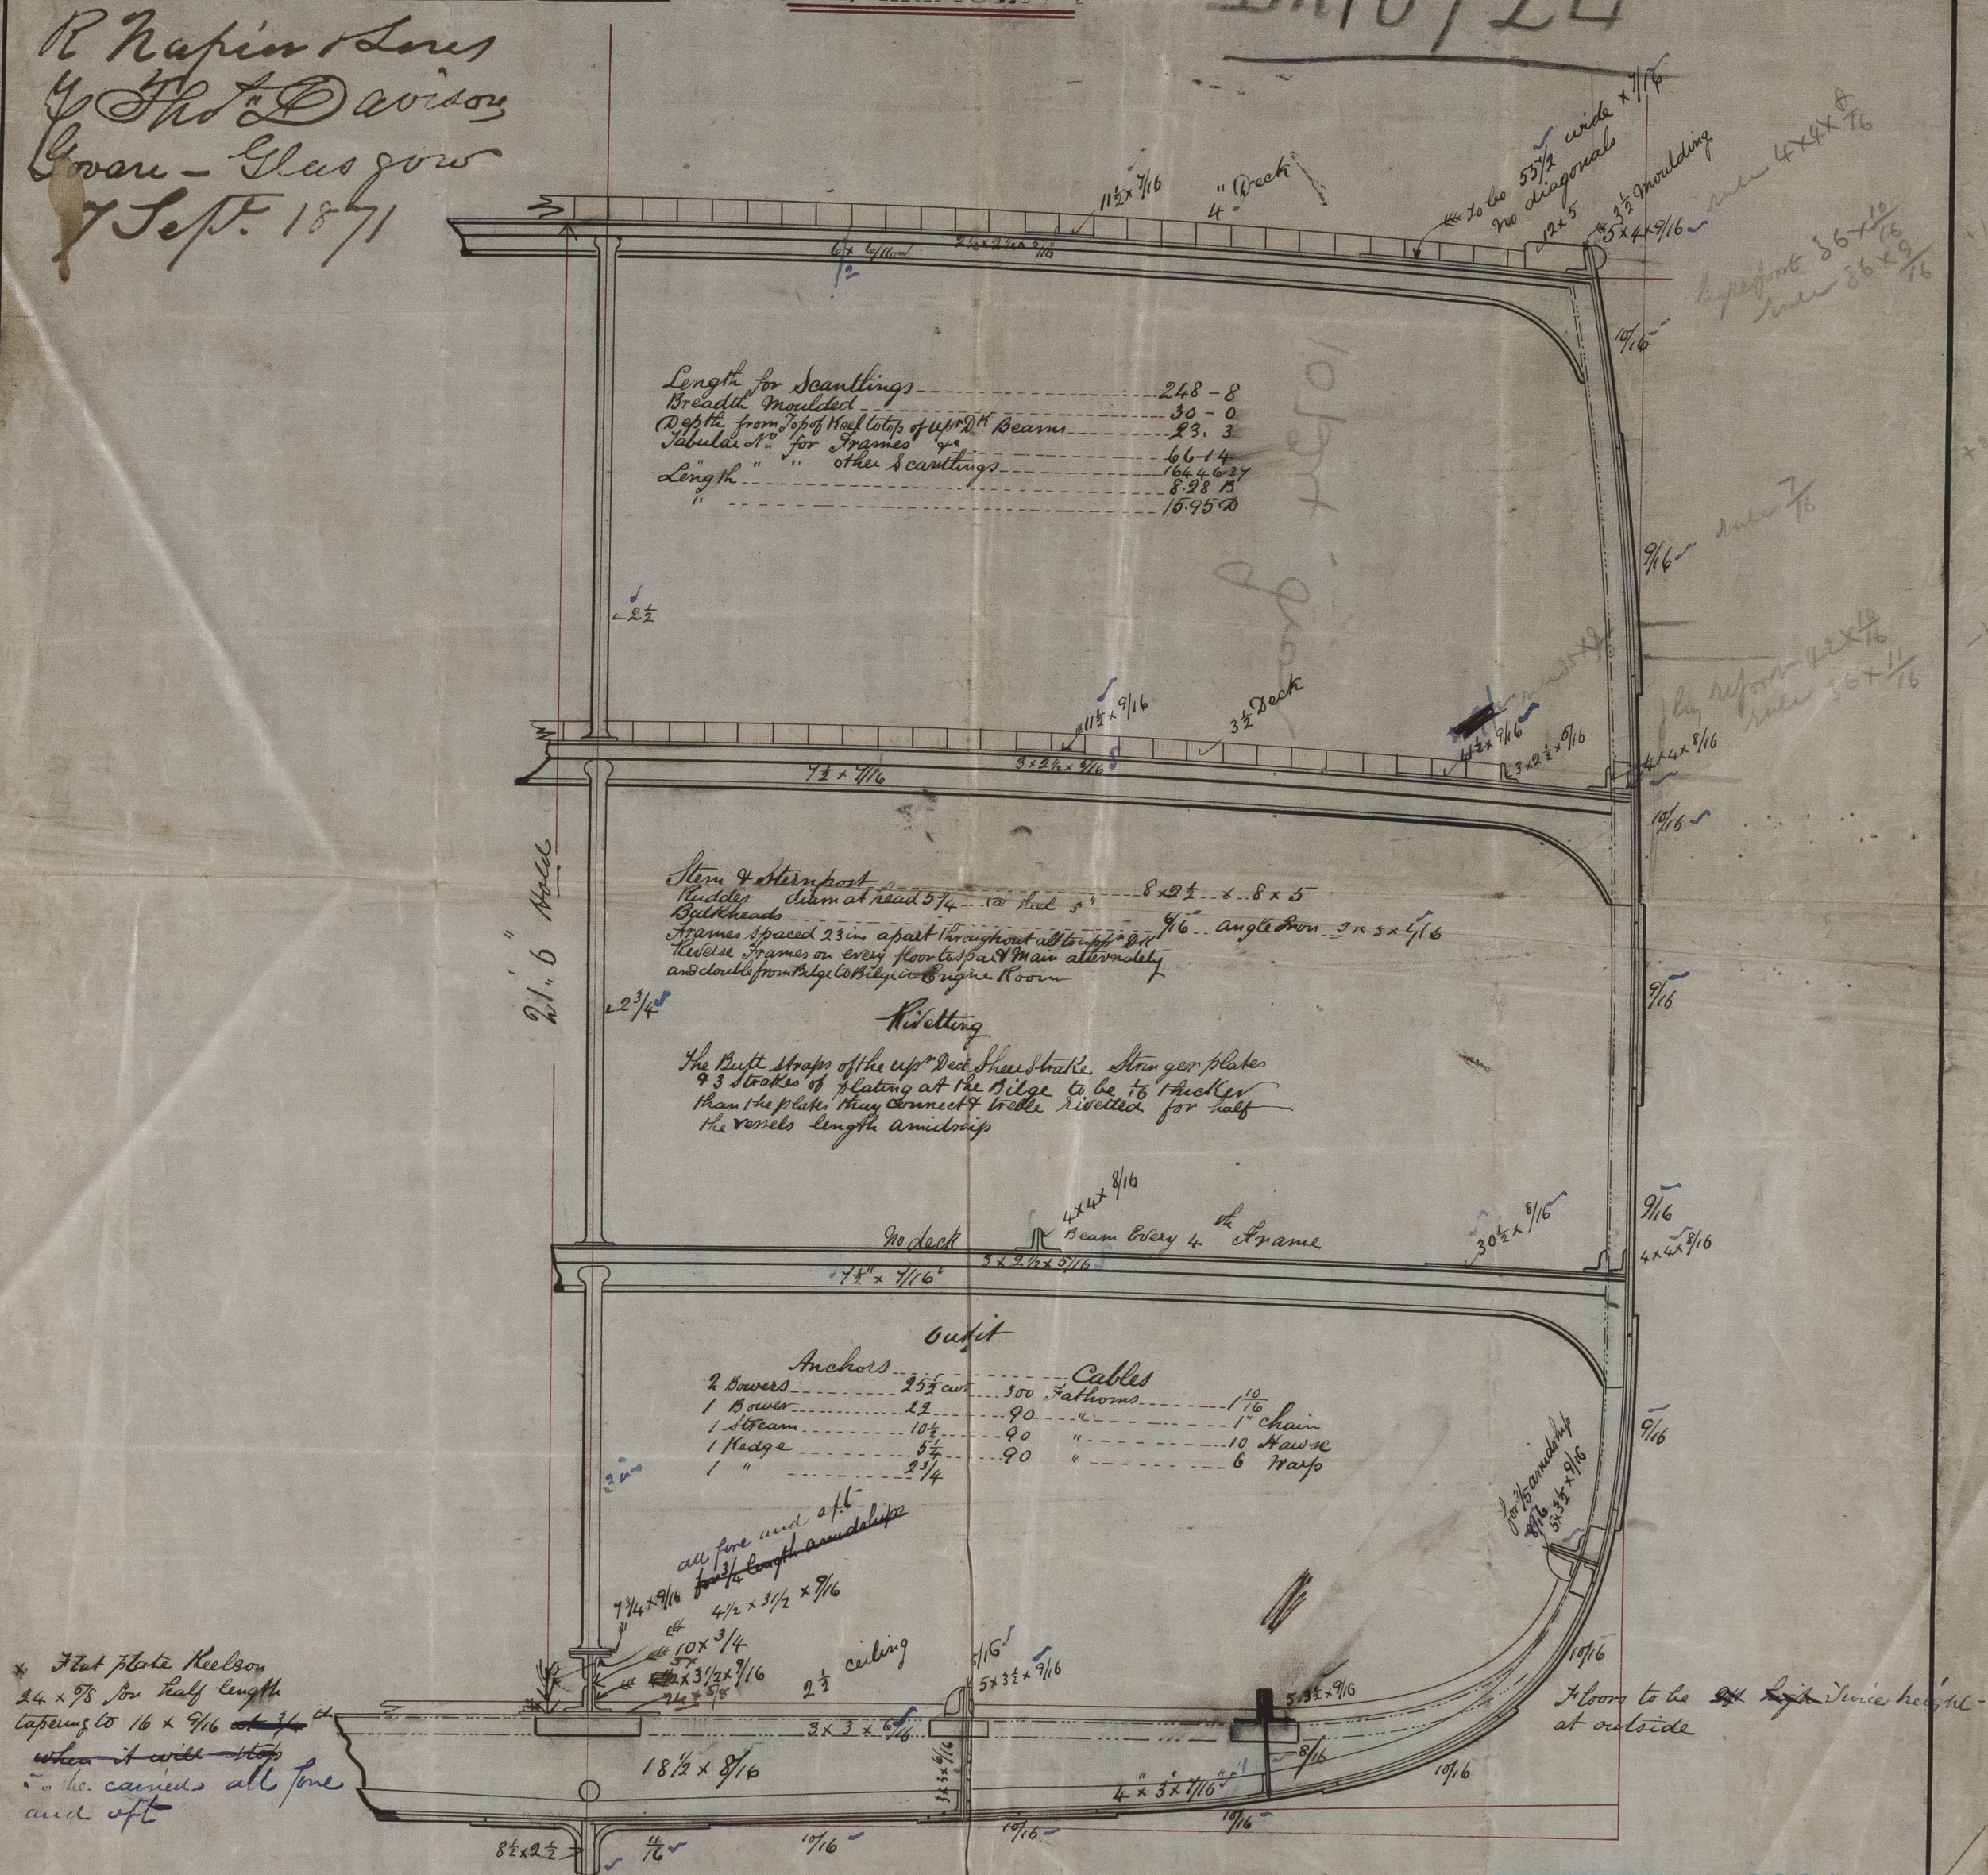

10724 Iron

IRON 506-0043



© 2021

Lloyd's Register
Foundation