
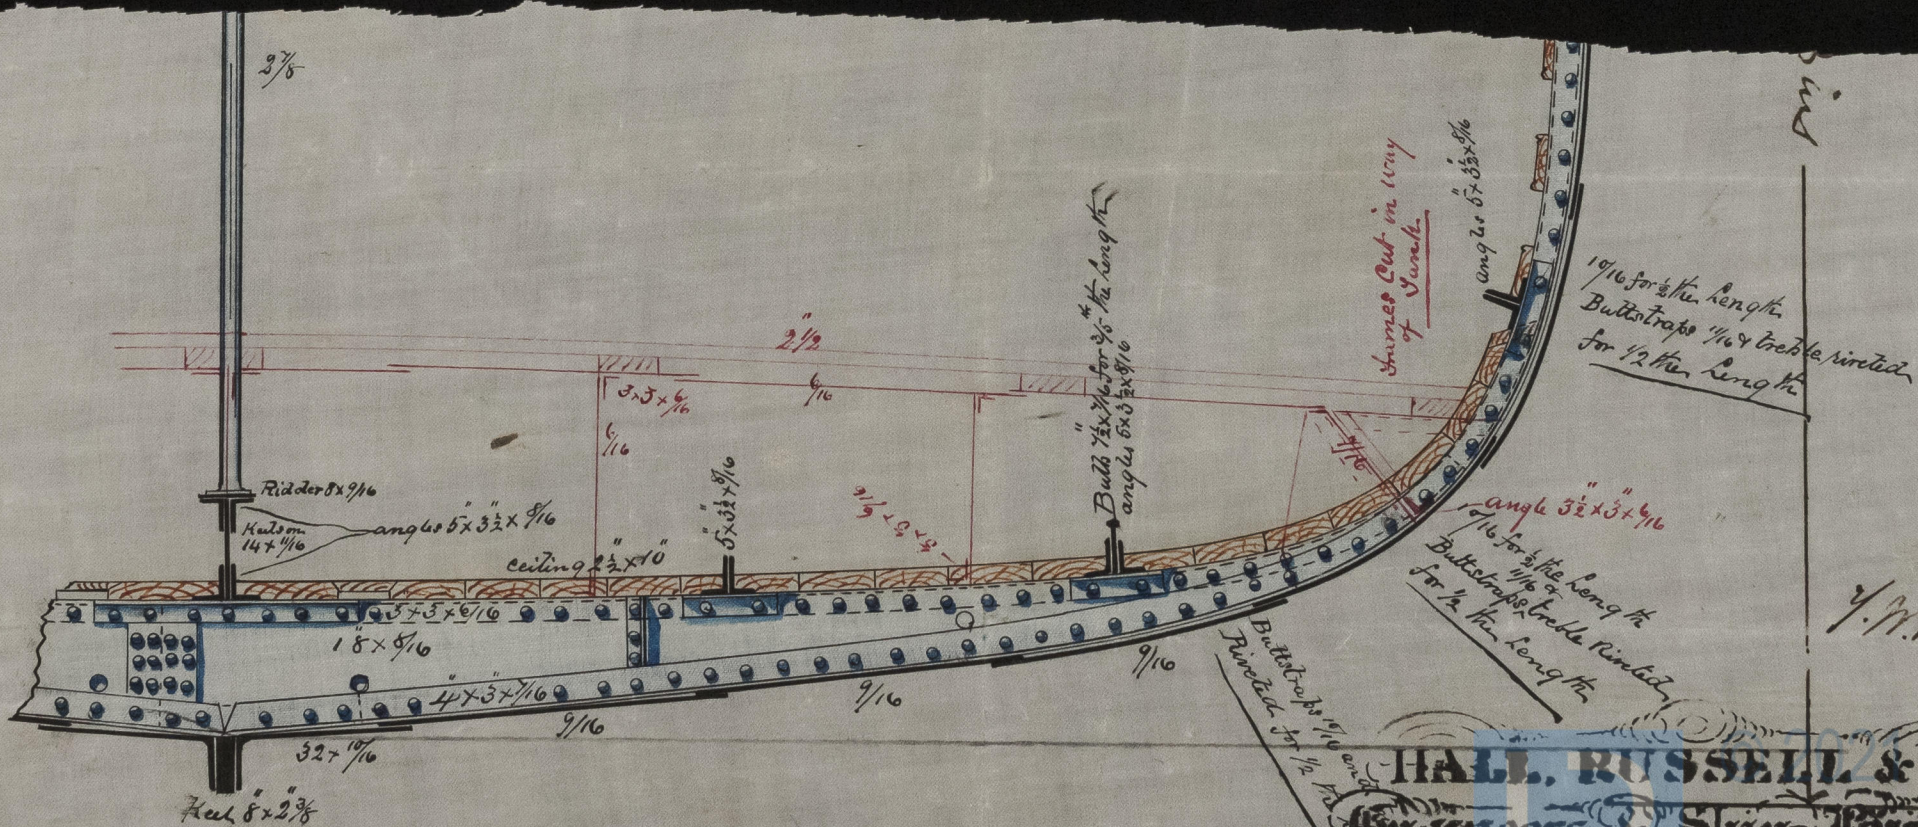


S.S. ⁴ Namoda

N° for Scaantling $15.5 + 18.96 + 30.08 = 64.53 \times 238.75 = 15406$ N° for Equipment 3778
 Diagonal $4\frac{1}{2} \times \frac{1}{16}$
 Deck $5 \times 2\frac{1}{4}$
 Angles $5 \times 3\frac{1}{2} \times \frac{1}{16}$
 Stringer $3\frac{1}{2} \times \frac{1}{16}$
 angles $3\frac{1}{2} \times 3\frac{1}{2} \times \frac{1}{16}$

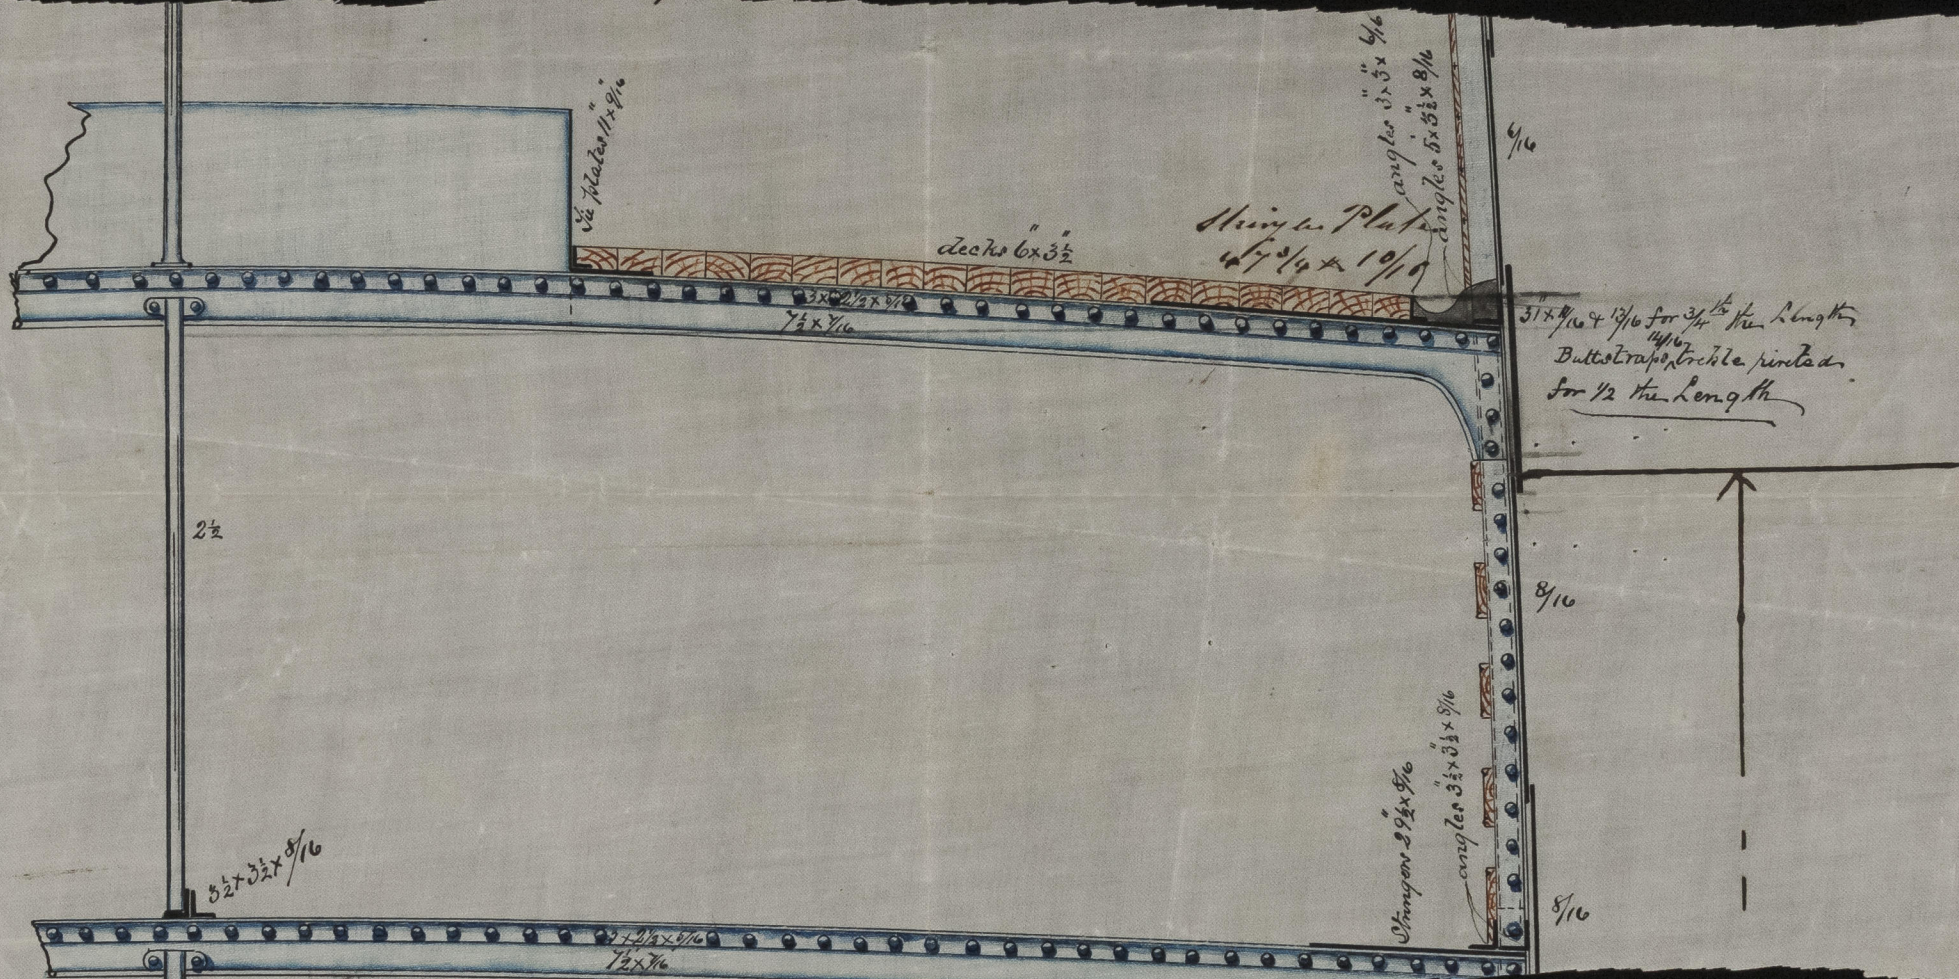

Scale $\frac{1}{2}$ Inch to a Foot

HALL, RUSSELL & CO
Engineers & Shipbuilders
ABERDEEN.

IRUNSOB-0001 $\frac{1}{3}$