



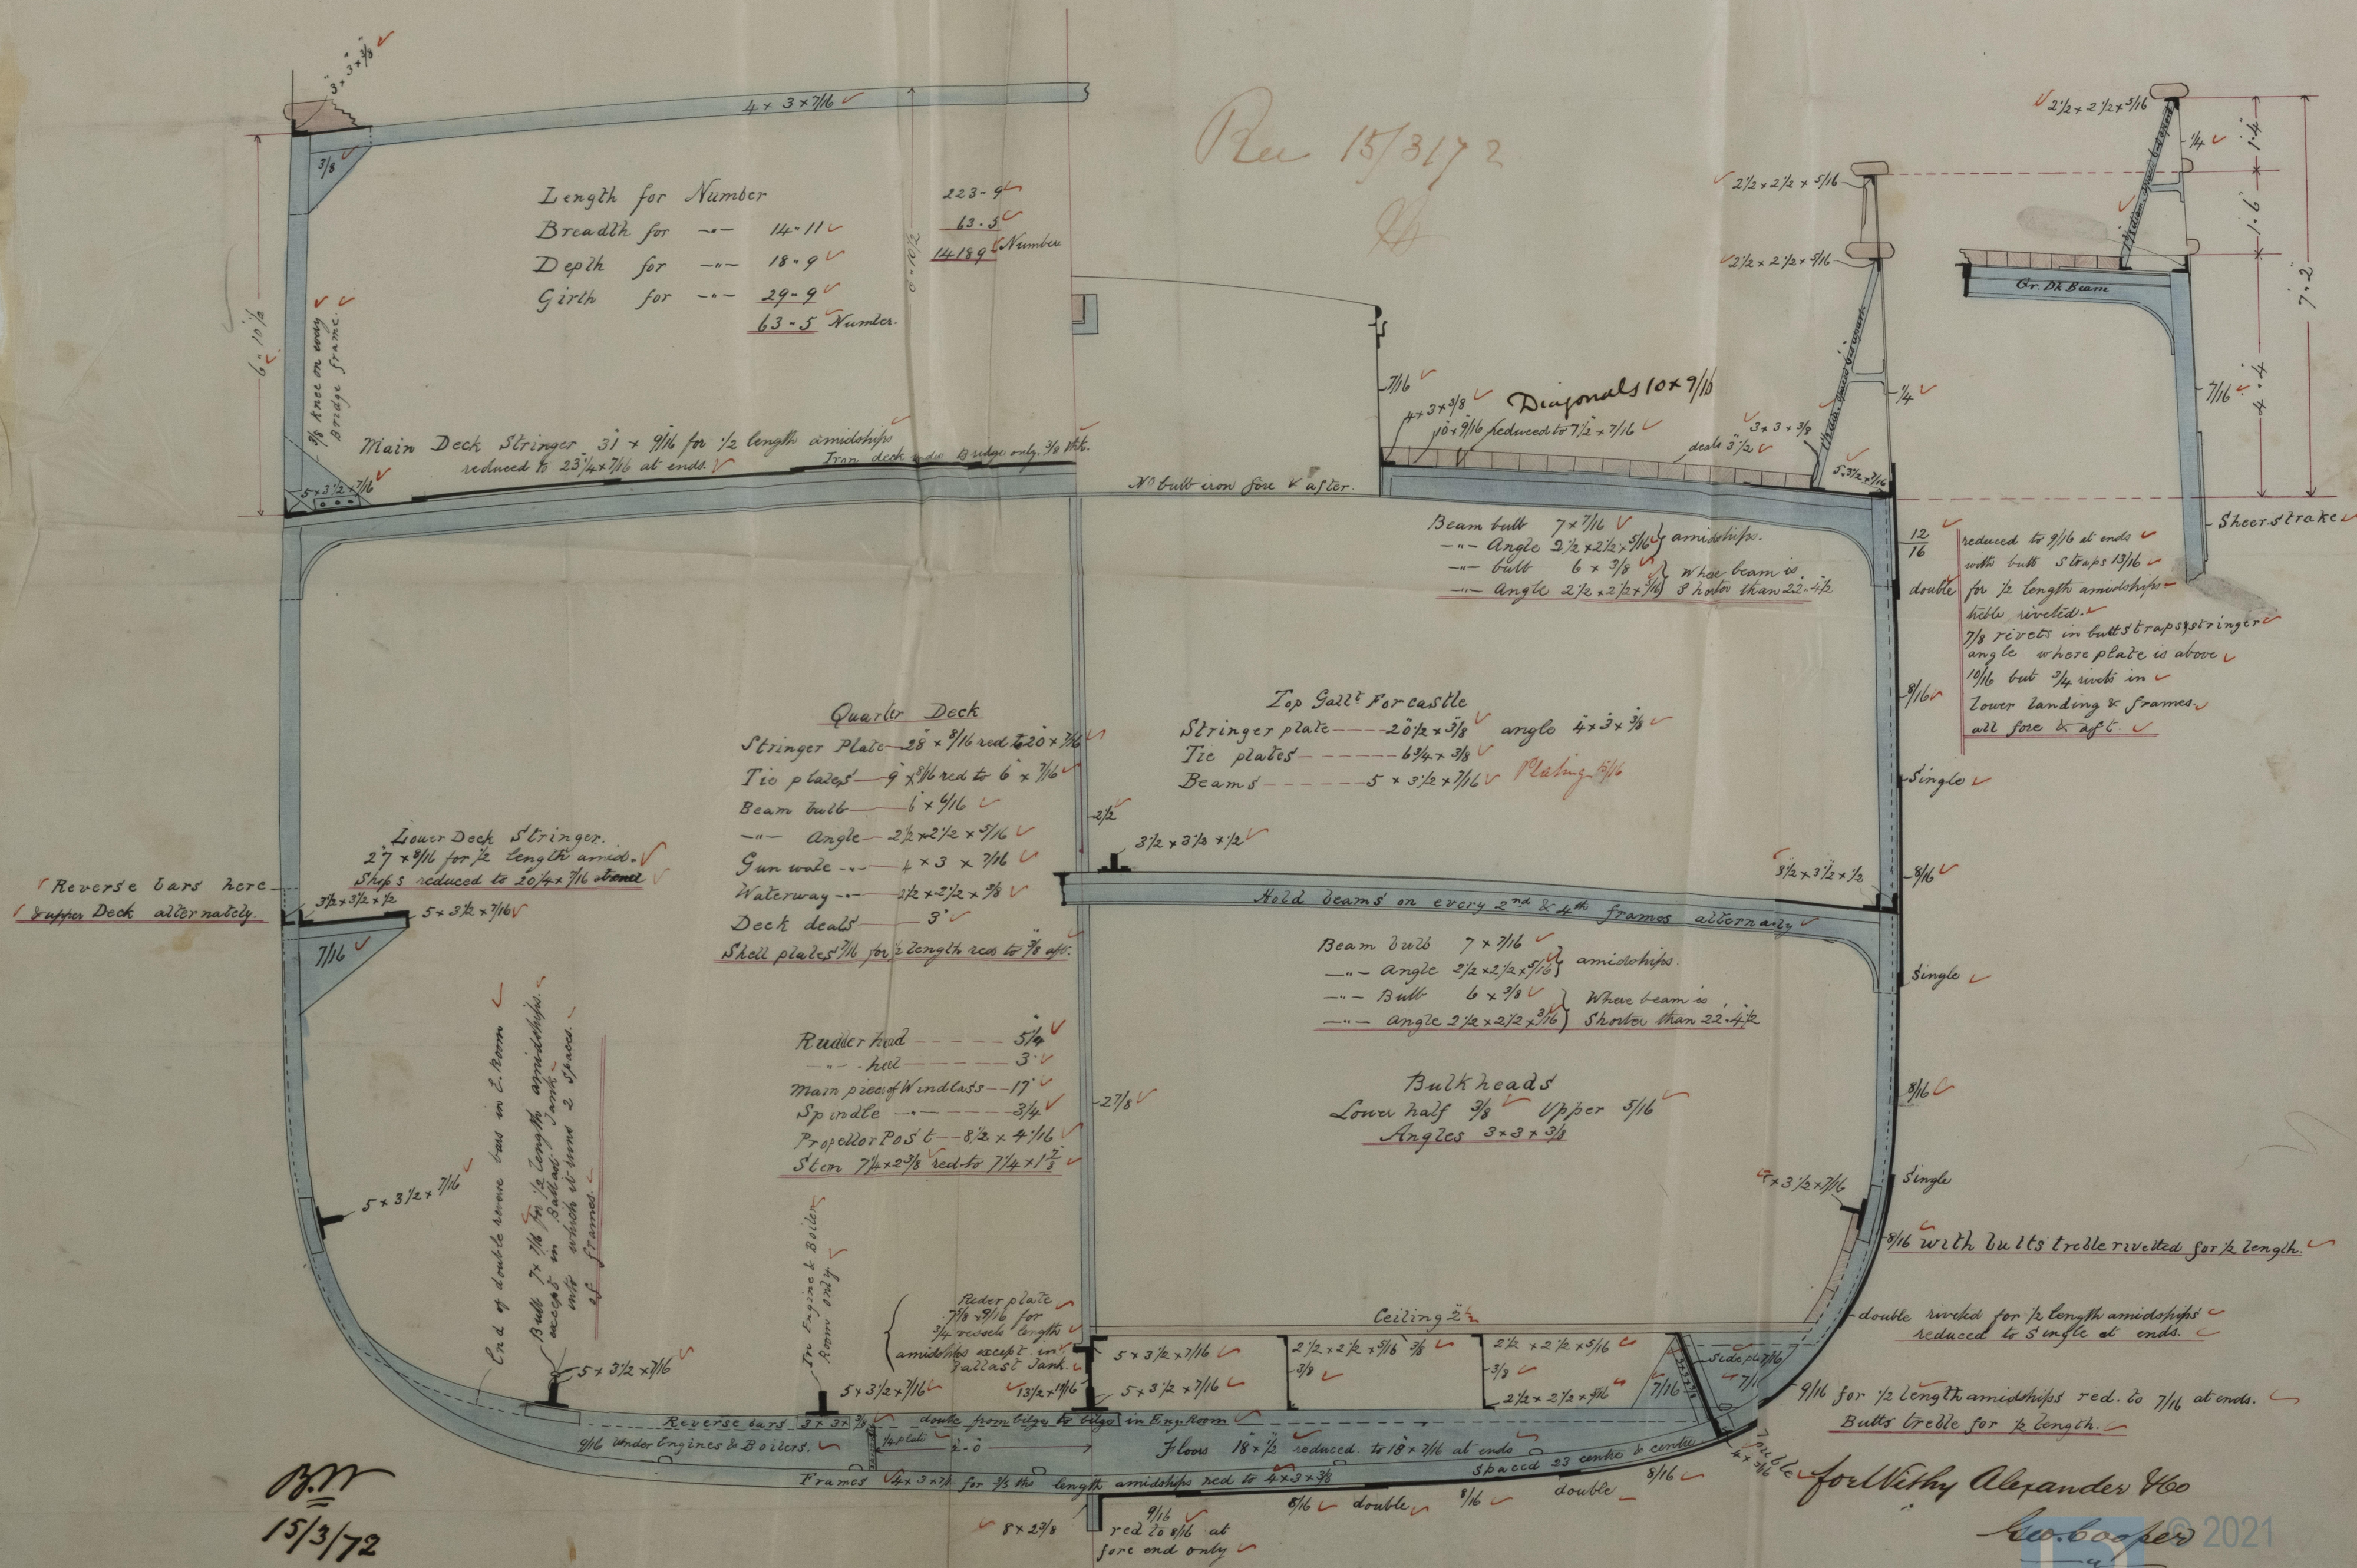

For Wm. Alexander Geo

Geo. Cooper © 2021