


S. S. "Altona" Arrangement of Quarter Deck
 — and Bulkheads & No 79 ss —

Report No 3128

Tracing No 1092

Plan 10/4/72 & 22/4/72
 P. H.

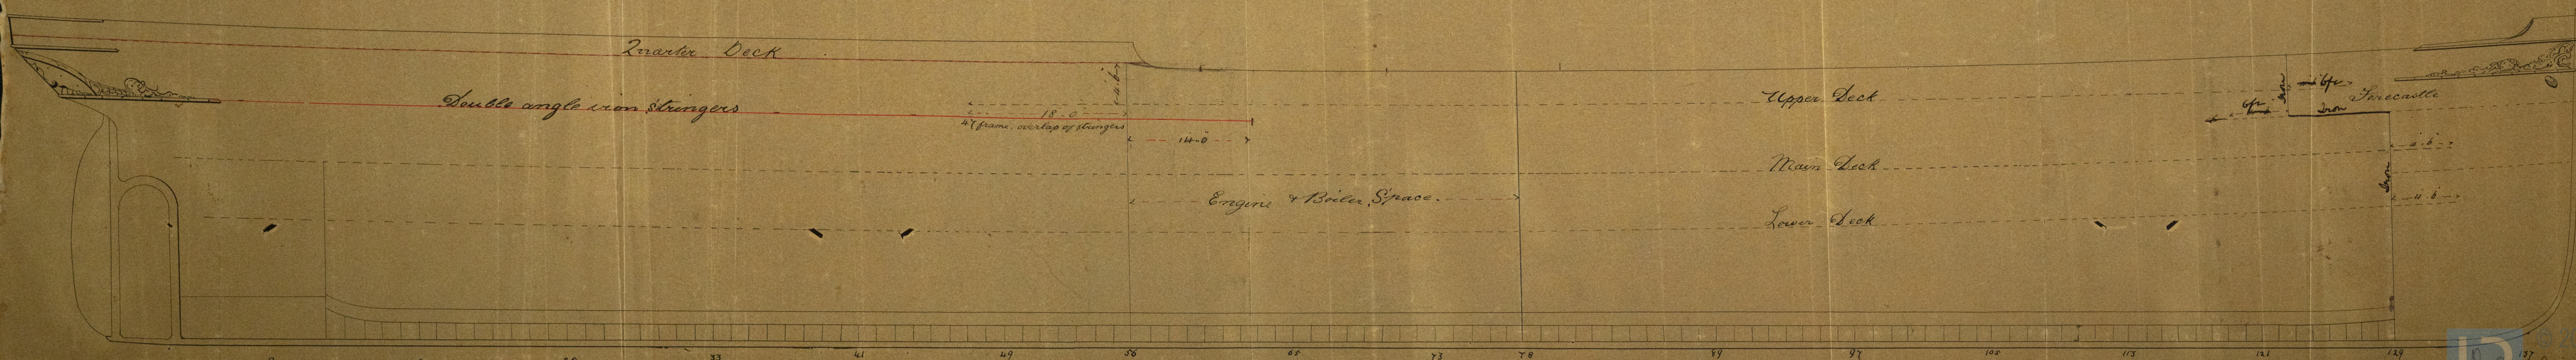

B.M.
 12/4/72
 23/4/72

BACKHOUSE & DIXON
 Iron Ship Builders
 MEDLANDS ROAD, LONDON
 Feb-29th 1872

© 2021
 Lloyd's Register
 Foundation