


# Midship Section of No. 4.

Dimensions ft. inches.  
 Length between pers 300. 0  
 Beam 34. 0  
 Depth extreme 25 9  

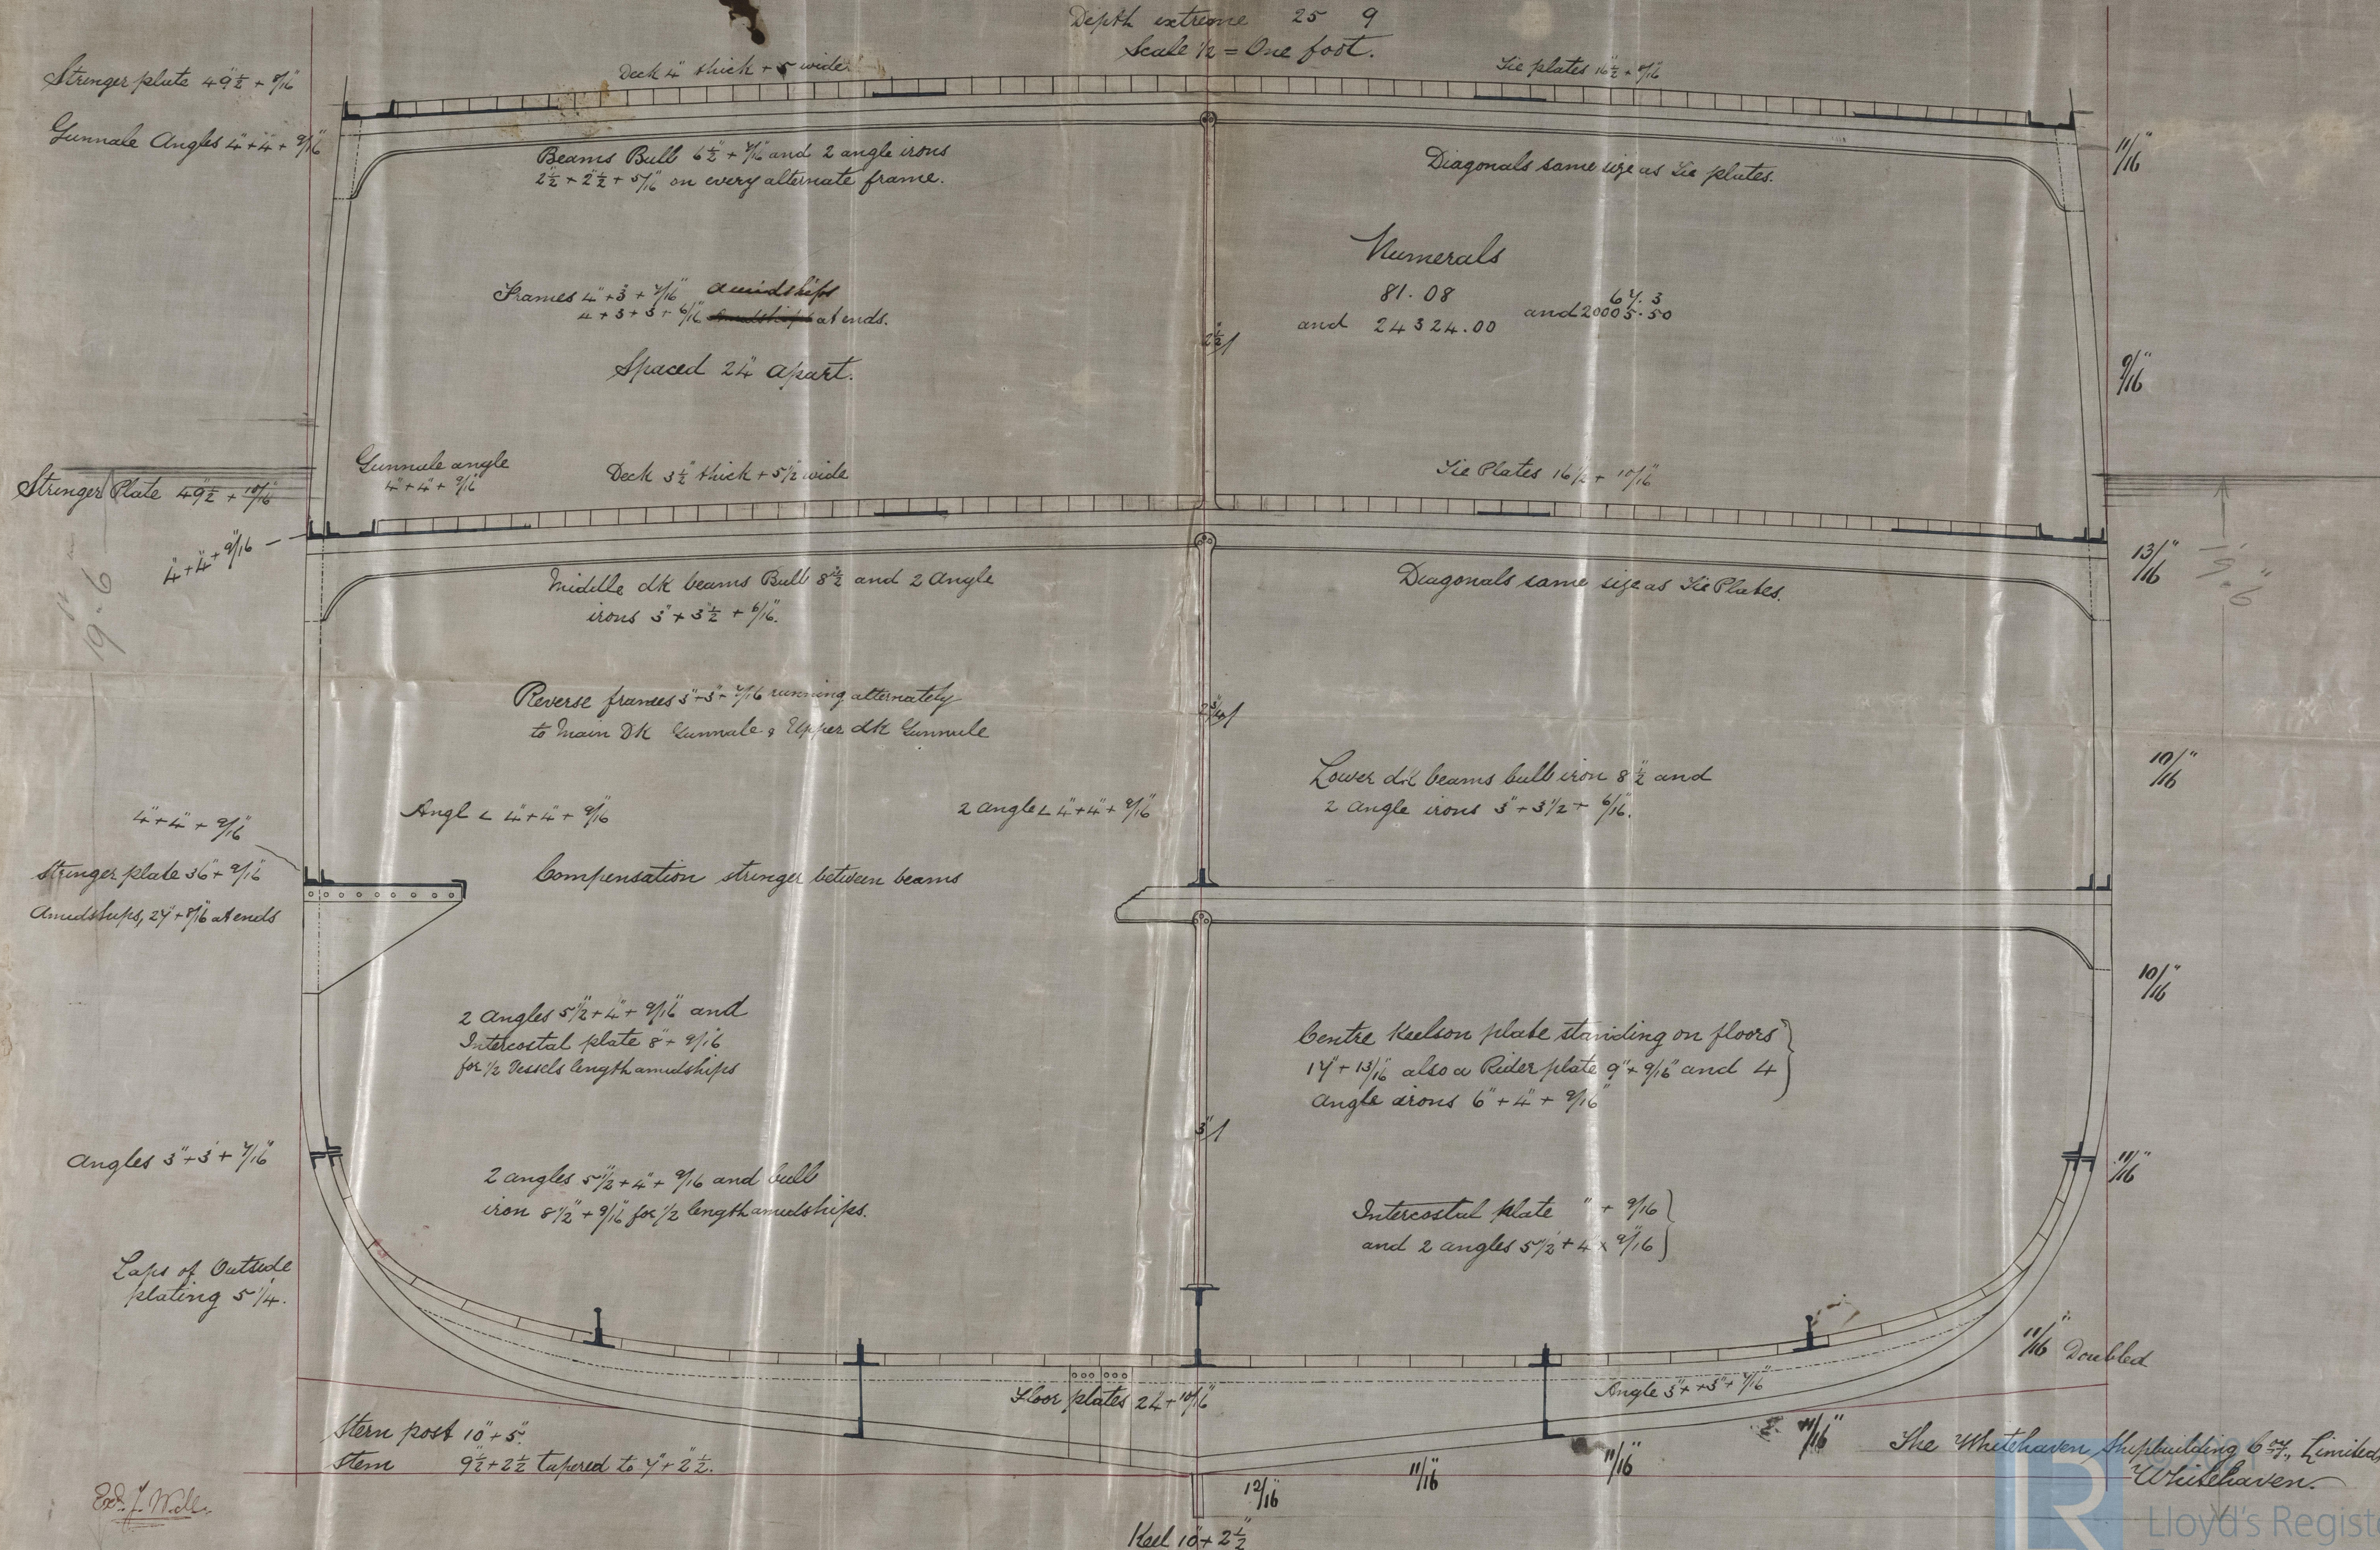

Numerals

81.08 and 24324.00 and 20005.50