



Dimensions
Length 300.0
Breadth 34.0
Depth 23.6

Three decked - screw Steamer W.S.

Scale to which to one Foot.
Rev 27/8/72

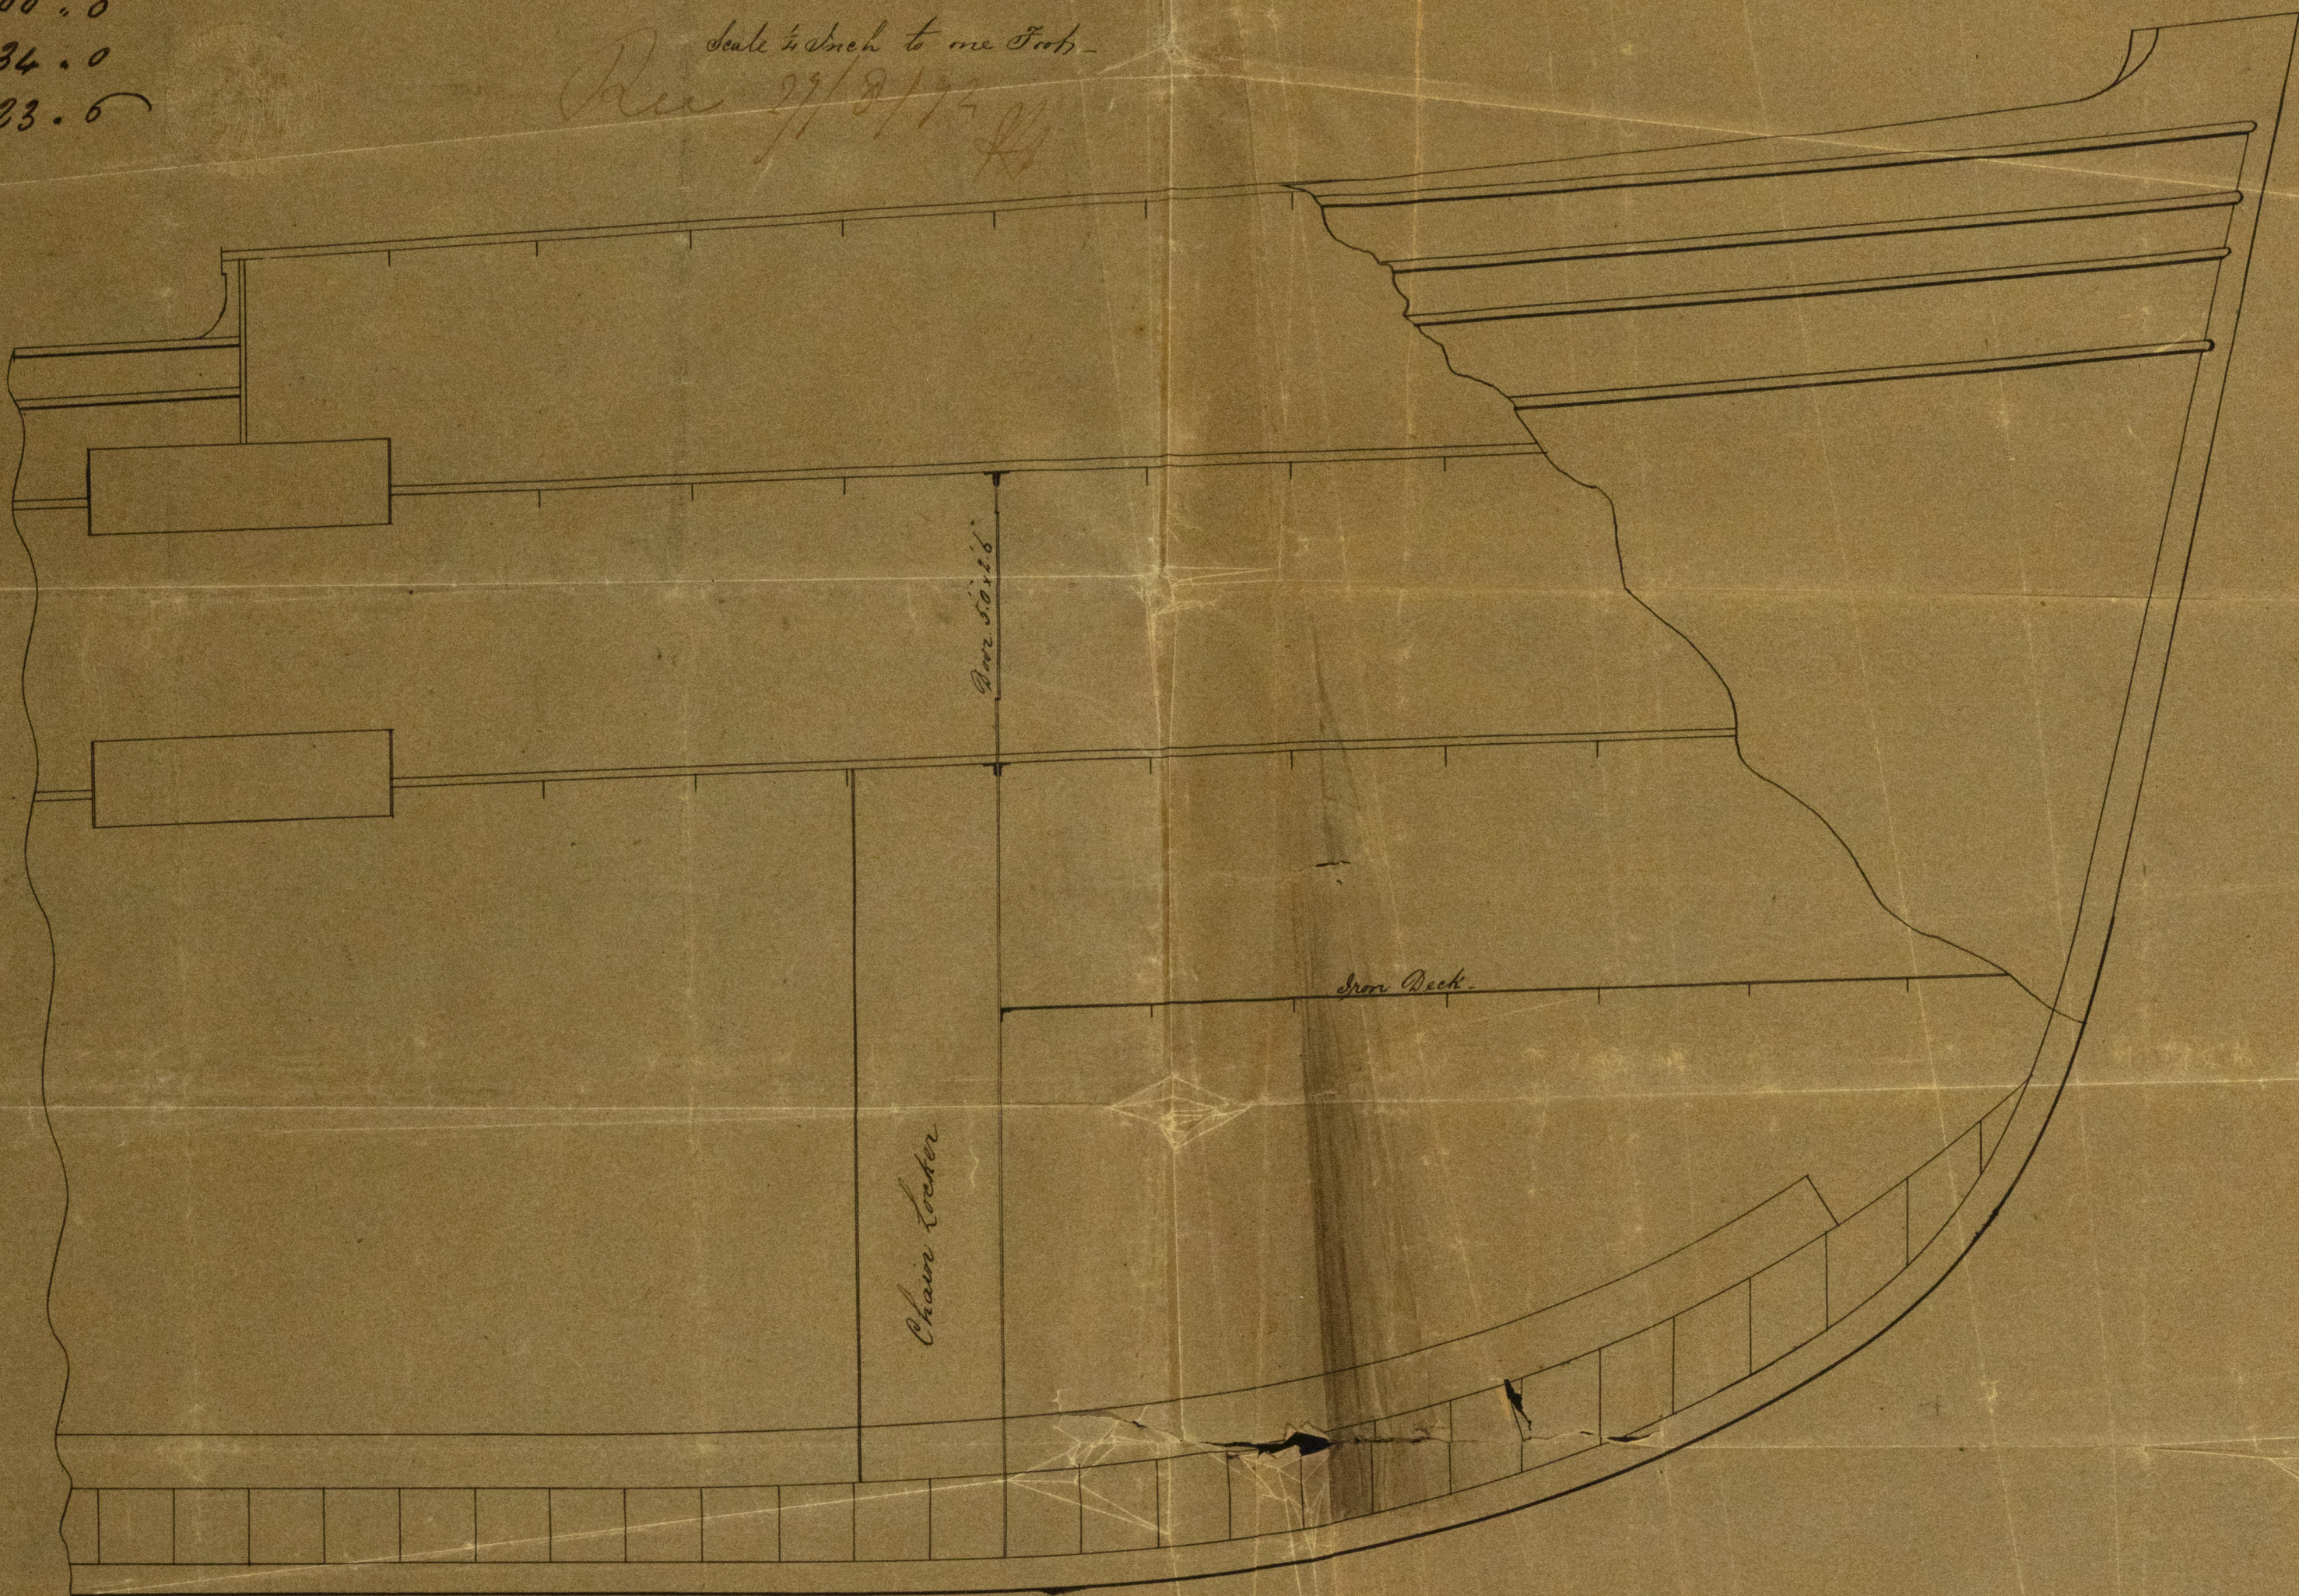

The Whitehaven Shipbuilding Co. Limited
Whitehaven

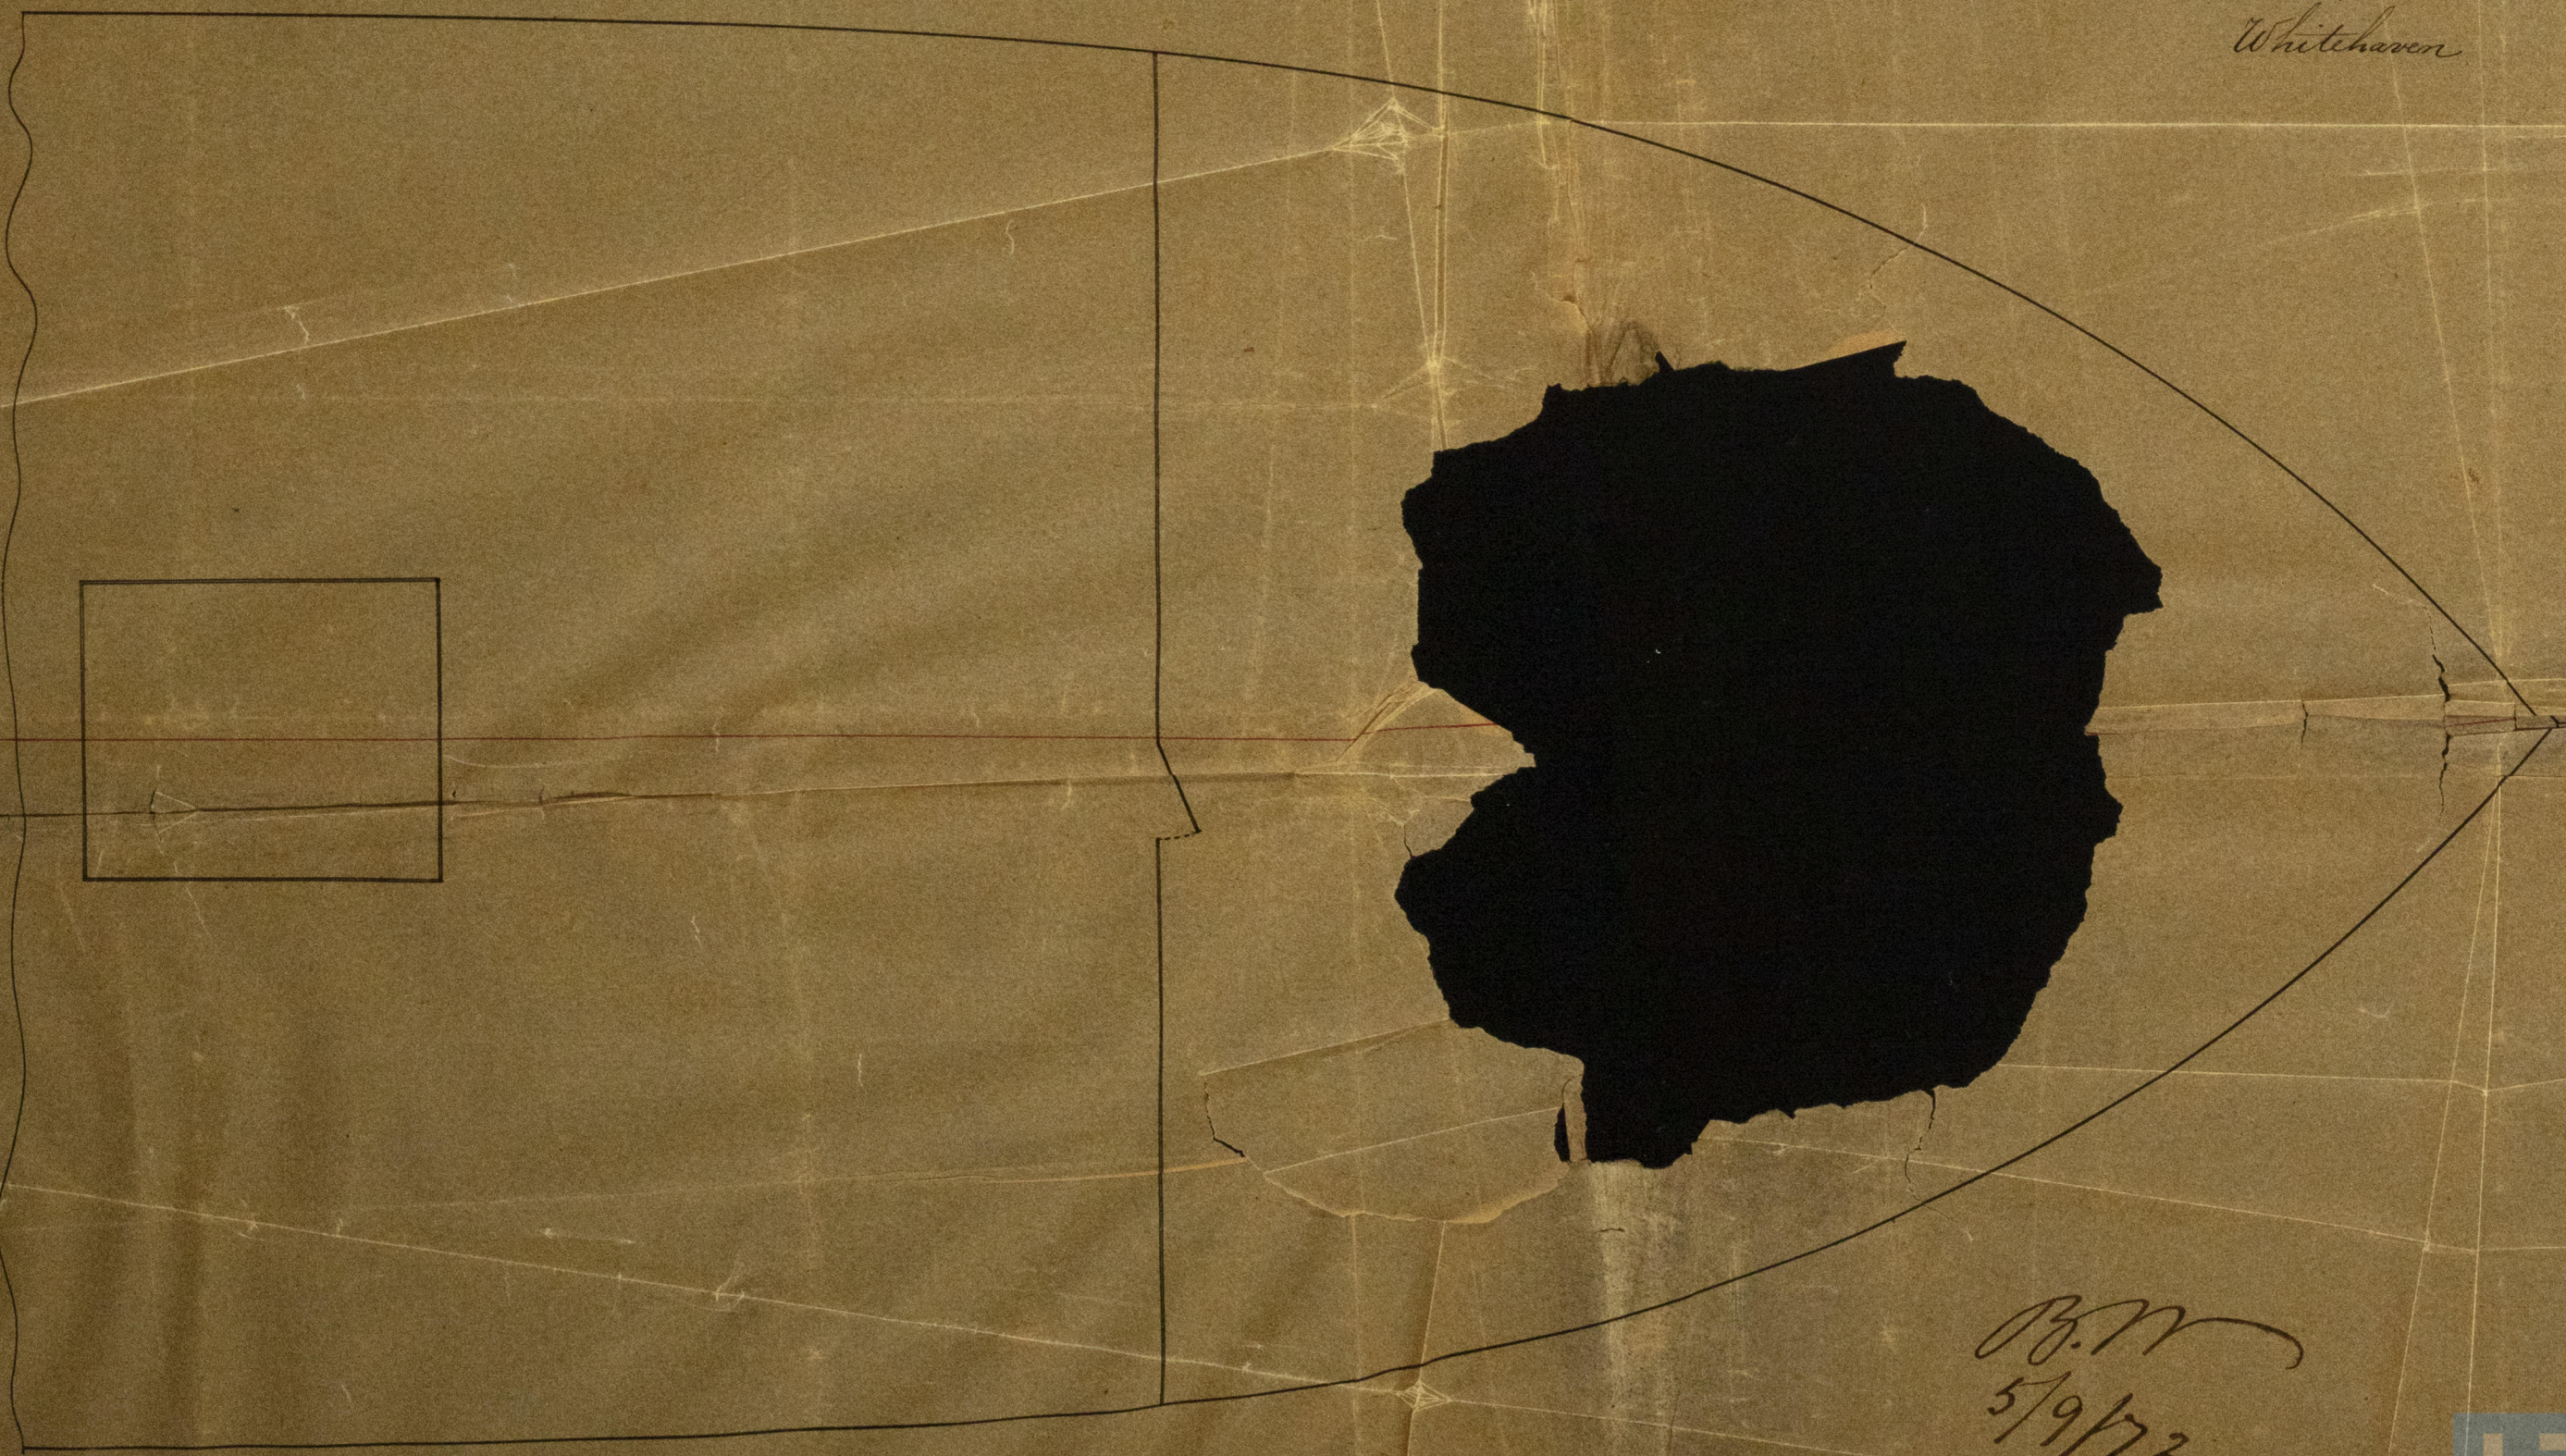

P.B.M.
5/9/72

Letter to Messrs
Whitehaven
29/8/72 and 7.9.72



© 2021

Lloyd's Register
Foundation

IRMS06-0132