


Length of Prop 100.0

Screw Steamer No 4 -

Dimensions
Length 300.0
Breadth 34.0
Depth 23.0

Scale $\frac{1}{2}$ Inch = one Foot -

Rev 25/9/72

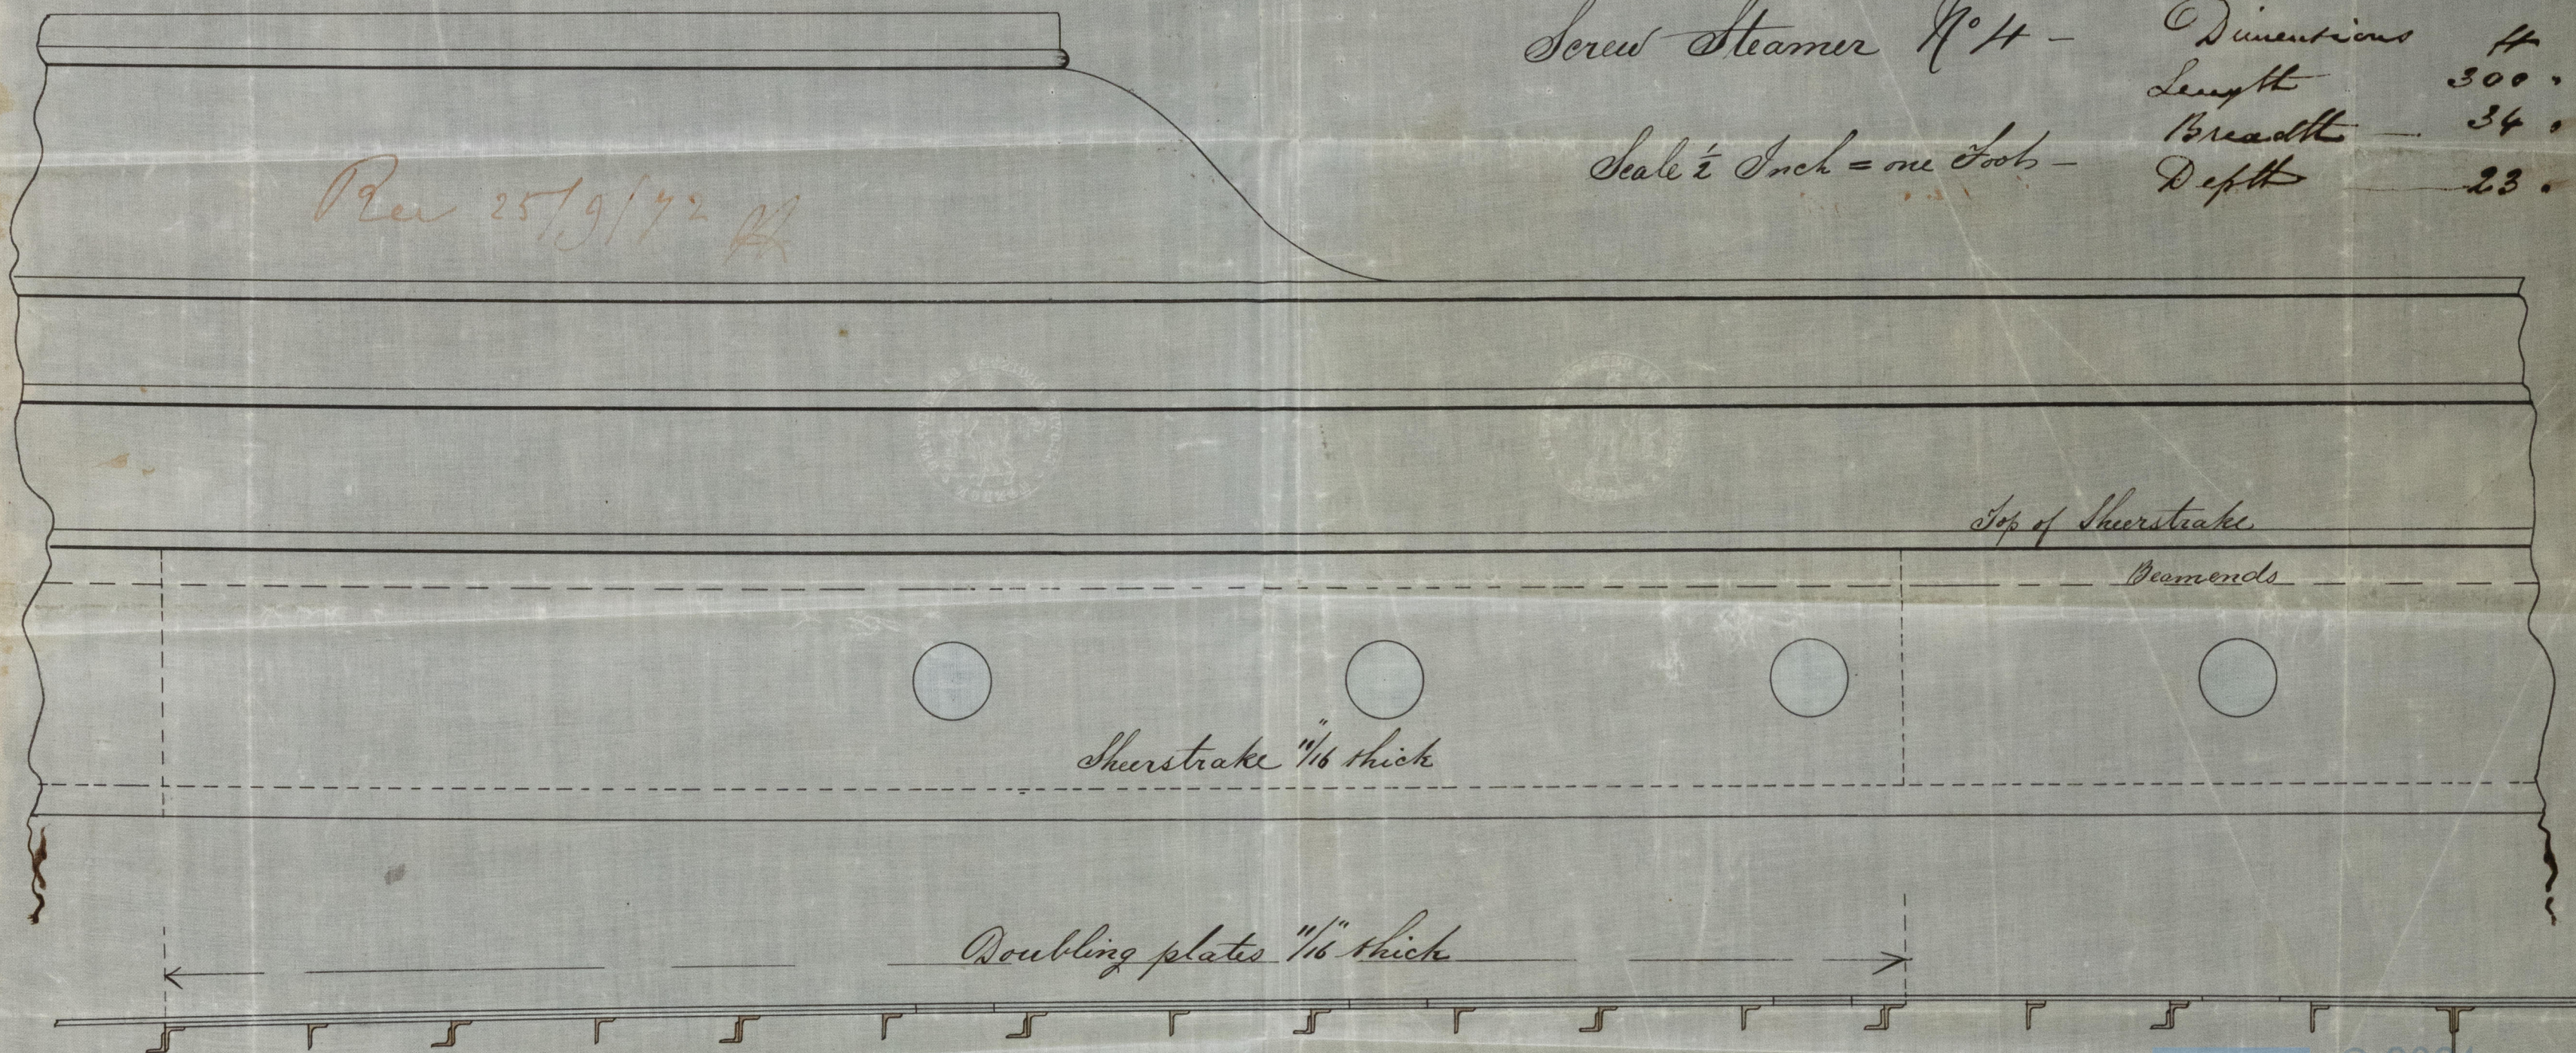

Ed. J. W. M.
25/9/72

The Whitehaven Shipbuilding Co. Limited
Whitehaven
25/9/72
Foundation

IRON 506-6133