


IRON 506

S. L. Memphis
Report No. 3134

— No. 44 S.S. —
— 10-1 foot —
Per 16/4/72 Q 3/6/72
D

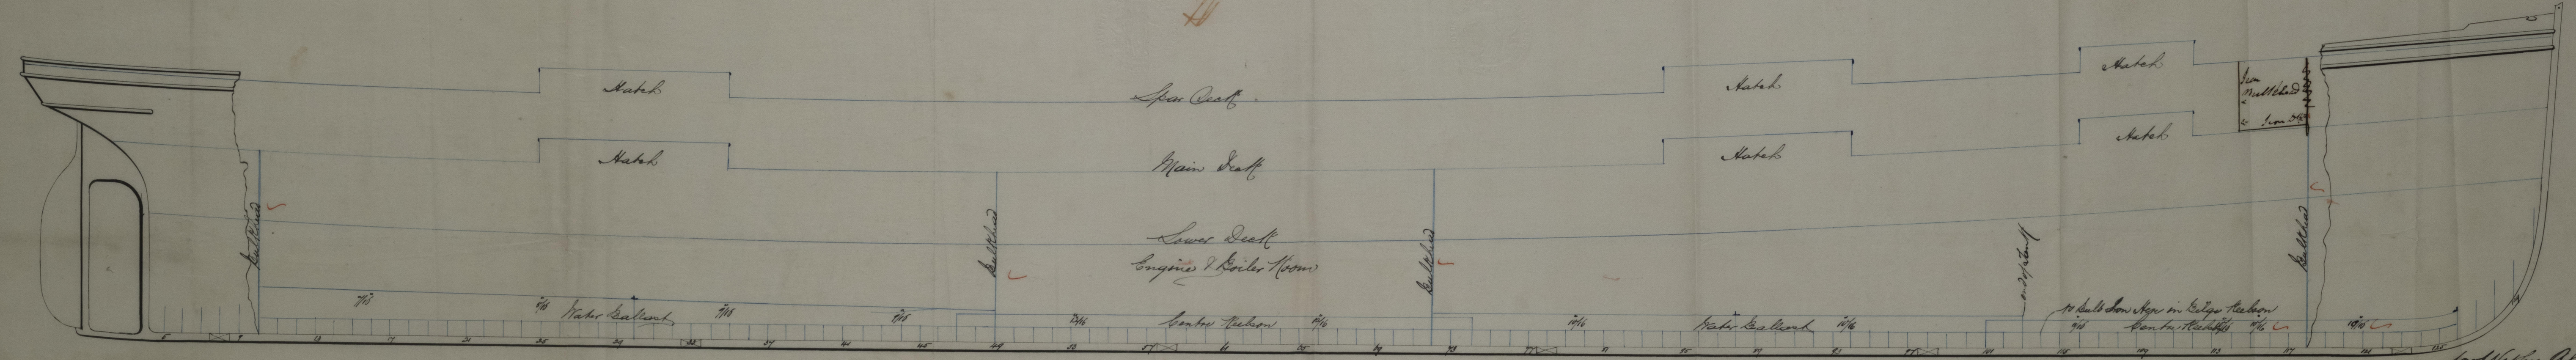

17/4/72
4/6/72

for Wm. Alexander & Co

Iron 11027.

IRON 506-0157

