


N^o 86 Spar Deck. — "Matthew Bay."
Class 90.A.

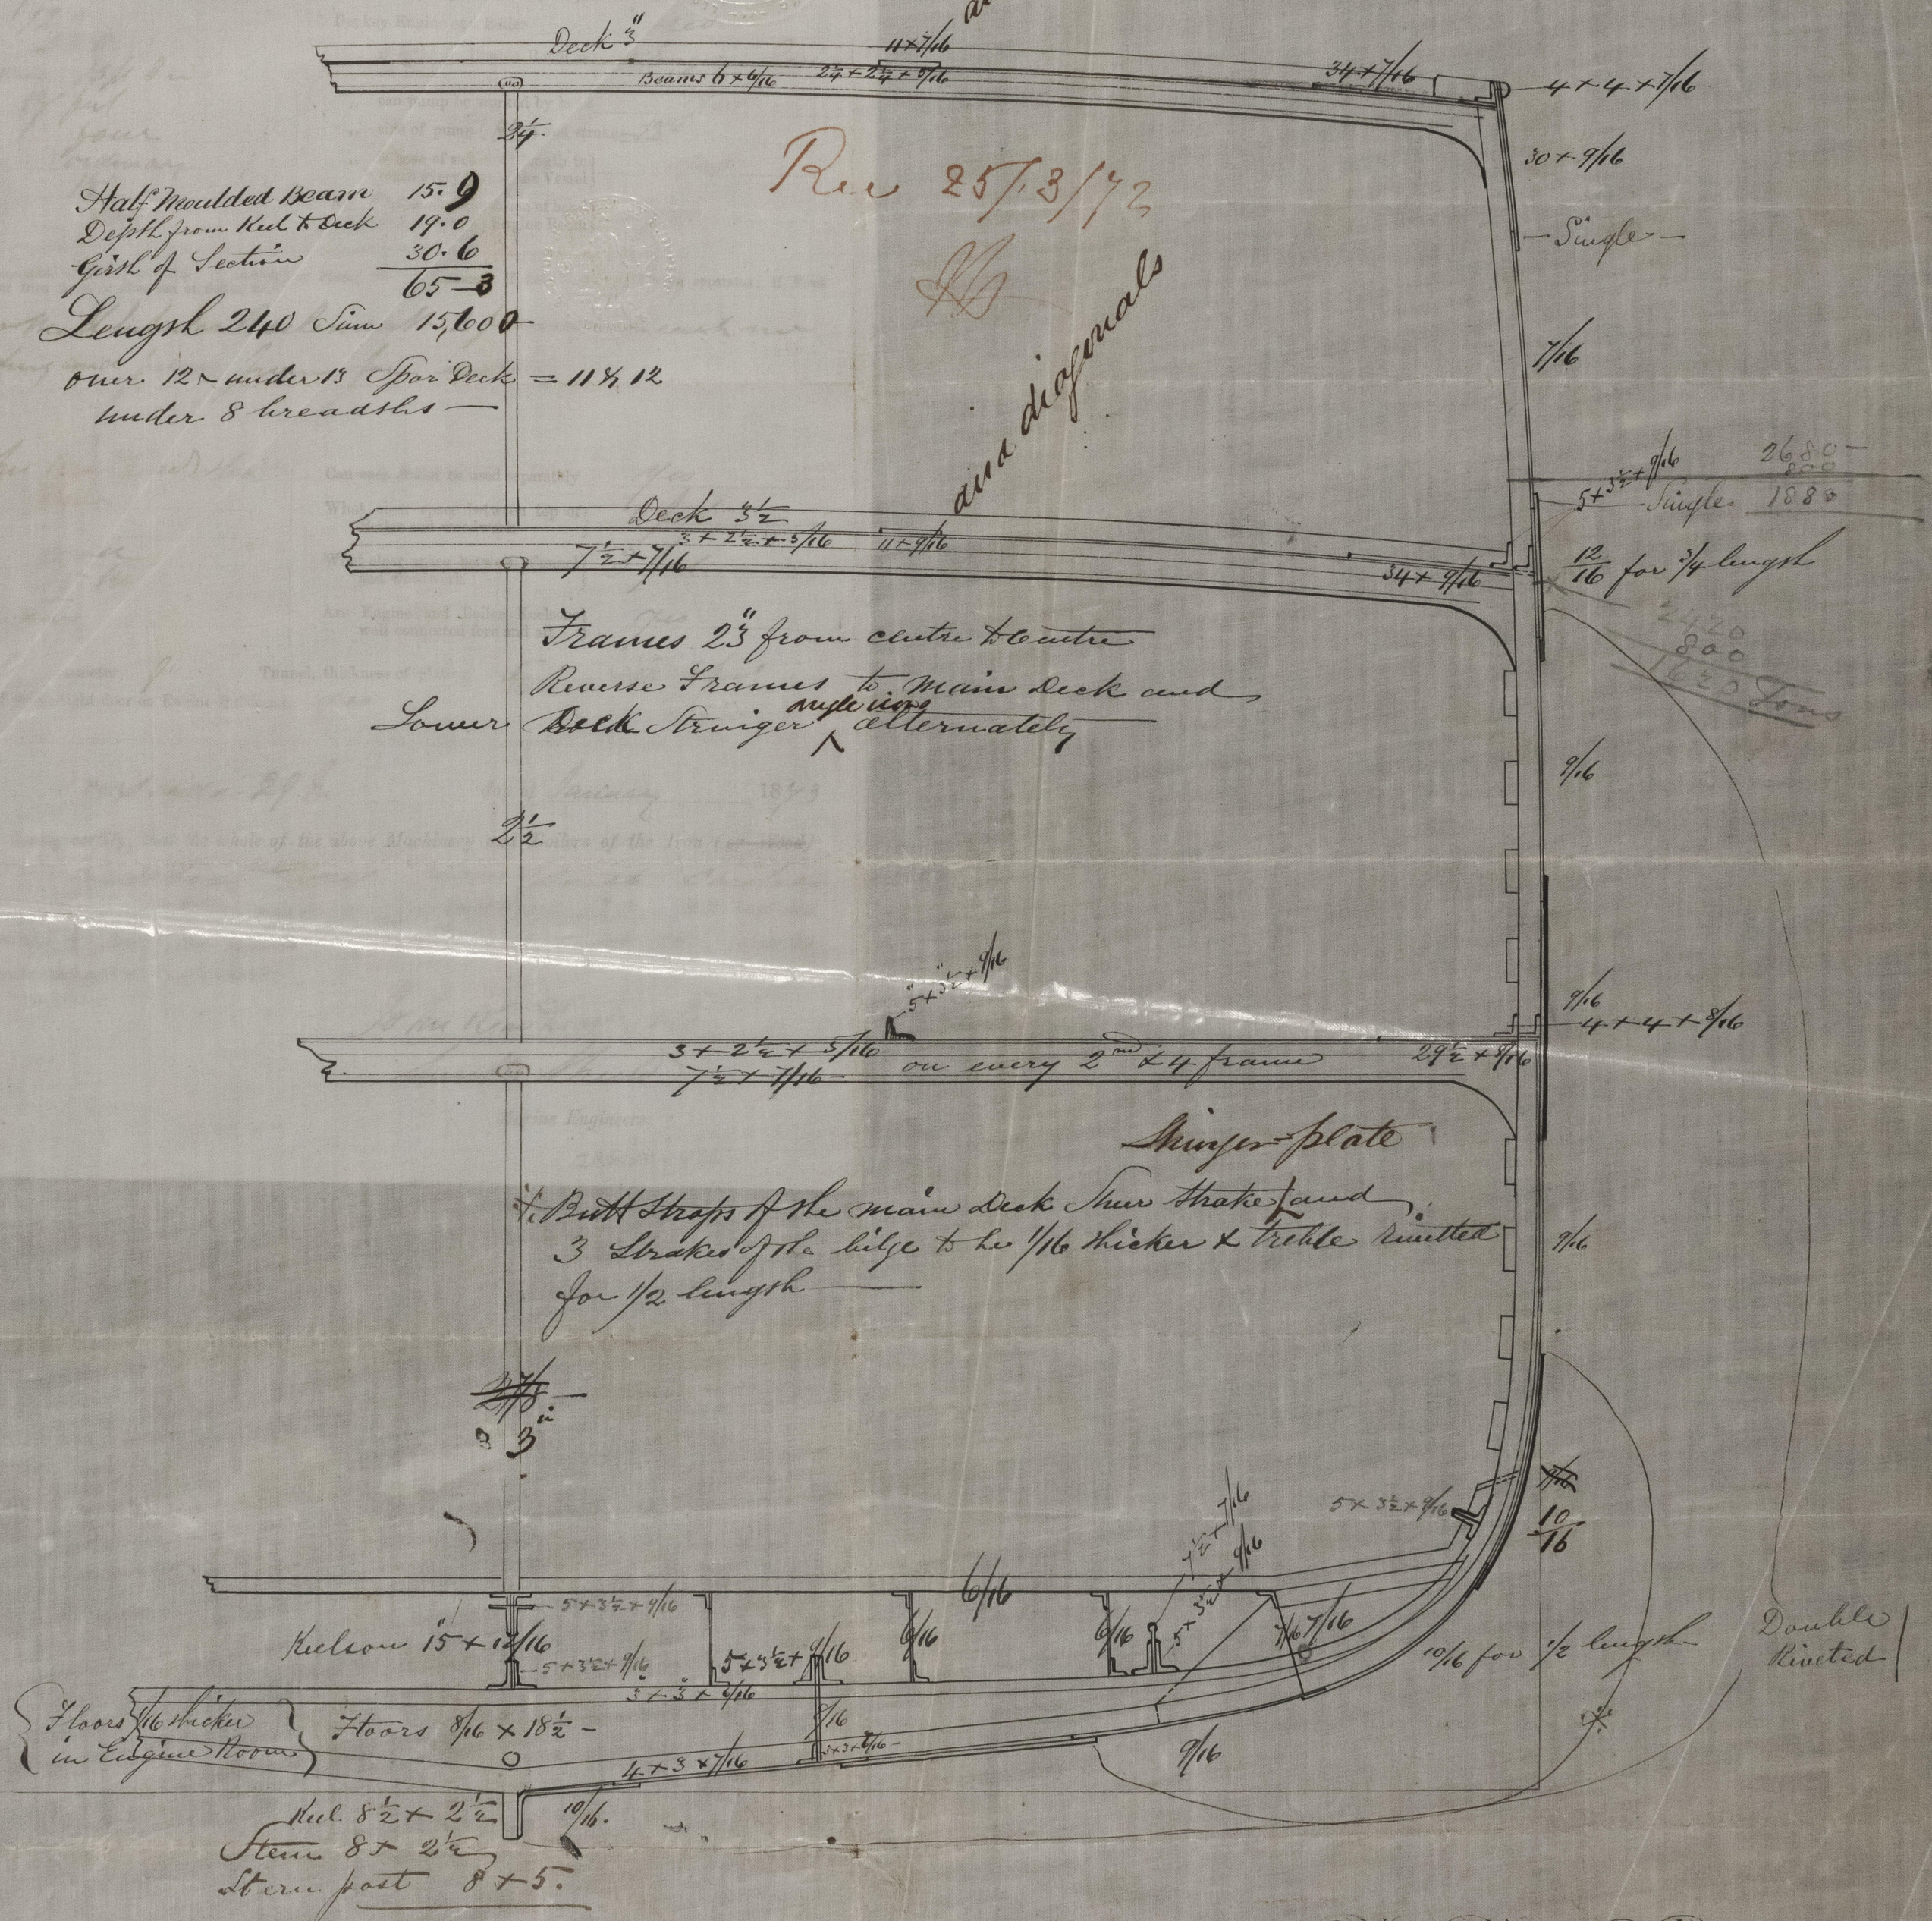

St. J. 26/3/72

John Sibley & Co
THE LANE
IRON SHIP BUILDING YARD,
SOUTH SHIELDS.