

MIDSHIP SECTION OF S.S. Colina
Nº 229 Glasgow No. 3621

100.A 12 1/2. Rules

SCALE $\frac{1}{2}$ INCH TO A FOOT

Dimensions $320 \times 34\frac{1}{2} \times 25.3$

Depth 27.66

Do by Lloyd's 318. 33 x 34. 4 x 25. 3-

Half Beam 17. 20

Proportions Depths to Upper 11.5

Do Girth 39.99


" Main 1579

$$\frac{87}{77.85} = \text{Numeral}$$

Bearns 9.22

$$77.85 \times 318.33 = 24,781 = \text{Numeral}$$

$84.85 \times 319.33 = 27,010 = \text{Numeral for Equipment}$

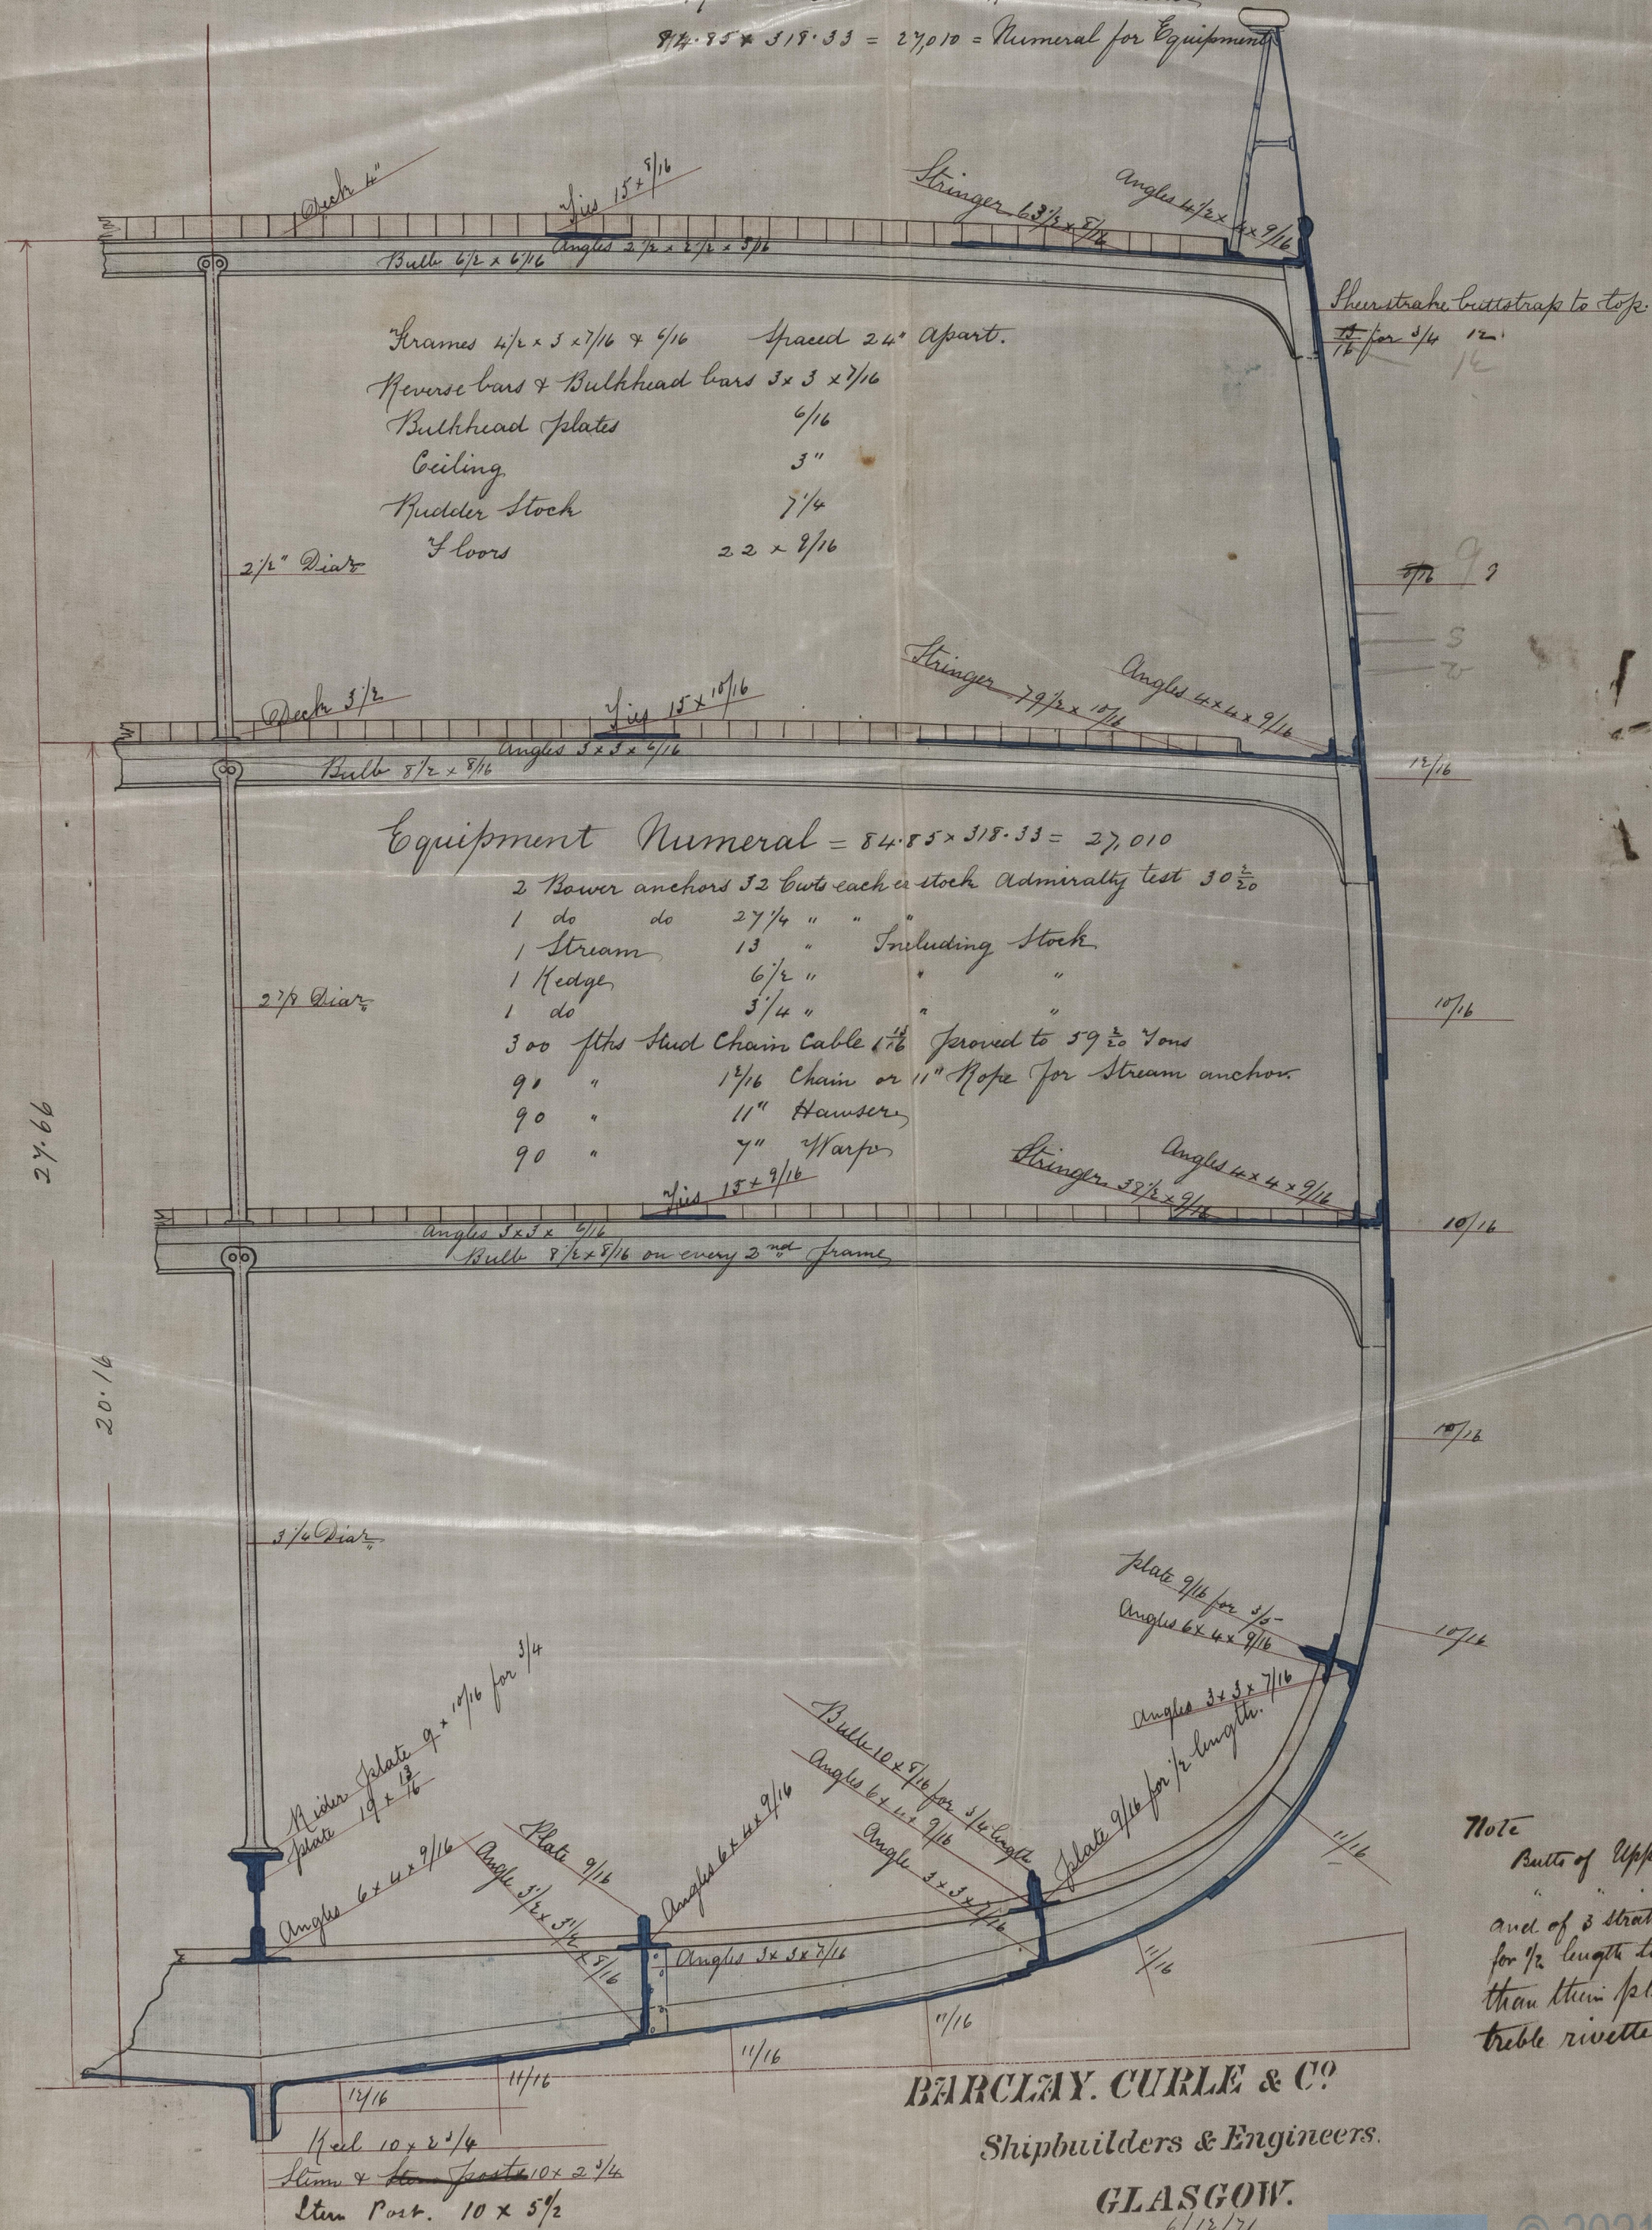

Note
Butts of Upper deck Shrouds
 Stringer do
and of 3 struts at bilge.
for $\frac{1}{2}$ length to be $\frac{1}{16}$ thicker
than thin plates and
treble rivetted.

BARCLAY. CURLE & CO

Shipbuilders & Engineers.

GLASGOW.

6/12/71

W. S. M.
8. 12. 71.