

Numbers for Scantlings

Depth 26.3

$\frac{1}{2}$  Breadth 16" 0

Curth 38.9

less 7 ✓

$$74 \cdot 0 \times 250 = 18500 \text{ m}^2$$

## PRINCIPAL DIMENSIONS

LENGTH OVER ALL ----- 257-0

D<sup>2</sup> BETWEEN PERPENDICULARS 250.0

BREADTH EXTREME ..... 32.0

DEPTH IN HOLD 24.6

TONNAGE O M 1257

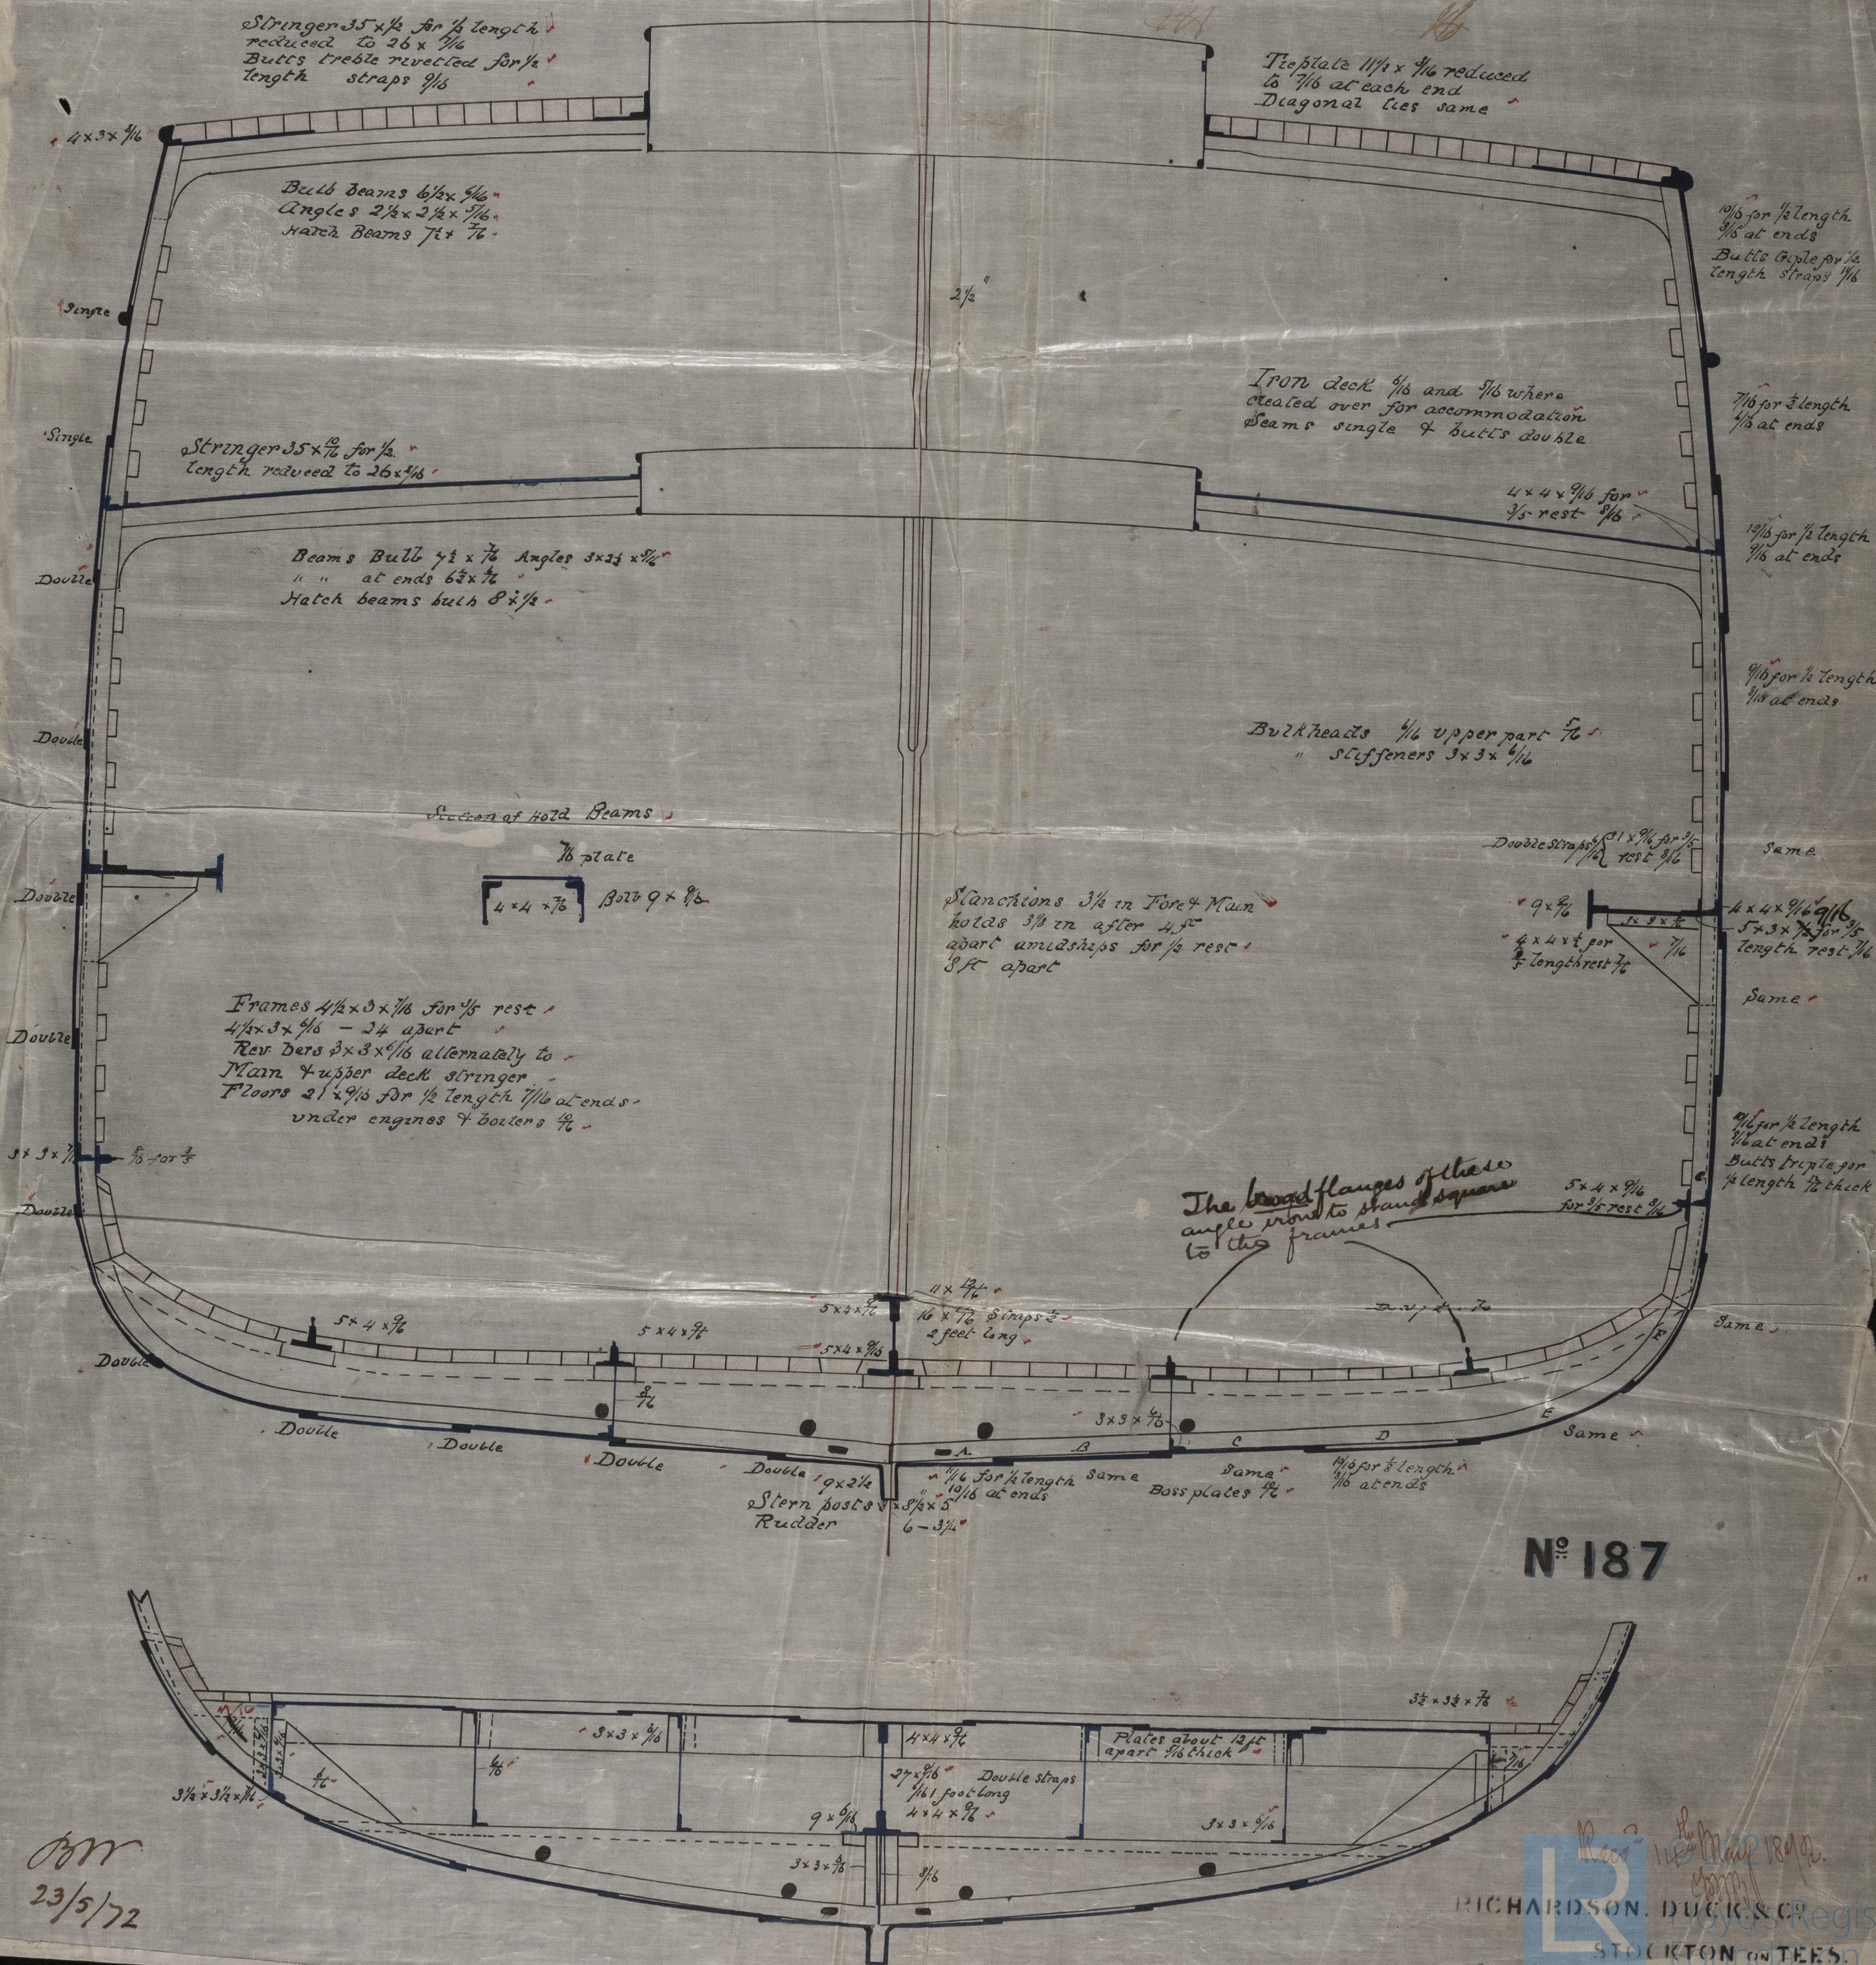
100 A

## Proportions

Breaths 7 and under 8

Depths to Main Deck 14 + under 15

" " Upper do 10 - 11

N<sup>o</sup> 187

RICHARDSON, DUCK & CO

STOCKTON ON TEES.

IRON 506-0197